


H.M.S. "Veronica"


Grk 16896

Midship Section

(as built)

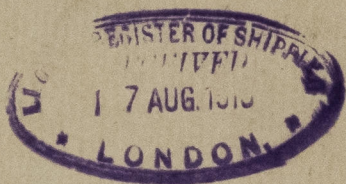

RETAIN

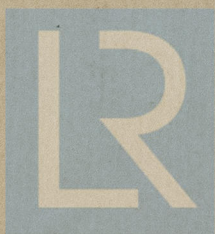

© 2021

Lloyd's Register
Foundation

W1609-0052