

CON	A	B	C	CHECKED BY
644	581	1048	5727	W.P.S.
209	AS PER DRAWING	SIZES		W.P.S.

PART NO.	DESCRIPTION	No. OFF	MATERIAL	REMARKS
11	$\frac{3}{4}$ TAP BOLT	1	M.S.	
10	PIN FOR SPANNER	1	M.S.	
9	SPANNER FOR PROPELLER	1	M.S.	
8	COUPLING BOLTS FOR 1&2	24	M.S.	8 SPARE INCLUDED
7	$\frac{3}{8}$ TAPBOLTS FOR REF 4	2	M.S.	
6	TAIL SHAFT LINER	2	Q.M.	1 SPARE INCLUDED
5	PROPELLER KEY	2	M.S.	1 " "
4	LOCKING PIN	1	M.S.	
3	TAIL SHAFT NUT	2	M.S.	1 SPARE INCLUDED
2	TAIL SHAFT	2	I.S.	1 " "
1	INTERMEDIATE SHAFT	1	I.S.	

Verified copy of plan
approved 3/1/39.

12/1/39

C. No. 209

R

W161-026

DRG. No. 7517

DRAWER No. 1

TYPE 60 LB. 4.

British Liberty

Wm. Duxford & Sons, Ltd.,
Ln. 209.

Details of Shattling
Copy of Appointed Plan.



RETAIN

RETAIN

Furness S.B. Co.

Yard No 287

28

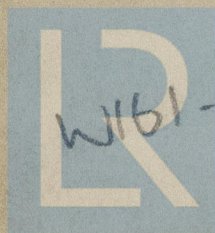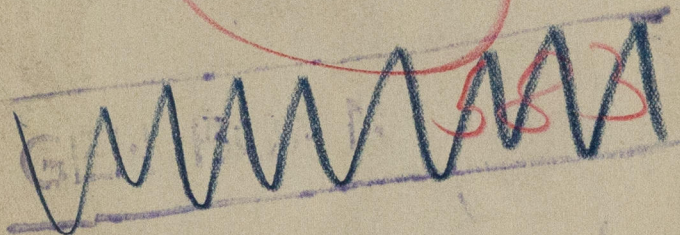

W161-0126

© 2020

Lloyd's Register
Foundation