

MIDSHIP SECTION.

DIMENSIONS - LENGTH 464' 2½ B.P. . 61'-9" BREADTH MLD . 34'-0½ DEPTH MLD TO UPPER D.K.

TO CLASS LLOYDS # 100A1 "CARRYING PETROLEUM IN BULK" WITH
"LONGITUDINAL FRAMING AT BOTTOM & AT DECK."

SCALE. 1/2 INCH = 1 FOOT.

NOTE:-

ALL B.A. SECTIONS ARE NEW BRITISH STANDARD
REVISED JULY 1924.

LLOYDS NUMERALS.

DEPTH "D" = 34.04

L.D. = 15801.

$$L = (B + D) = 44466.$$

L/D = 13.63

EQUIPMENT NUMBER.

$$L = (D + B) = 44465$$
$$\text{Profit} = (18.00 - 8.40 \times \frac{3}{4}) + (28 - 8.08 \times \frac{3}{4}) = 647.$$
$$\text{BRIDGE: } 36.00 \times 8.00 = \frac{3}{4} = 216.$$

FORECAST	$63.96 \times 800 = 3\frac{1}{4}$	=	384
RENT HOUSES	$100.00 \times 800 = 1\frac{1}{2}$	=	400

POOP HOUSE	100.00 - 8.00 - 1/2	=	400.
BRIDGE HOUSE	37.00 - 8.00 - 1/2	=	148.

BRIDGE HOUSE 31.00 - 8.00 - 1/2	=	148
FLYING BRIDGE HOUSE 33.50 - 7.50 - 1/2	=	125

TOTAL = 46386.

EQUIPMENT.


1 BOWER ANCHOR. (STOCKLESS) WEIGHING. 89 3/8 CENTS

1 STREAM ANCHOR (EX STOCK) " 23 1/2 "

300 FATHOMS OF 2 1/2" STUD CHAIN CABLE.

120.	-	-	4 3/4	(6.24)	STEEL WIRE STRAIN
130.	-	-	5 1/2	(6.24)	TOWLINE.

4 @ 100 " " 8" MANILLA HAWSERS & WARPS.

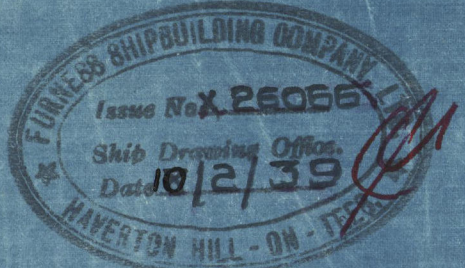

Messrs. Furness Shipbuilding Co. Ltd.

Yard No. 287

Plan of midship section as built

m.v. "BRITISH LIBERTY"


MOD. RPL. NO. 16536

RETAIN

RETAIN

W161-0127

© 2020

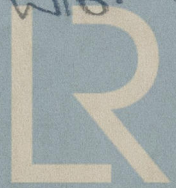

Lloyd's Register
Foundation