

DIM^{NS} 128'0" x 22'0" x 13'10" DEPTH MOULDED
SCALE 1/2" = 1 FOOT


TO BE CLASSED 100 A.1. AT LLOYDS FOR FISHING PURPOSES.
ENGINE & BOILER CASING AS PREVIOUSLY APPROVED
DECK PLATED IN WAY OF ENGINE & BOILER SPACE

$\frac{1}{2}$ GIRTH	20.95'
$\frac{1}{2}$ BREADTH	10.95'
DEPTH	14.29'
	46.19.1 ST NO
	26.87' LENGTH AS PER RULE
	58601153 ⁰ 2 ND NO

<u>DTOL</u>	<u>8.8</u>
<u>DTOL</u>	<u>5.7</u>

✓ 1 ST BOWER	5 ⁹ / ₄ CWTs EX STOCK. IF STOCKLESS 7 ¹ / ₄ CWTs
✓ 2 ND BOWER	5 ¹ / ₄ CWTs EX STOCK
✓ 3 RD BOWER	3 CWTs EX STOCK
✓ 105 FATHOMS	1 ¹ / ₄ CABLE
✓ 60 "	6 HAWSER
✓ 60 "	5 WARP

GOCHRANE & SONS
SHIPBUILDERS
SELBY
YORKS

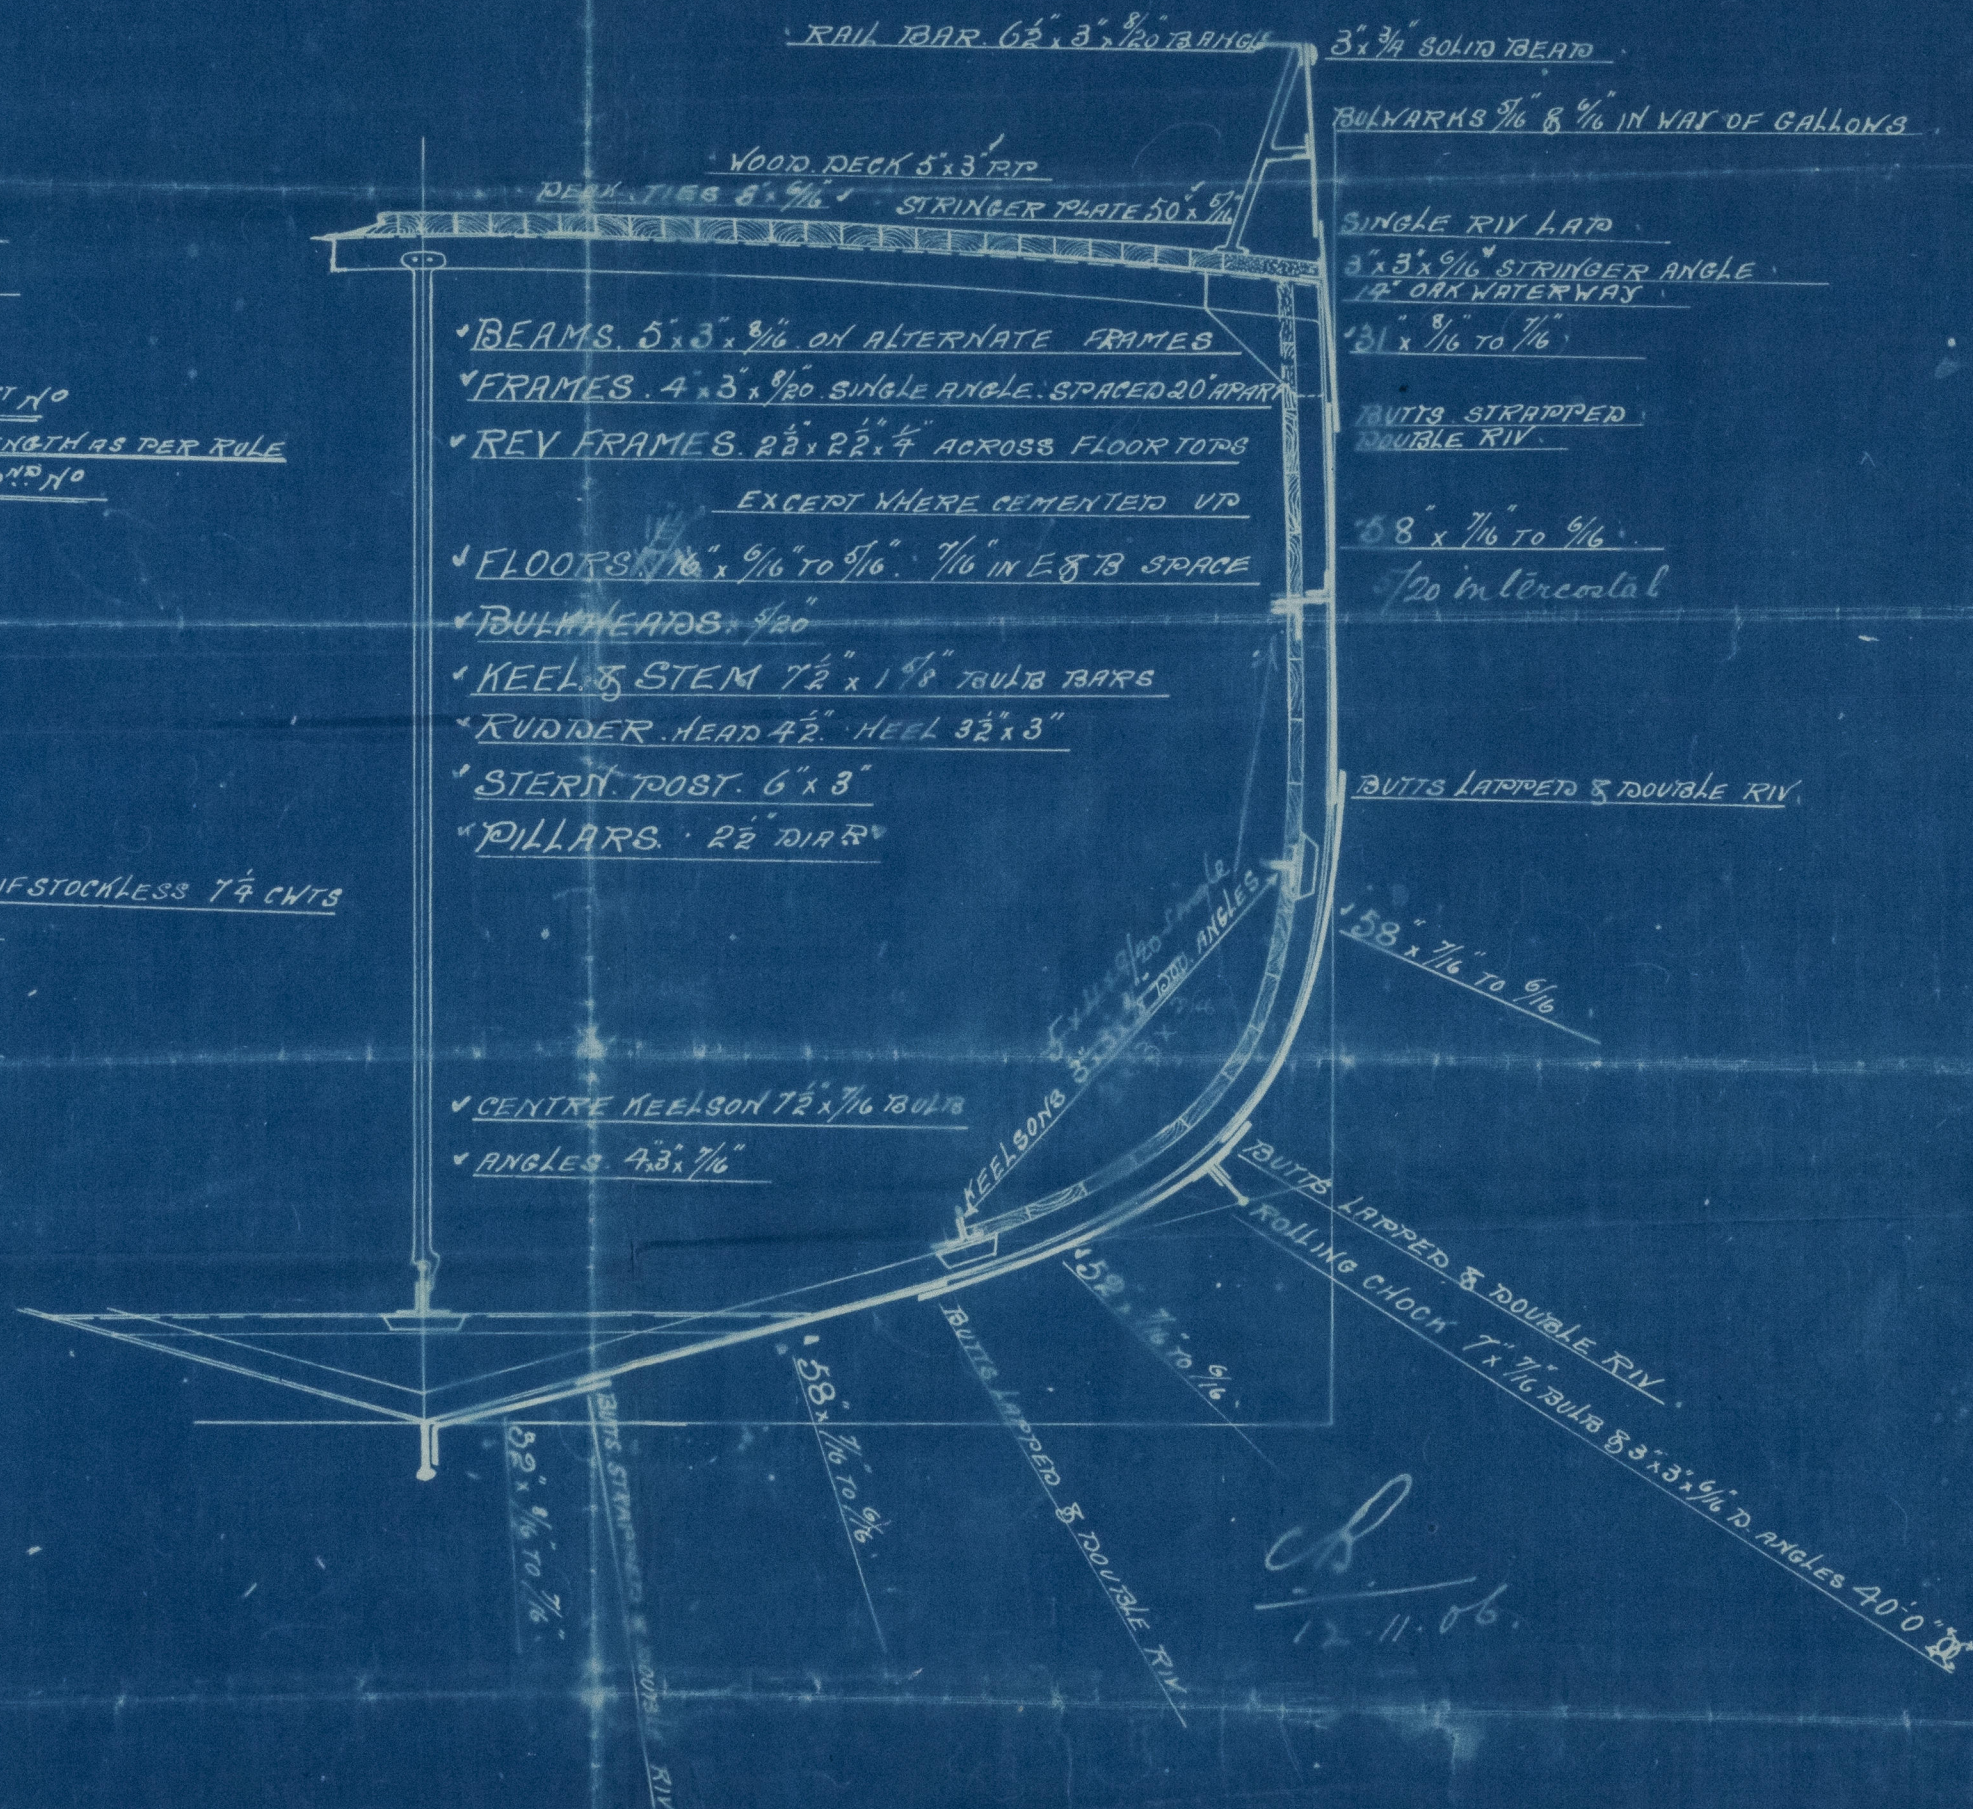


U.S. 303.304-302-
march 1944

№ 303.304.302

3d3 + 2

- Midship Sections -
Cochrane & Sons
394
s/s "Victoria"
Hull Report No. 18991

RETAIN

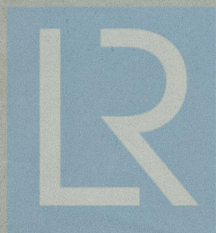

© 2021

Lloyd's Register
Foundation

W1611-0152