


S.S. N° 398.
MIDSHIP SECTION.

DIMENSIONS 86'-0" x 18'-6" x 9'-6" M.L.D.

SCALE $\frac{1}{2}'' = 1 \text{ FOOT.}$

TO CLASS 100-A.I. FOR FISHING PURPOSES.

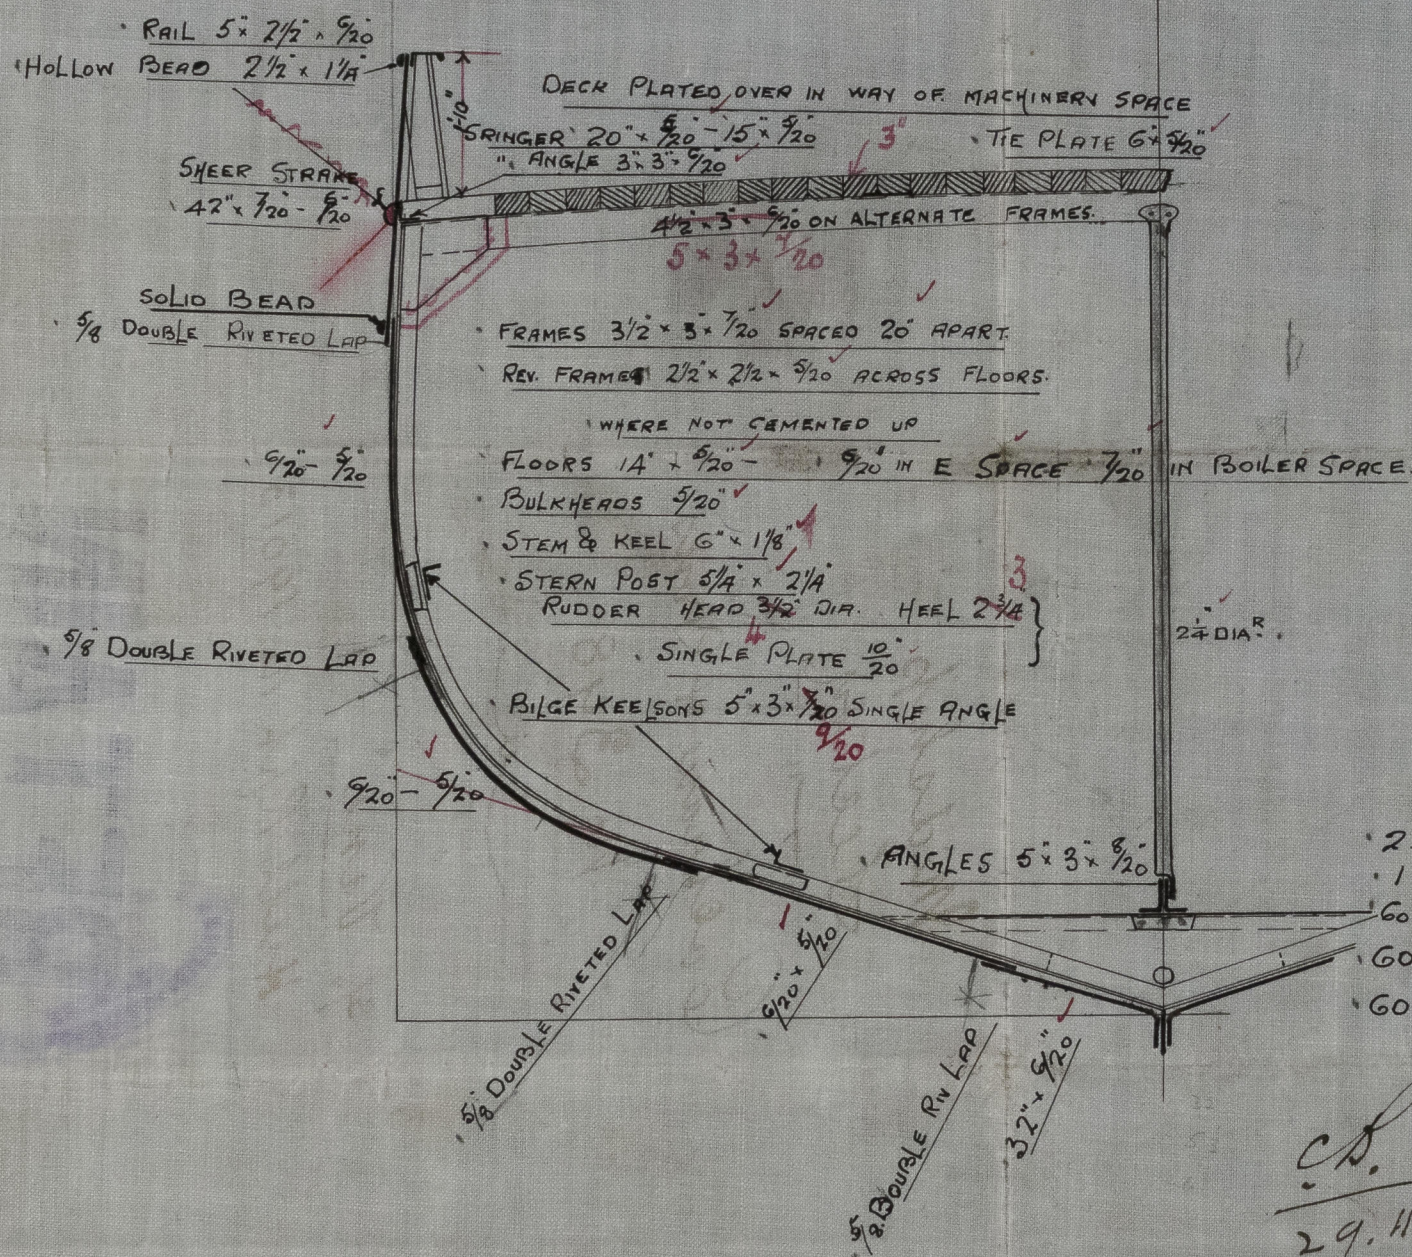

— NUMERALS —

$\frac{1}{2} B. \quad 9.23$

15.45

D 9.87

1ST No 34.55 ✓

RULE LENGTH 85.06

2^{no} N^o ~~2956-98.~~

PROPORTIONS

$$\frac{L}{D} = 8.63$$
$$\frac{L}{B} = 4.62$$

EQUIPMENT.


2. BOWER ANCHORS 3 1/2 CWTs EACH EX STOCK

1 2

$\frac{1}{2}$ 60 FATHOMS $\frac{13}{16}$ CHAIN CABLE

GO " 5 1/2" HAWSER.

GO " 3" WARP

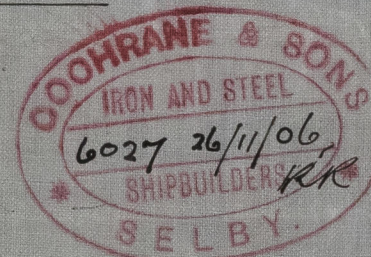

С.В.
29.11.06.

Midship
Section

Cochrane & Sons
No 398

$\frac{3}{4}$ Vine

Hull Rpt No. 19013

RETAIN



Lloyd's Register
Foundation

W4811-0246