

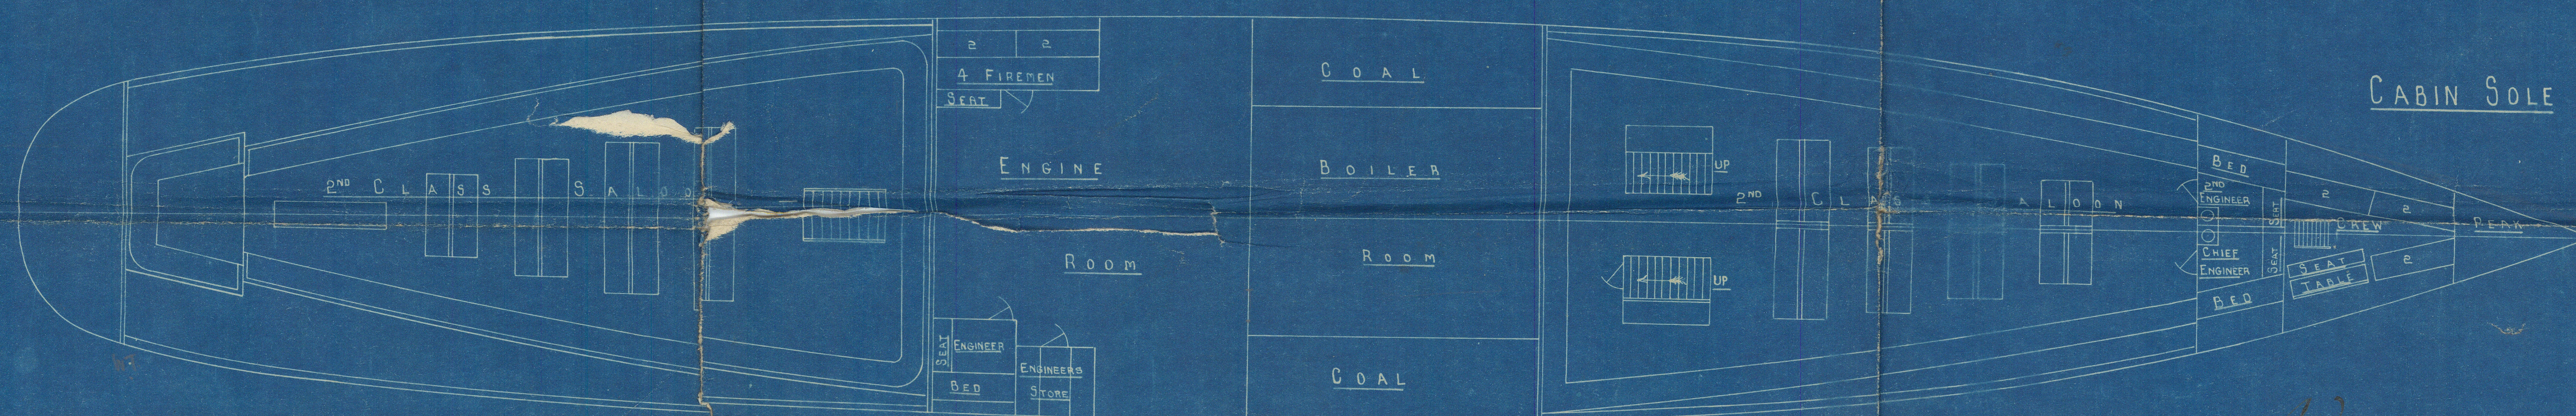
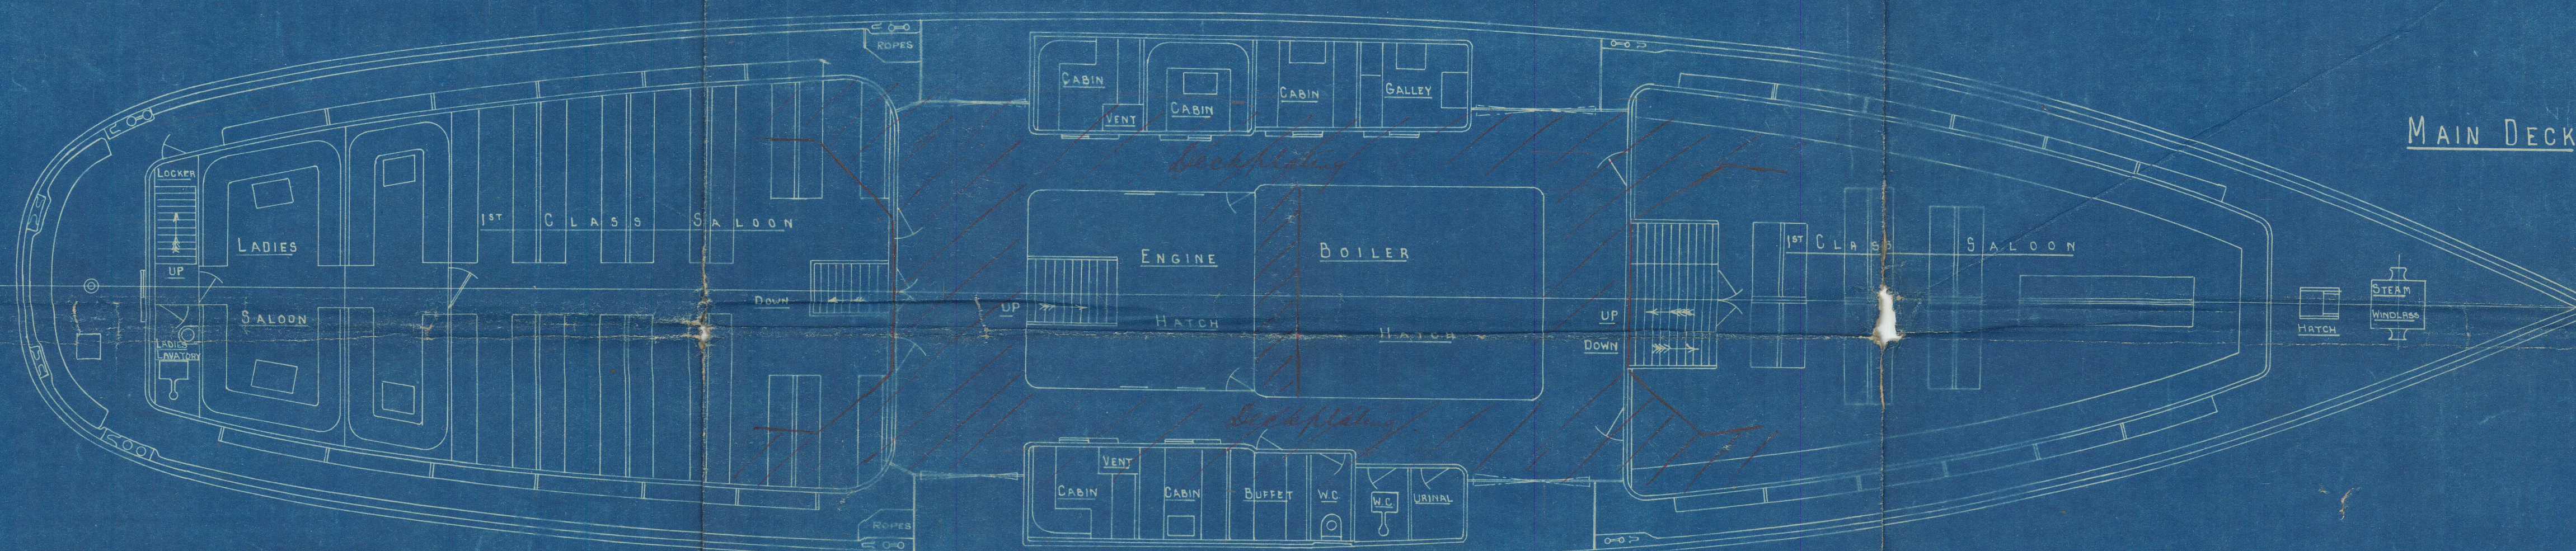


# TWIN SCREW PASSENGER STEAMER

196'-0" x 28'-0" x 11'-3"

SCALE 1/8" = 1 FOOT

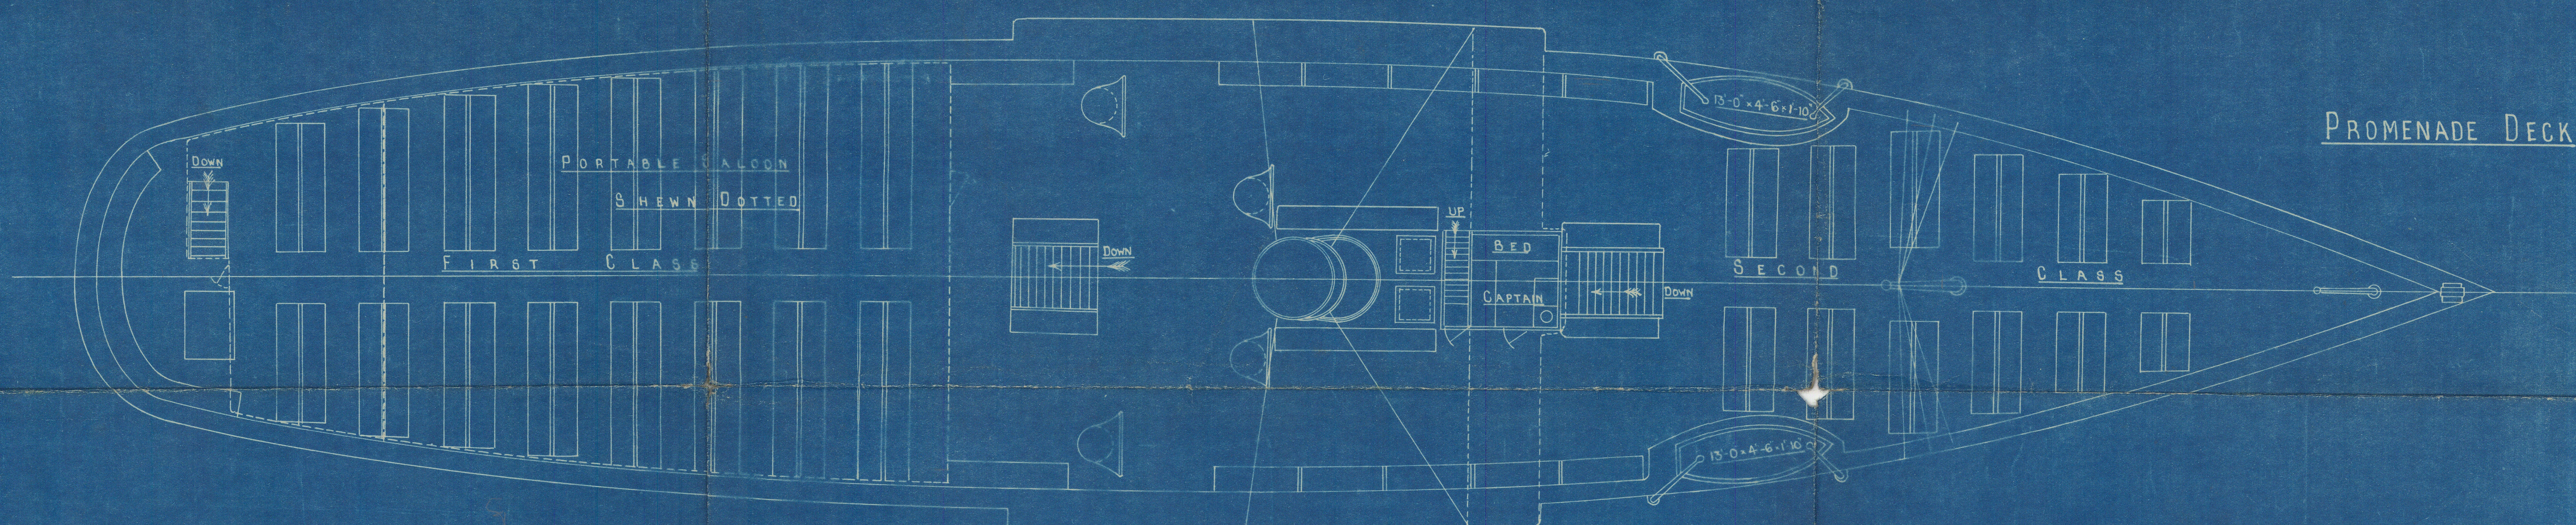

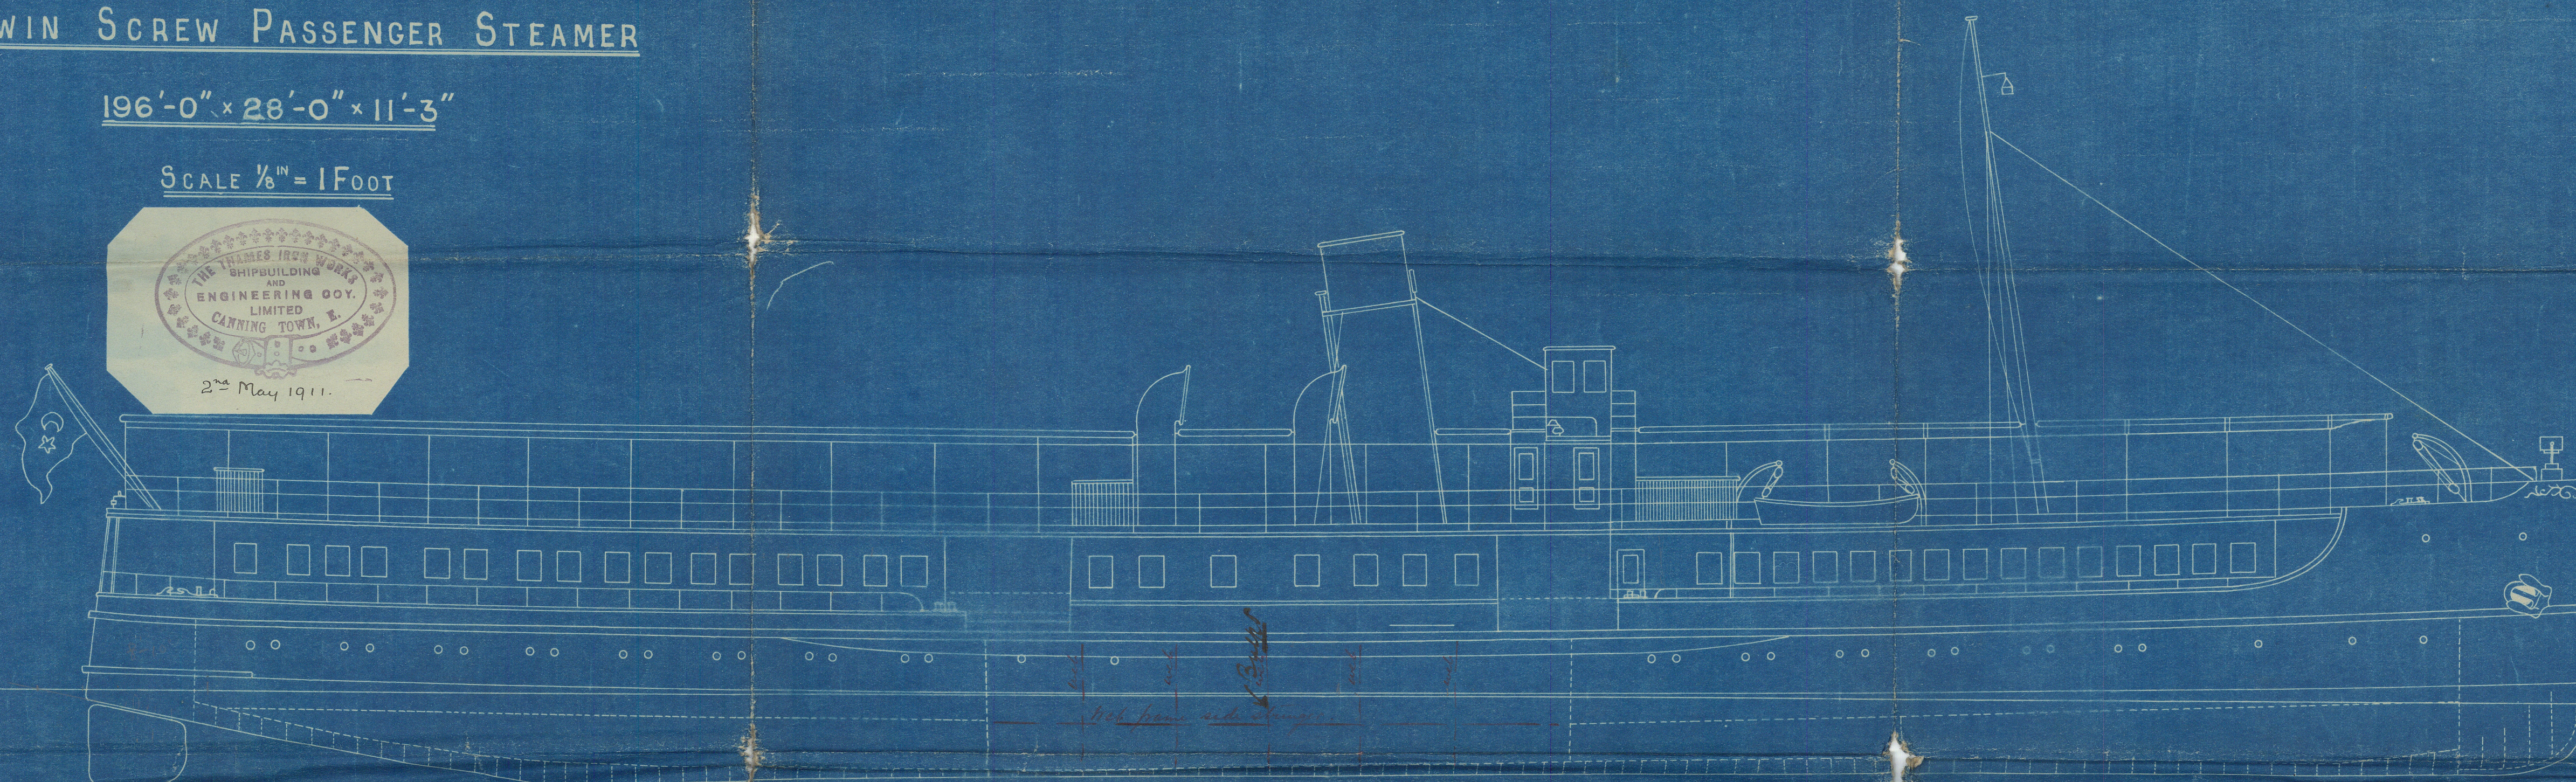

Stuyak ada

for 77202

P/D

RETAIN




© 2021

Lloyd's Register  
Foundation

W1614-0090




L. 80. A, B, & C.

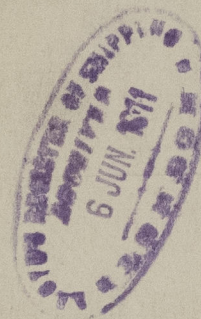

© 2021

Lloyd's Register  
Foundation



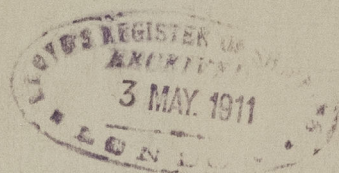

© 2021

Lloyd's Register  
Foundation