





POOP DECK

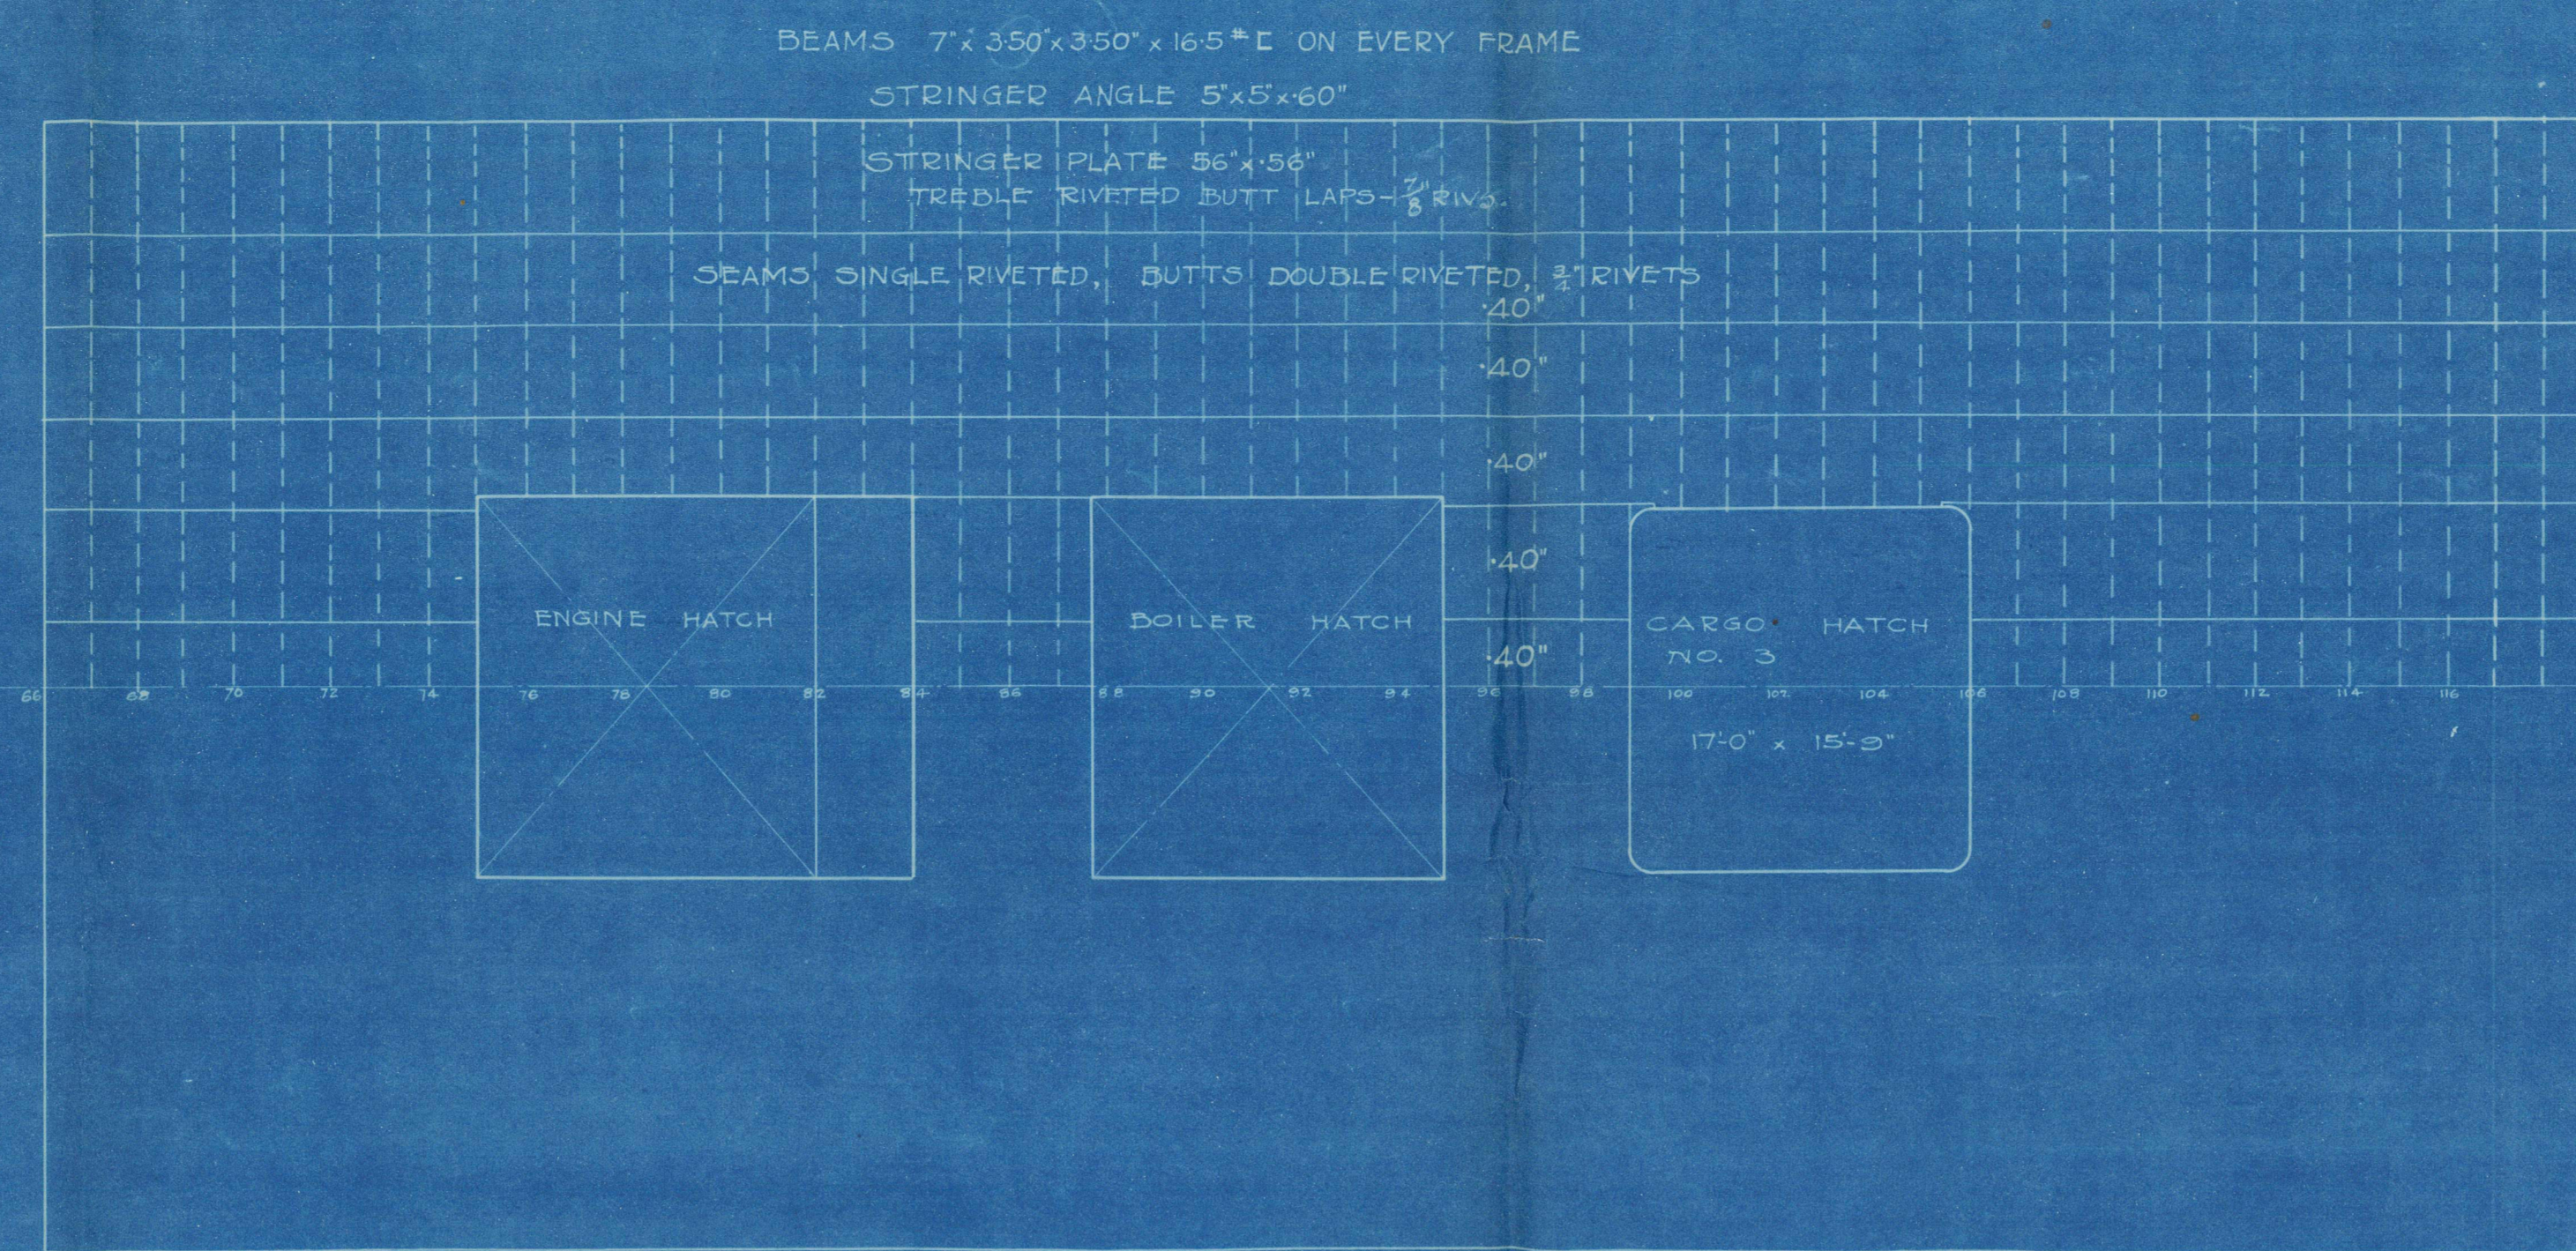

BRIDGE DECK

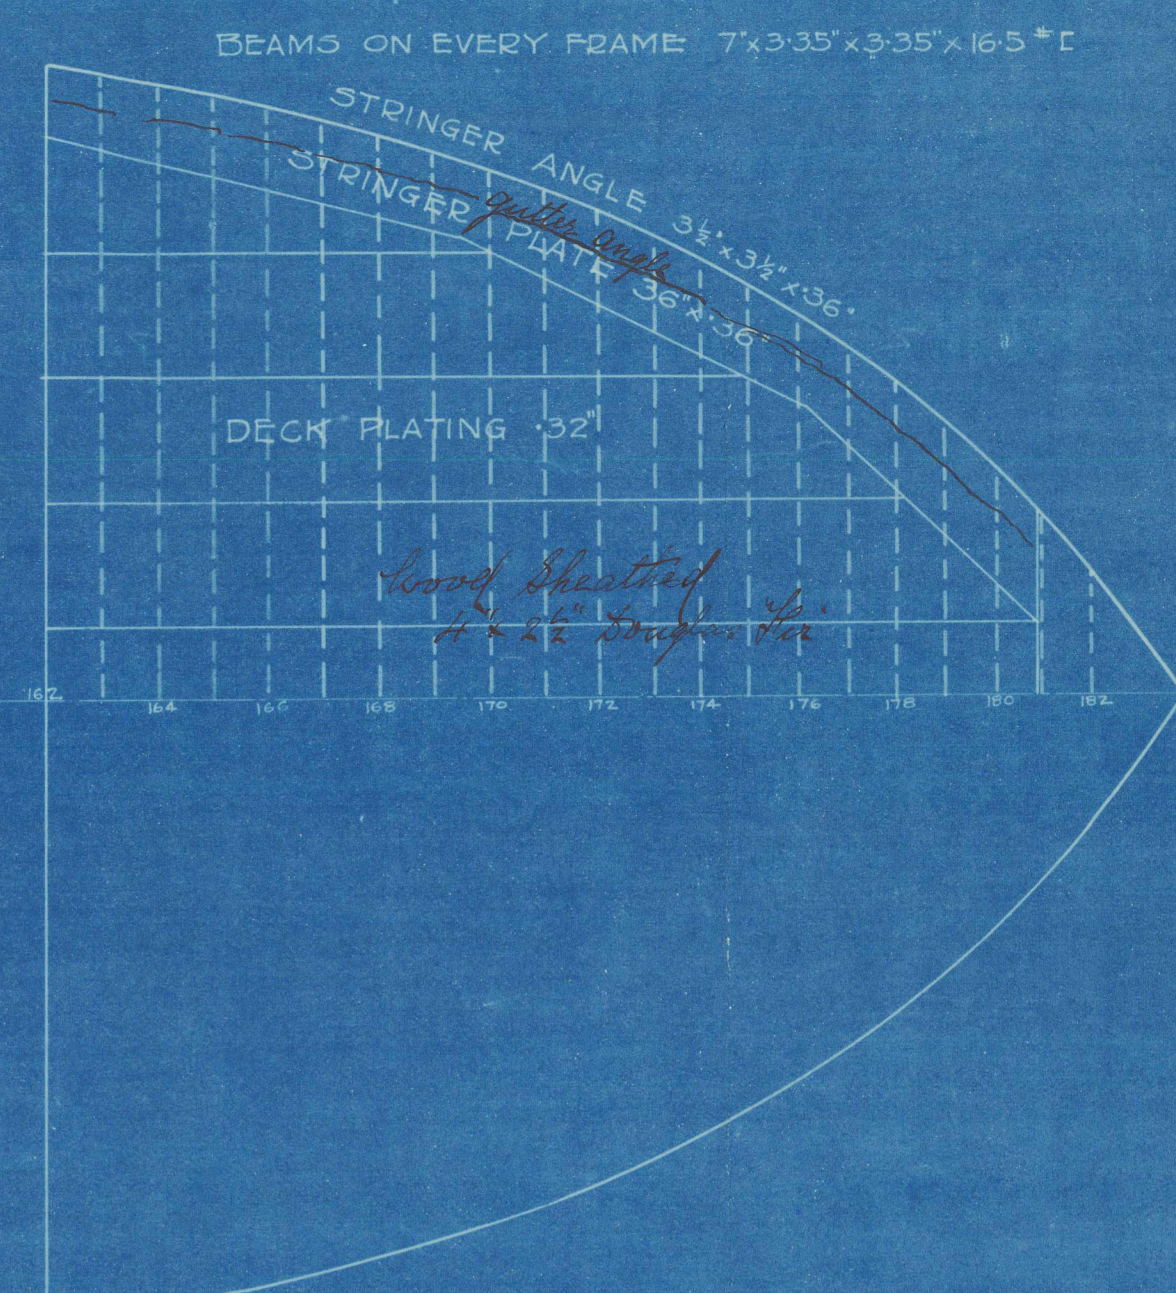

FORECASTLE DECK

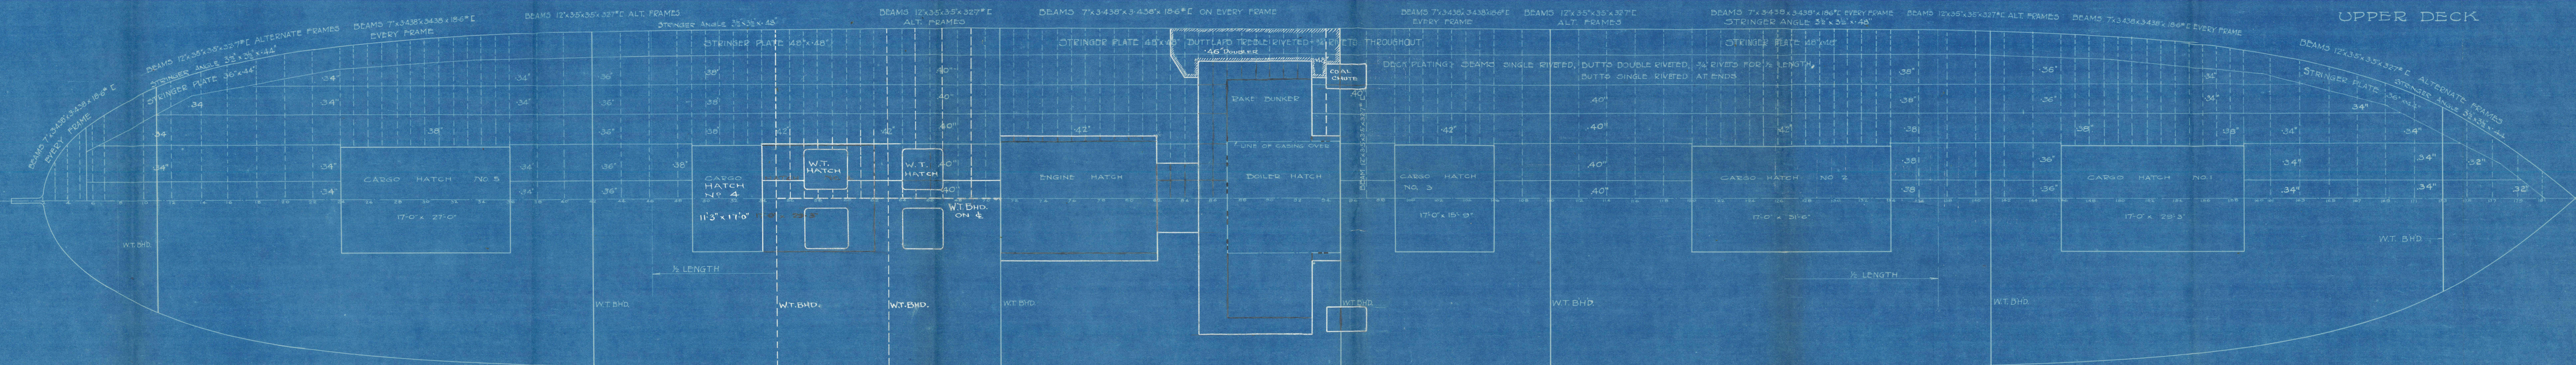 

UPPER DECK

SECOND DECK

ALTERATIONS	
NO. 1	NO. 2
NO. 3	NO. 4
NO. 5	NO. 6

BLUE PRINTS	
NO. 1	NO. 2
NO. 3	NO. 4
NO. 5	NO. 6

Vessel No. 12  
 AMES SHIPBUILDING & ENGINE CO.  
 SEATTLE, WASH.  
 LLOYDS DECK PLATING  
 11-12-1917  

Ames SB & Dry Dock Co  
Vessel No 12 "Western Knight"  
Deck plan

Sea 828.



RETAIN

W1615-0173



© 2021

Lloyd's Register  
Foundation