

AMENDED PROFILE. N° 235

SCALE $\frac{1}{8}$ = ONE FOOT.

DIMENSIONS.

LENGTH B.P. 270' 0"
BREADTH EXT. 39' 6"
DEPTH MLD. 20' 0"


TO CLASS 100.A.1. LLOYD'S

JOHN PRIESTMAN KC.

SHIPBUILDERS.
SUNDERLAND.



30.5.11
13.7.11

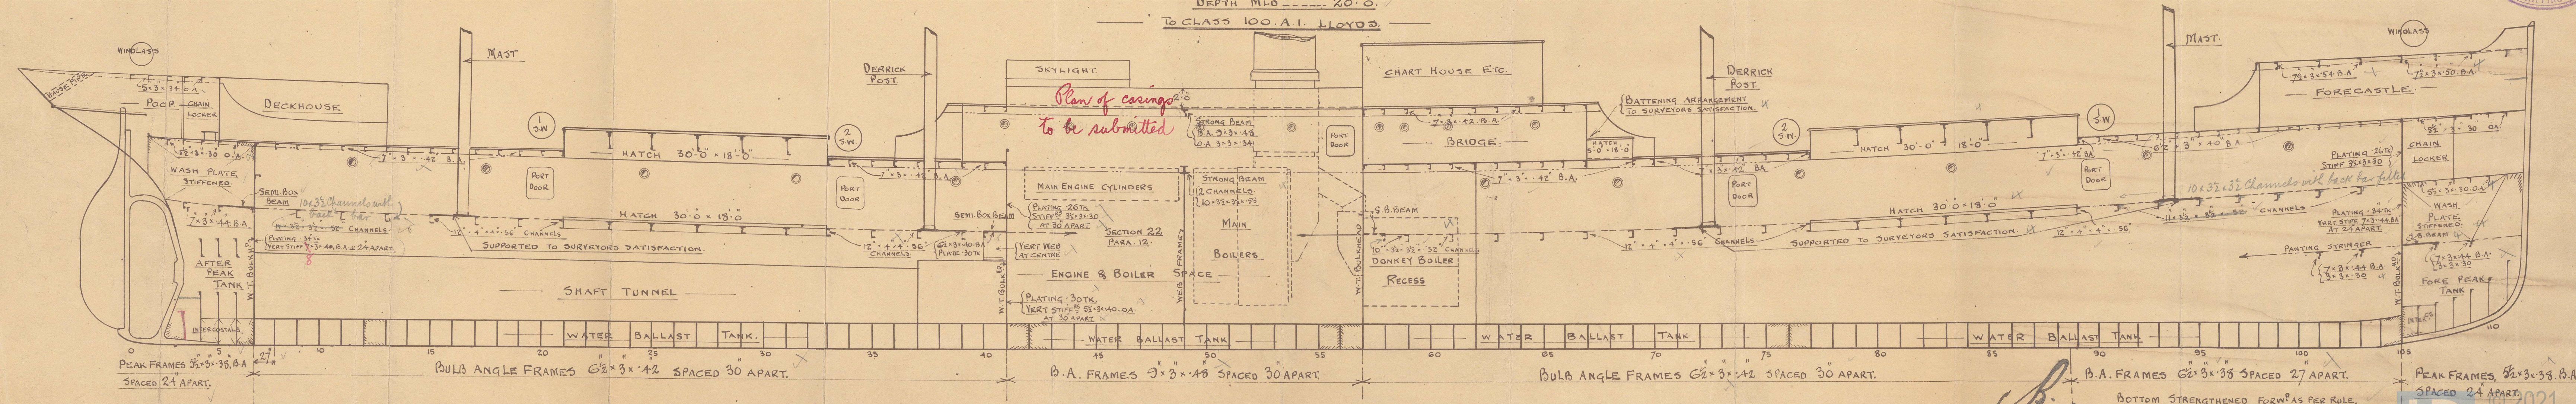

C.B.
30.5.11




J. Priestman & Co.

Amended

Profile

S.S. No. 235

% Yi Loong

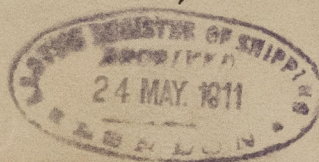

Sld. Rpt. 25136



RETAIN



© 2021

Lloyd's Register
Foundation