


30.5.11
13.7.11

DIMENSIONS.

TO CLASS 100. A.I. LLOYDS.

FORECASTLE SCANTLINGS

BEAMS, $7\frac{1}{2}" \times 3" \times .54' @ 27' \text{ APART}$ } 2 Rows ALT. FRAMES
 $7\frac{1}{2}" \times 3" \times .50' \times 24' \times$
 STRINGER PLATE $26' \times 32'$, TIE PLATES. $8' \times 32'$, WOOD D $3' \times 1\frac{1}{2}"$
 STRINGER ANGLES, $3' \times 3' \times 32'$, SIDE PLATING $\cdot 34' \text{ TK.}$
 PILLARS $2\frac{1}{2}" \text{ DIAM.}$

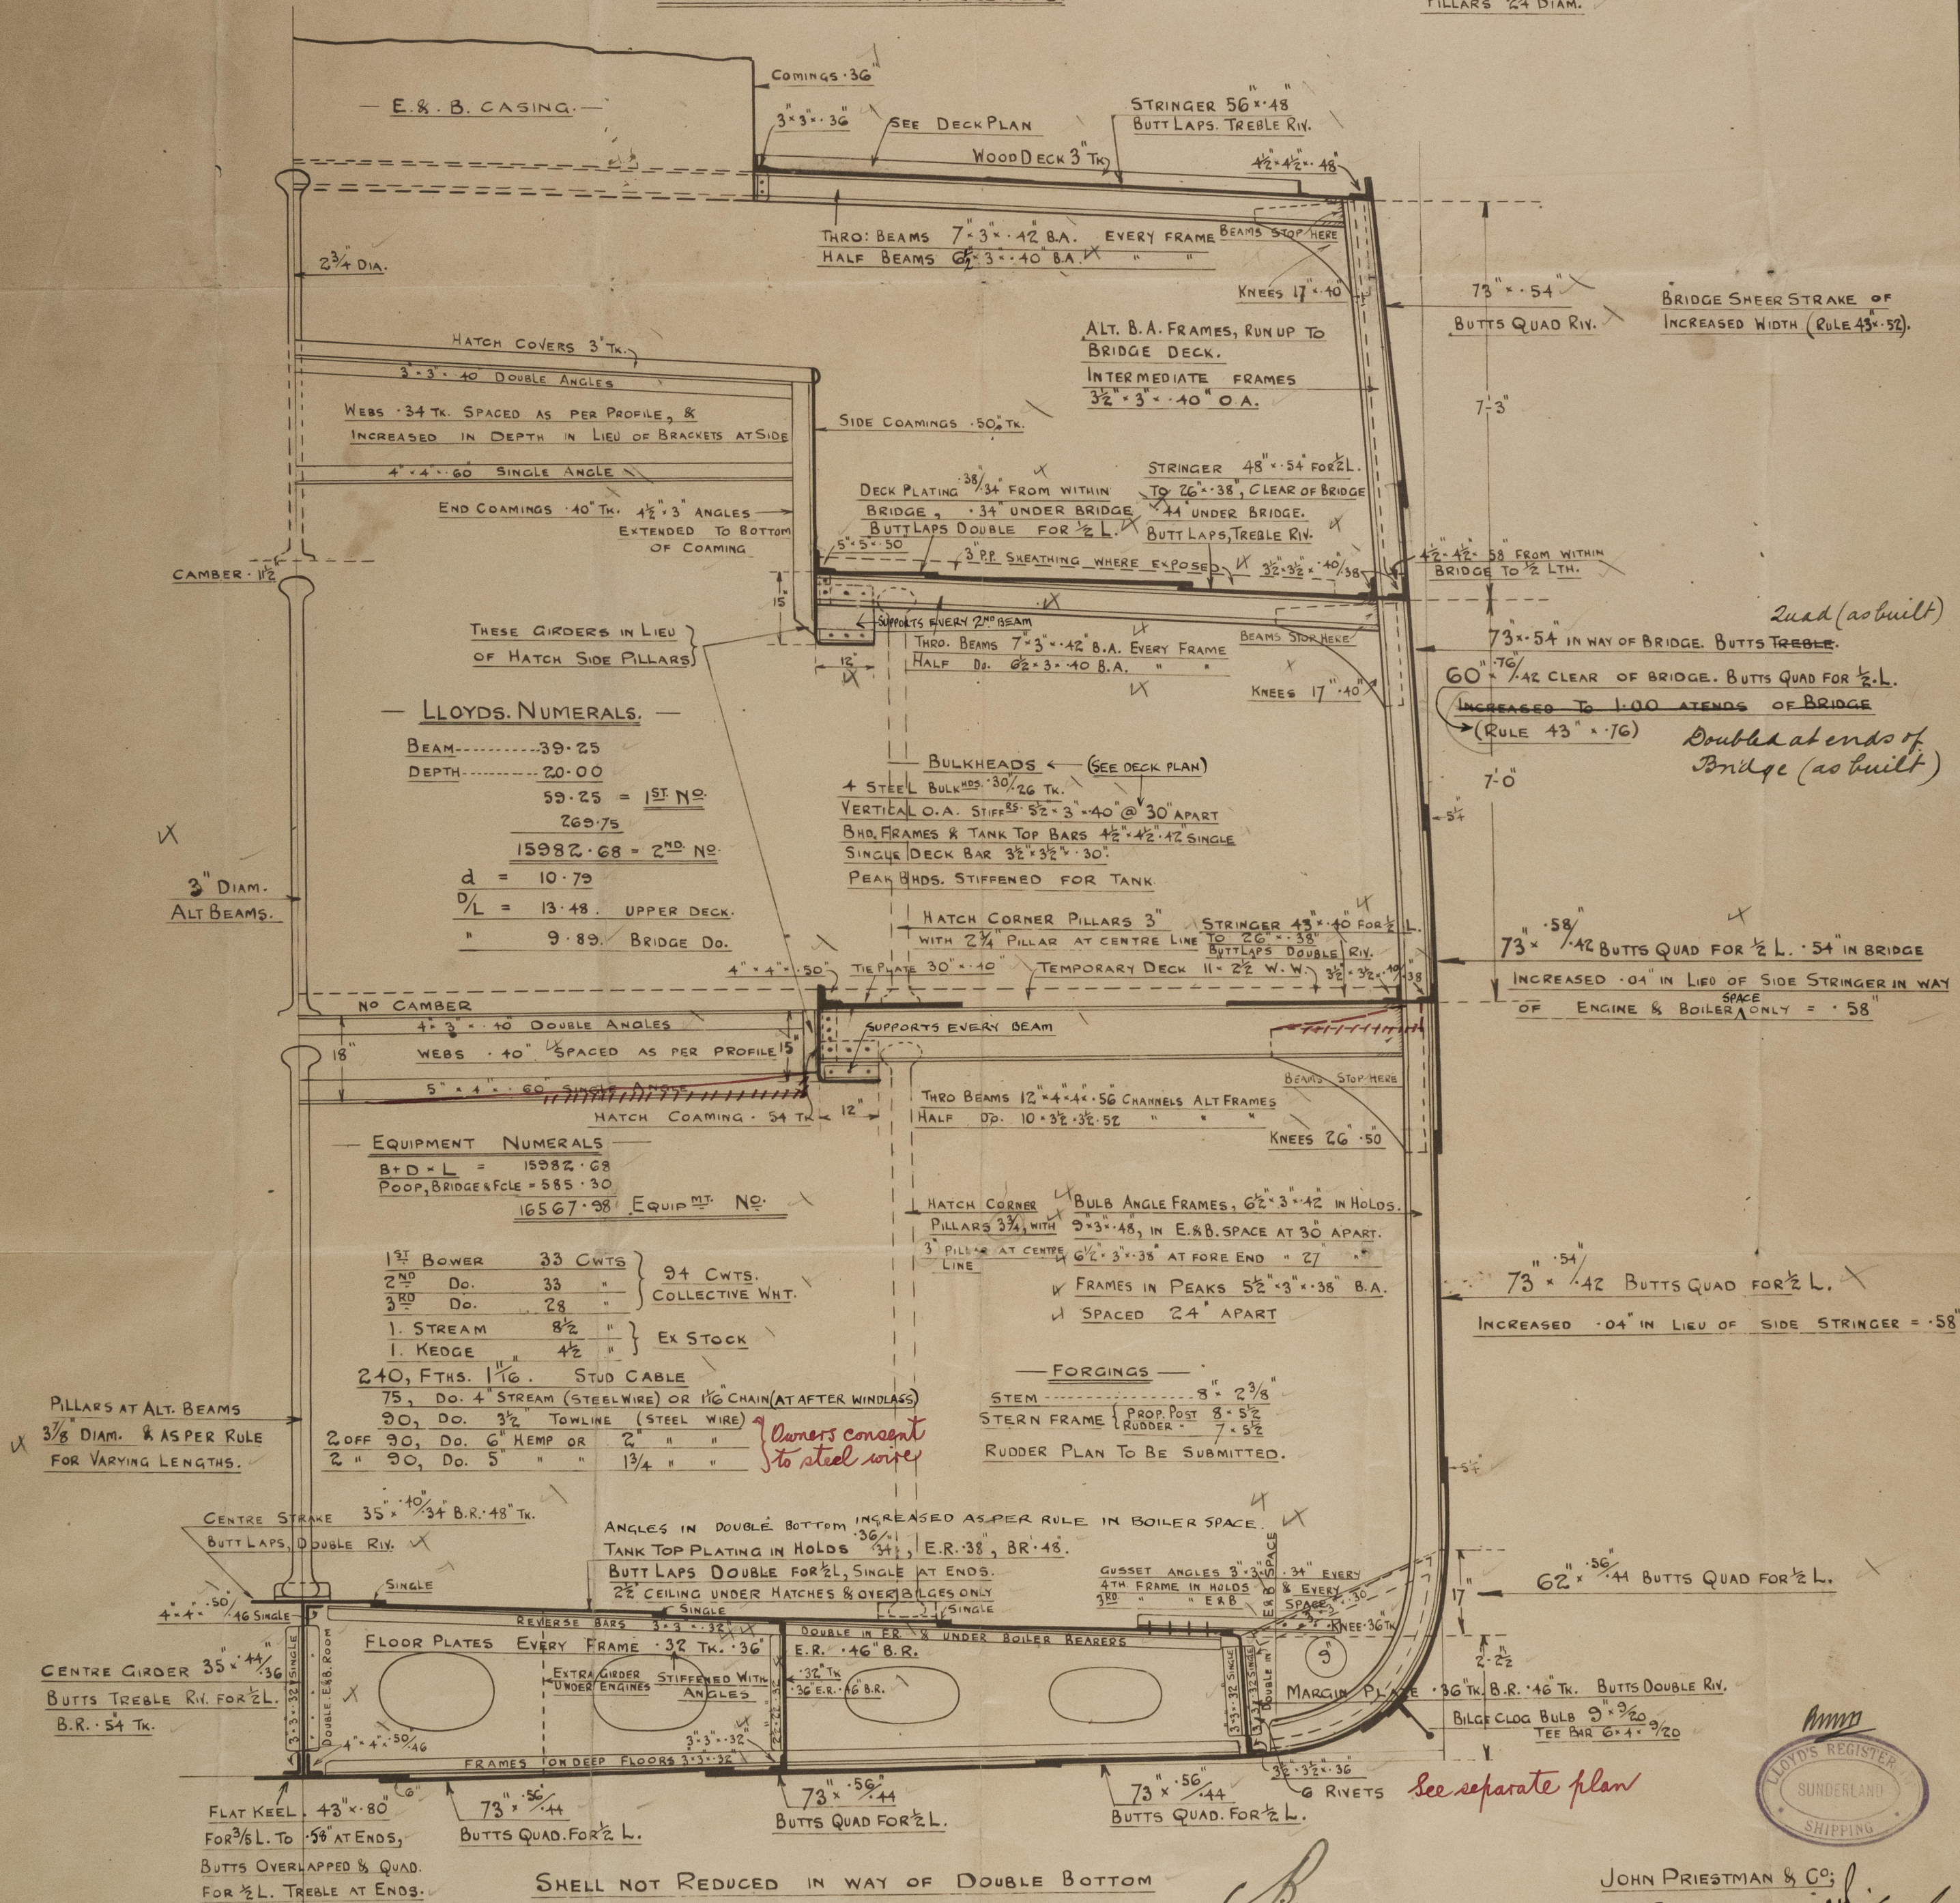

JOHN PRIESTMAN & CO;
SHIPBUILDERS,
SUNDERLAND.

Amn

LLOYD'S REGISTER
SUNDERLAND
SHIPPING



Lloyd's Register
Foundation
W11 18-0102

J. Priestman & Co.

Amended
Midship Section

S. S. No. 235

of Yi Loong

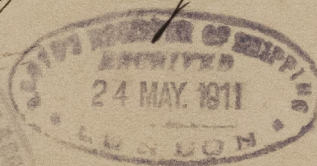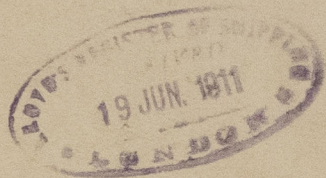

Ad. Rpt. 25/36

RETAIN



© 2021

Lloyd's Register
Foundation