


23.9.04

S.S. No. 74.
ELEVATION.
DIMS. 121'-6" B.P. x 21'-9" x 12'-11" L_B
SCALE 1" = 15'

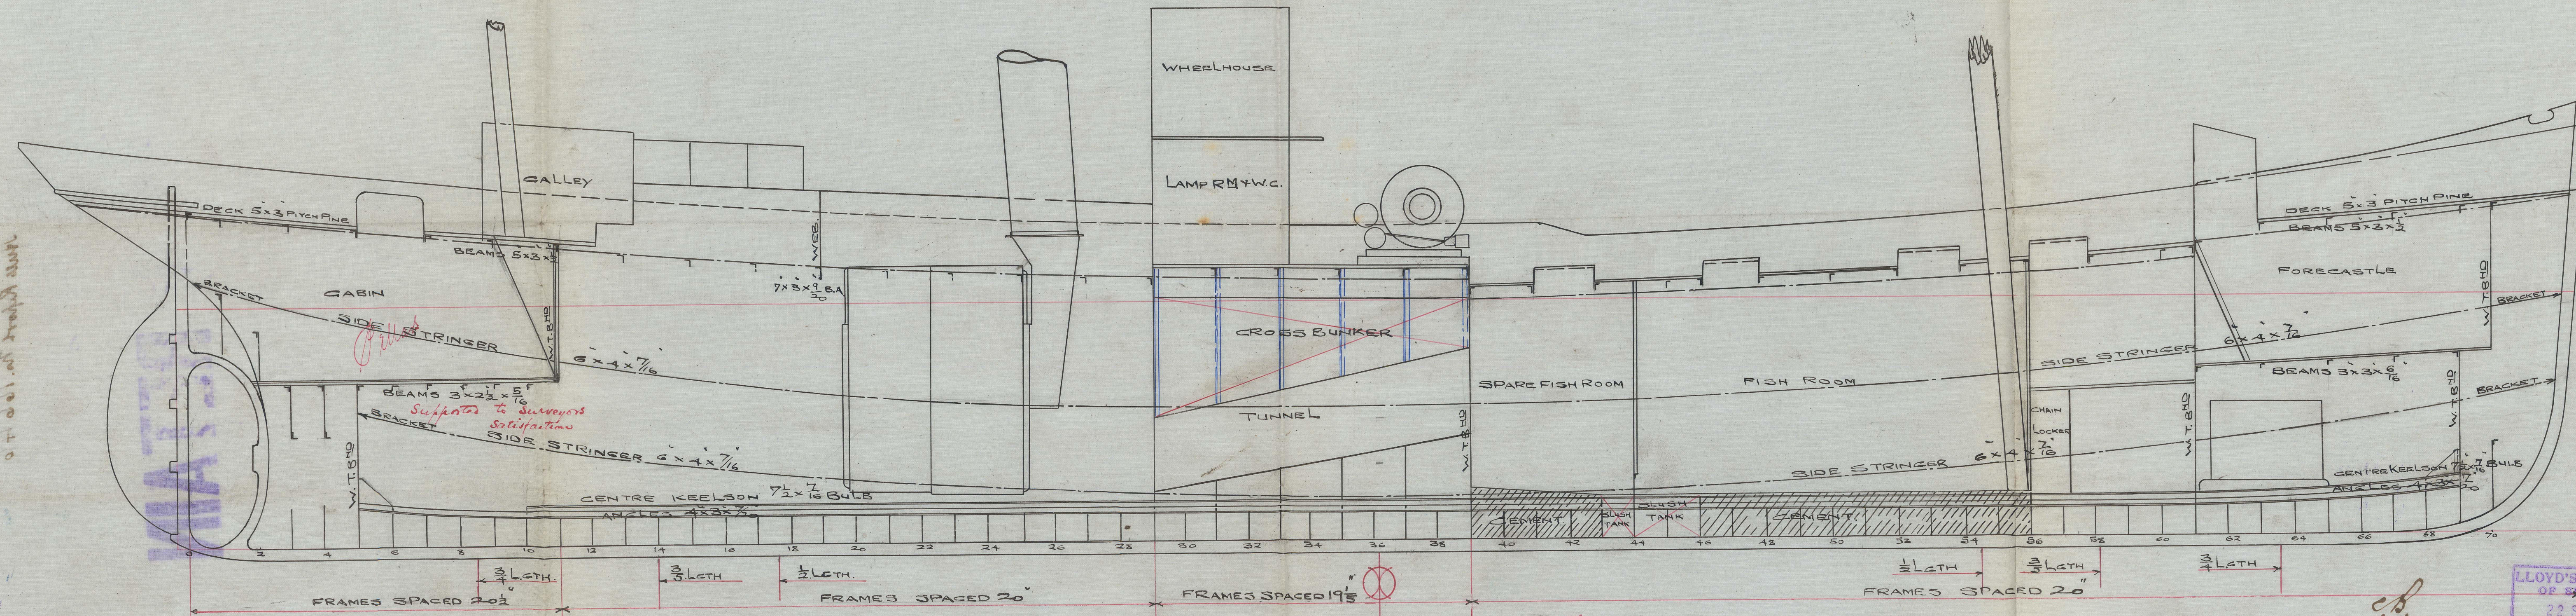

over 21.15.00
N.H.H.
23.9.04

Pillars arranged to surveyors satisfaction

23.9.04

LLOYD'S REGISTER
OF SHIPPING.
22 SEP 1904
HULL

Crook S. & R. Co.,

No. 44.

Profile.

1/2 Zinnia

Stull Report No. 16646

RETAIN



©2021

Lloyd's Register
Foundation

W1819-0063