


# MIDSHIP SECTION N<sup>o</sup> 259. 1260

SCALE  $\frac{1}{2}$ " = ONE FOOT.

## DIMENSIONS

LENGTH B.P. 350' 0"  
BREADTH EX. 50' 10"  
DEPTH MLD. (UPPER DECK) 26' 0"  
(SHELTER DECK) 23' 11"

TO CLASS 100 A.1. LLOYDS.

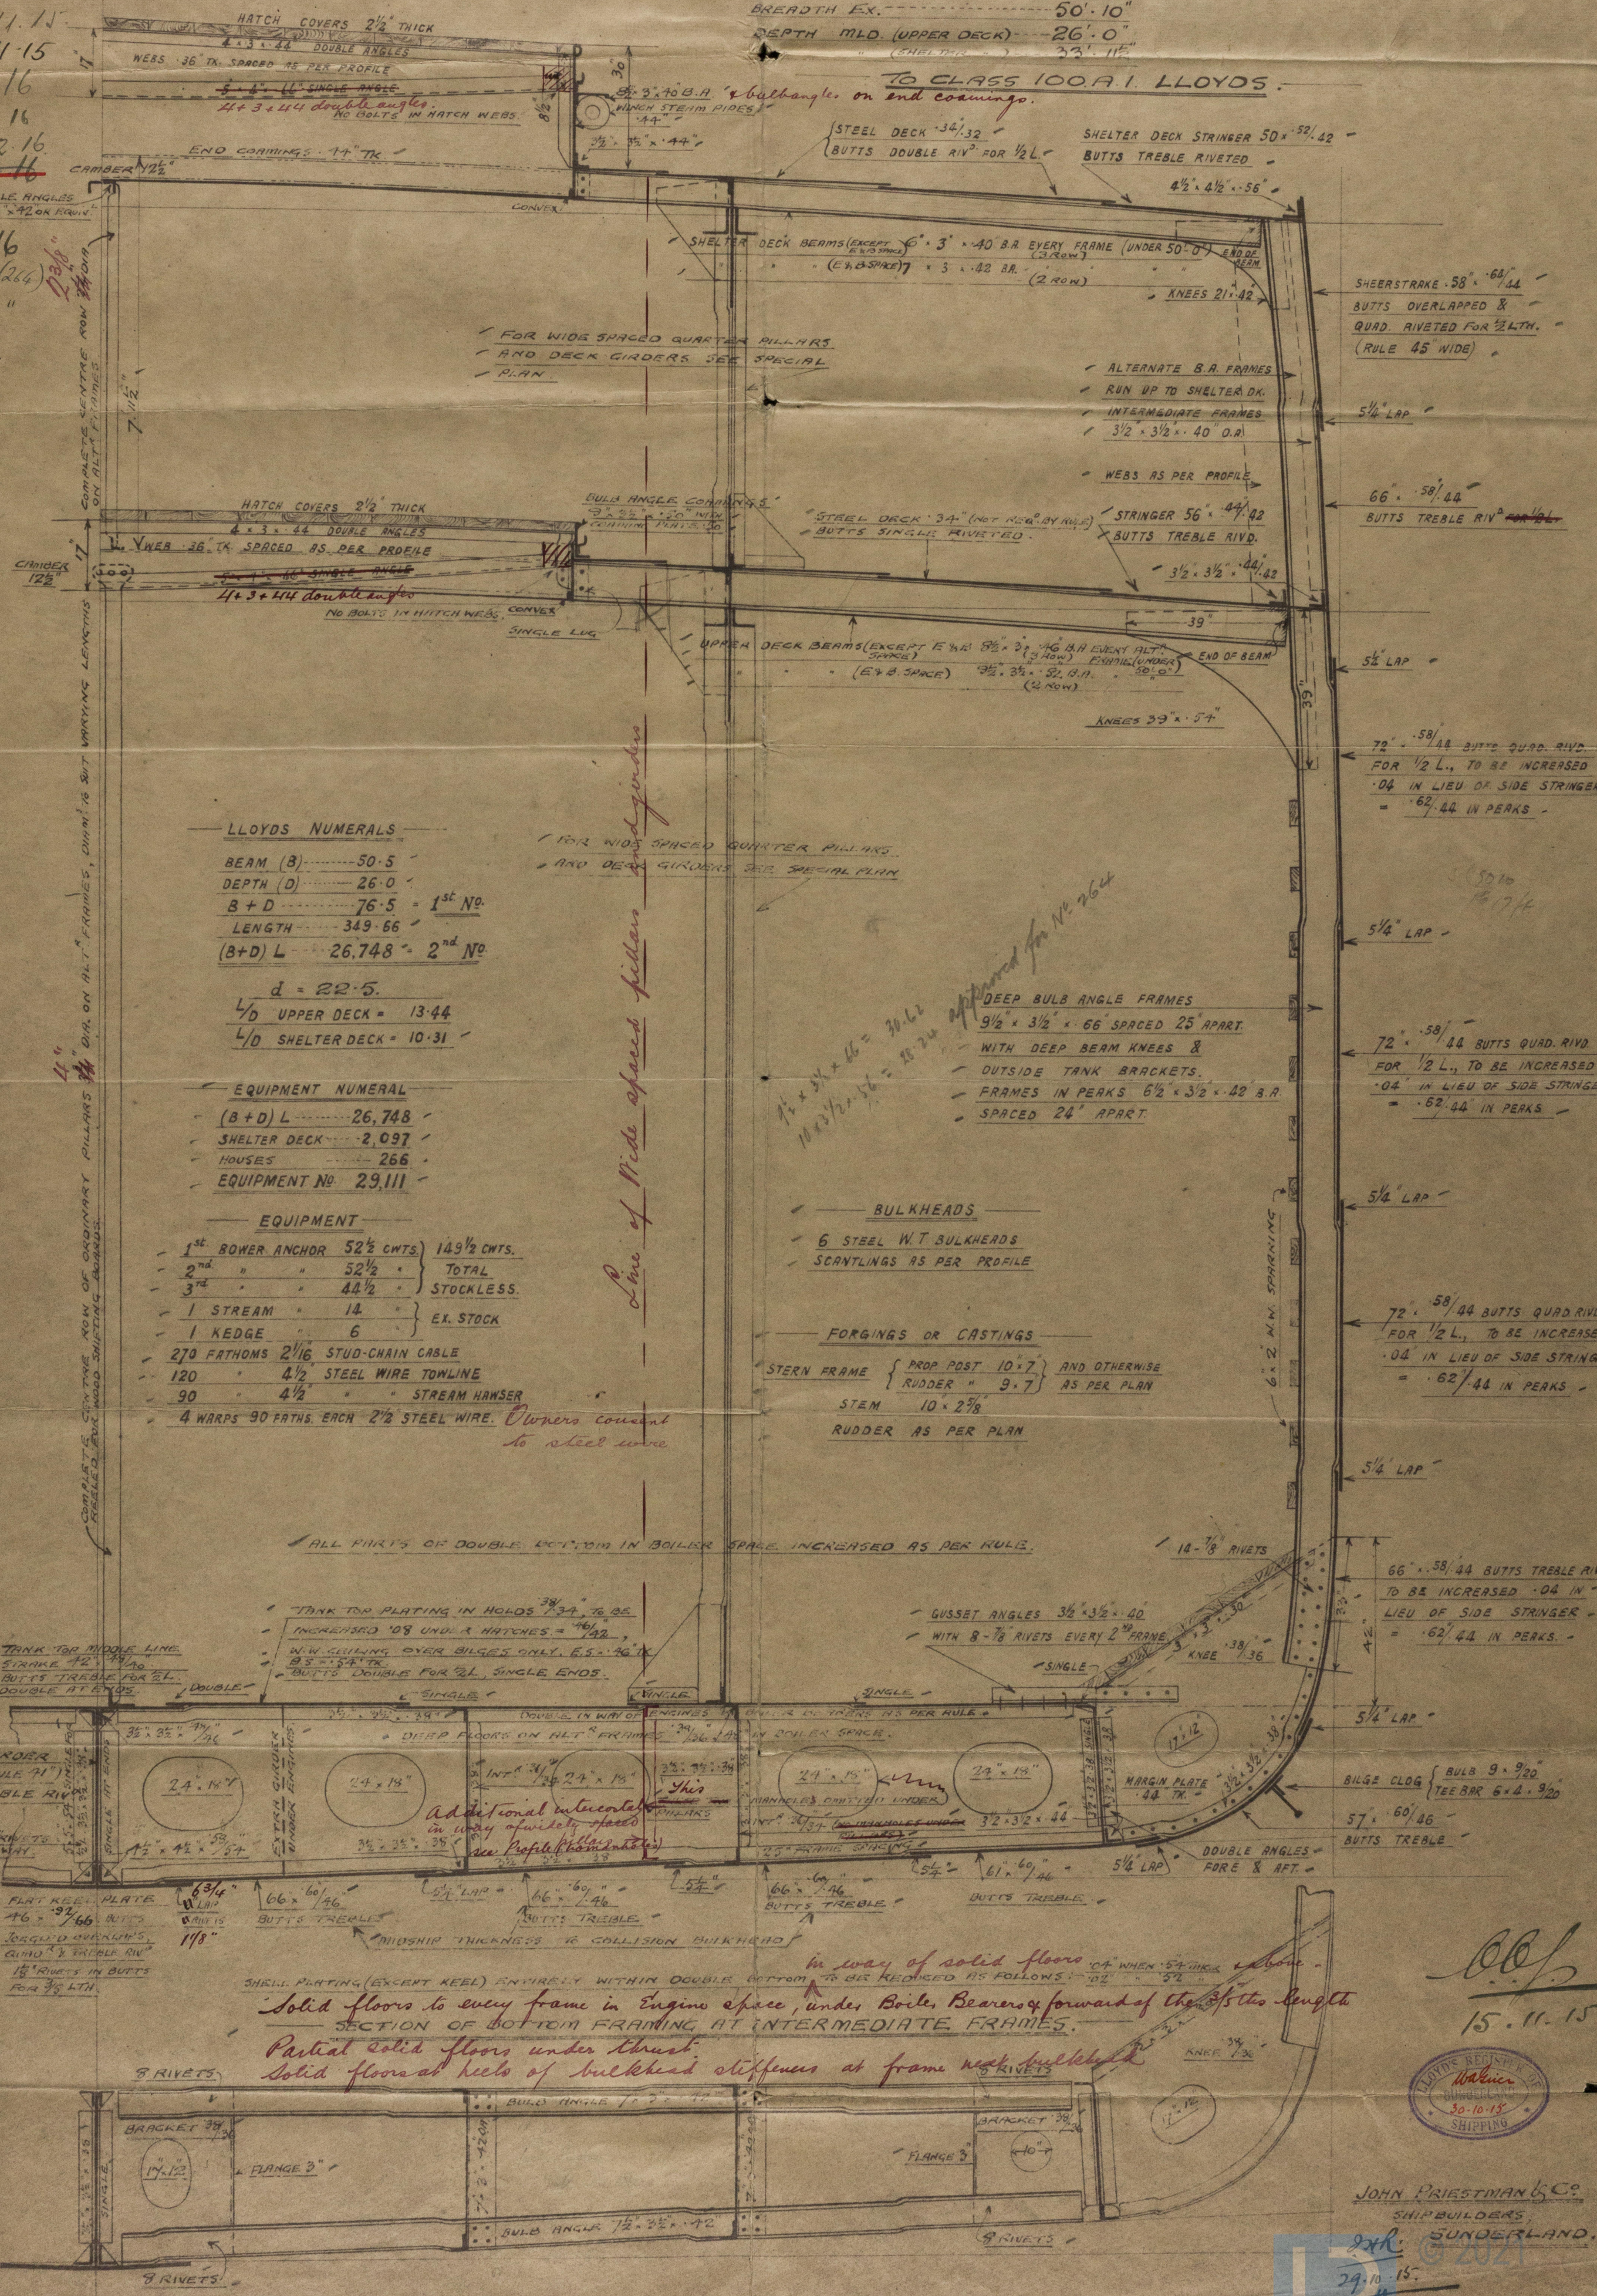

### LLOYDS NUMERALS

BEAM (B) 50.5  
DEPTH (D) 26.0  
B + D 76.5 = 1<sup>st</sup> No.  
LENGTH 349.66  
(B + D) L 26,748 = 2<sup>nd</sup> No.

d = 22.5  
L/D UPPER DECK = 13.44  
L/D SHELTER DECK = 10.31

### EQUIPMENT NUMERAL

(B + D) L 26,748  
SHELTER DECK 2,097  
HOUSES 266  
EQUIPMENT No. 29,111

### EQUIPMENT

1<sup>st</sup> BOWER ANCHOR 52 1/2 CWTs. 149 1/2 CWTs.  
2<sup>nd</sup> " 52 1/2 " TOTAL  
3<sup>rd</sup> " 44 1/2 " STOCKLESS  
1 STREAM 14 " EX. STOCK  
1 KEDGE 6 " EX. STOCK  
270 FATHOMS 2 1/16" STUD-CHAIN CABLE  
120 4 1/2" STEEL WIRE TOWLINE  
90 4 1/2" " " STREAM HAWSER  
4 WARPS 90 FATHS. EACH 2 1/2" STEEL WIRE.

### BULKHEADS

6 STEEL W.T. BULKHEADS  
SCANTLINGS AS PER PROFILE

### FORGINGS OR CASTINGS

STERN FRAME { PROP POST 10' x 7' } AND OTHERWISE  
RUDDER " 9' x 7' " AS PER PLAN  
STEM 10' x 2 7/8"  
RUDDER AS PER PLAN

ALL PARTS OF DOUBLE BOTTOM IN BOILER SPACE INCREASED AS PER RULE.

TANK TOP PLATING IN HOLDS 3/4" x 16 BS  
INCREASED .08 UNDER HATCHES = 1/2"  
N.W. CLIPPING OVER BILGES ONLY 6.5" x 16 BS  
BUTTS DOUBLE FOR 2L SINGLE ENDS.

GUSSET ANGLES 3 1/2" x 3 1/2" x 40  
WITH 8-7/8 RIVETS EVERY 2" FRAME

TANK TOP MIDDLE LINE  
FRAME 12' x 16 BS  
BUTTS TREBLE FOR 2L  
DOUBLE AT ENDS.

FLAT KEEL PLATE 1/4" x 16 BS  
46' x 16 BS BUTTS  
BOLTED OVERLAPS  
4000' x TREBLE RIV  
18' RIVETS IN BUTTS  
FOR 3/8 LTH.

SHELL PLATING (EXCEPT KEEL) ENTIRELY WITHIN DOUBLE BOTTOM TO BE REDUCED AS FOLLOWS:  
Solid floors to every frame in Engine space under Boilers, Bearers & forward of the 3<sup>rd</sup> stbd length  
SECTION OF BOTTOM FRAMING AT INTERMEDIATE FRAMES.  
Partial solid floors under thrust.  
Solid floors at heels of bulkhead stiffeners at frame next bulkhead.

15.11.15



JOHN PRIESTMAN & CO.  
SHIPBUILDERS,  
SUNDERLAND.

29.10.15  
Lloyd's Register  
162-0122





MIDSHIP SECTION

PRIESTMANS N° 259

260

4262






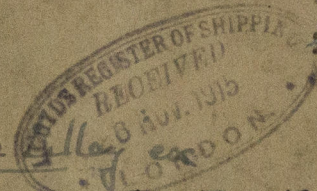
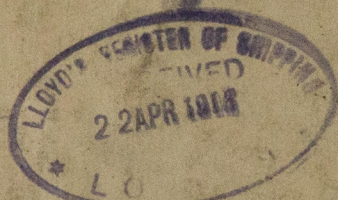


S.S. CLIFFSIDE SLD RPT N°

S.S. MAINDY COURT " " "

27024

28957

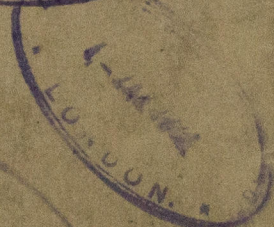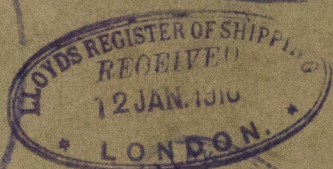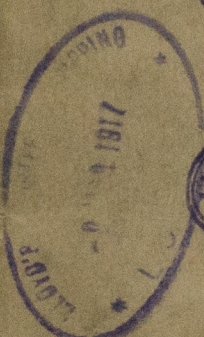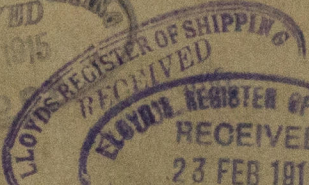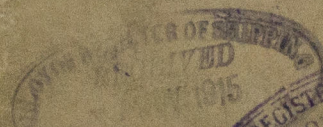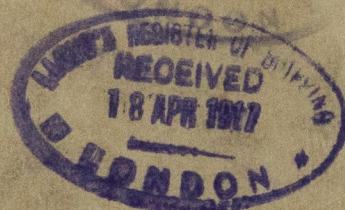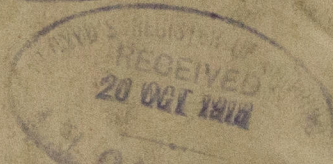

W162-0122



© 2021  
Lloyd's Register  
Foundation