


PROFILE N^o 259. ^{260.}

SCALE $\frac{1}{8}$ " = ONE FT.

DIMENSIONS

LENGTH B.P. 350' 0".
BREADTH EXT. 50' 10".
DEPTH MLO. U.D. 26' 0".
" " S.D. 33' 1 1/2".

JOHN PRIESTMAN & CO.
SHIPBUILDERS. ^{John.}
SUNDERLAND. ^{29.10.15.}

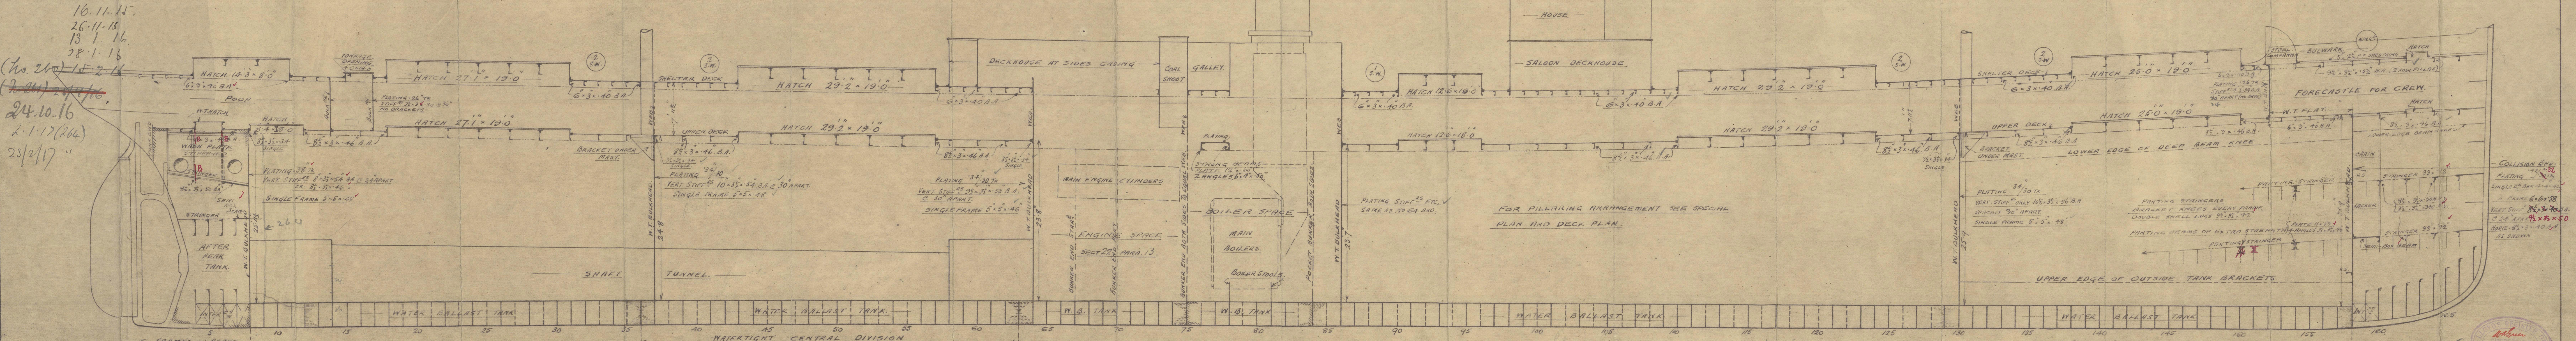

16.11.15.
26.11.15.
13.1.16.
28.1.16.
(No. 260) 15.2.16.
~~(No. 260) 24.10.16.~~
24.10.16.
2.1.17 (264)
23/2/17 "

FOR PILLARING ARRANGEMENT SEE SPECIAL
PLAN AND DECK PLAN.

Bulkheads in No 260 to be in accordance with the
requirements of the Rules now in force

PLAN OF PAINTING ARRANGEMENTS & STRENGTHENING
OF BOTTOM FORWARD TO BE SUBMITTED

FRAMES IN PEAKS
6" x 3 1/2" x 42 B.A.
SPACED 2' 4" APART.




© 2021









Lloyd's Register
Foundation

PROFILE

PRIESTMANS N^o 259

 *Clare Lillyer* x 26
S. S. CLIFFSIDE
SLO RPI N^o 26957

S. S. MAINDY COURT
SLO RPI N^o 27024

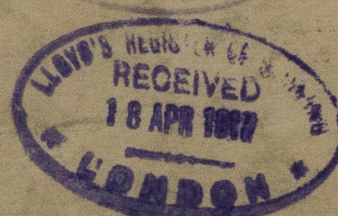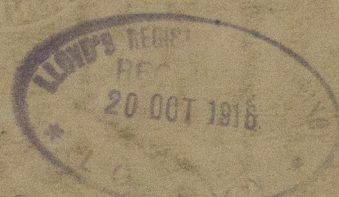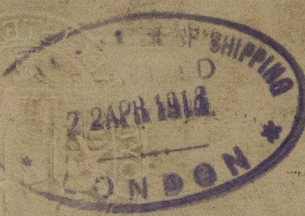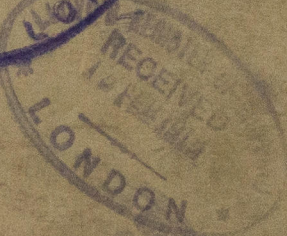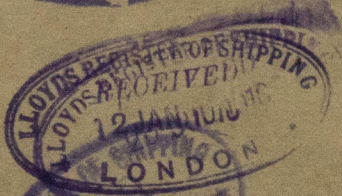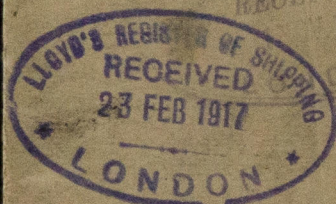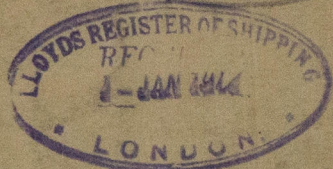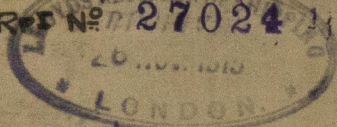

W162-0125

© 2021

Lloyd's Register
Foundation