


29.5.14  
9.6.14  
15.6.14  
30.6.14  
11.7.14  
23.7.14

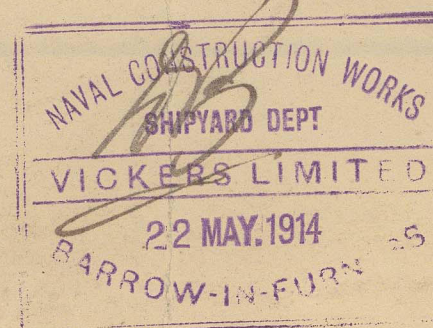

# Canadian Ice Breaking Steamer


Nº 877 B

## Profile and Deck Plans

Dimensions 275'0" B.P., x 57'6" Breadth Mld., x 32'0" Depth Mld. to upper deck.

Glass 100 A.I. Lloyd's  
Scale 1/8" = 1 foot.

Relieving throughout to be to the Surveyors Satisfaction

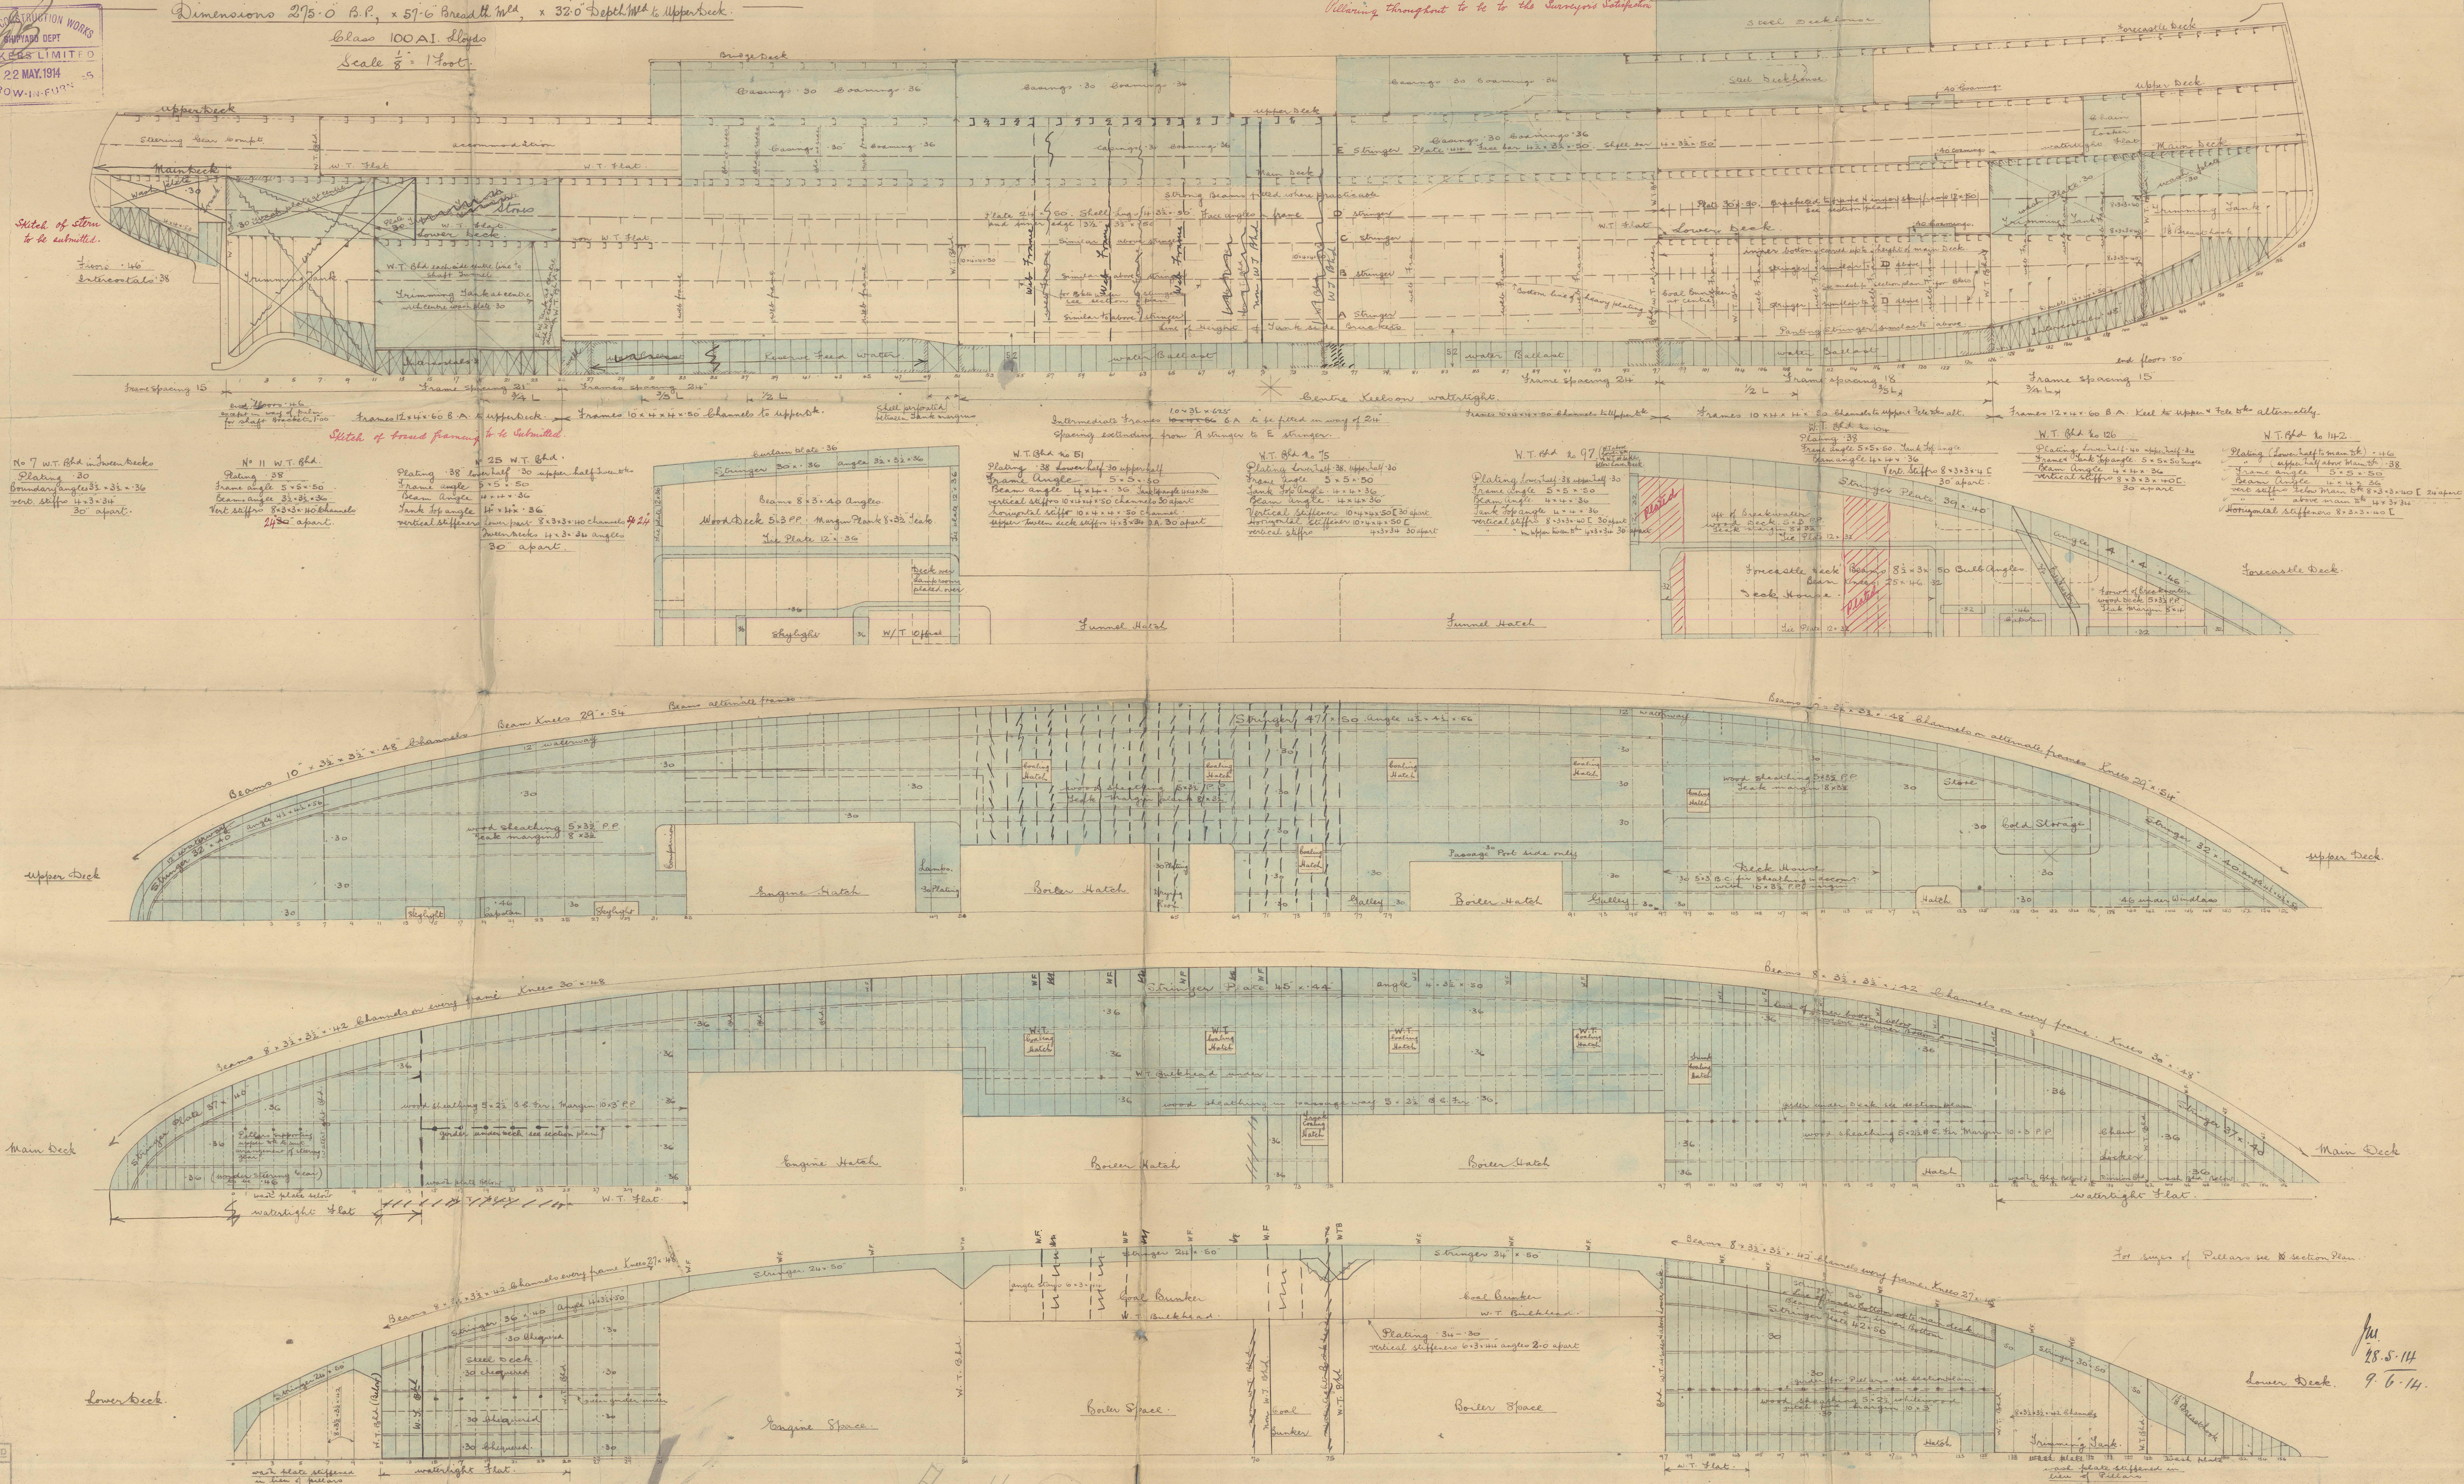

VICKERS LTD  
SHIP DRAWING OFFICE  
PLAN Nº 11  
DRAWN BY E.W.D.  
EXAMINED BY  
DATE 22/5/14


M  
28.5.14  
9.6.14



Profile Deck.  
Canadian Icebreaking  
Steamer.

Meers. Tickers L<sup>td</sup>

Bur

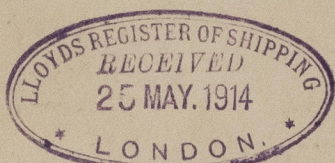

RETAIN



© 2021

Lloyd's Register  
Foundation

W1620-0044




②

S/S "Mikula Selianinovitch"

Int. Rpt. No. 1362.

CANADIAN VICKERS-ICE BREAKER

PROFILE AND DECK PLANS.

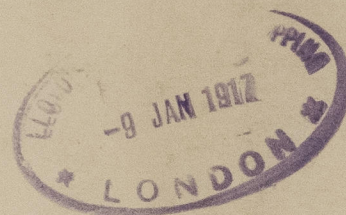

②



© 2021

Lloyd's Register  
Foundation