

9.6.14



Canadian Twin Screw Ice Breaking Steamer, No 877 B.

Proposed Modifications to Upper Deck.

Scale  $\frac{1}{8}" = 1 \text{ foot}$

Dimensions 275.0 B.P.; 242.0 O.A.; 57.6 Breadth Mld; 32.0 Depth Mld to upper deck.

89.5 Trans. number; 25086.85 Long. No; 8.72 L to D.

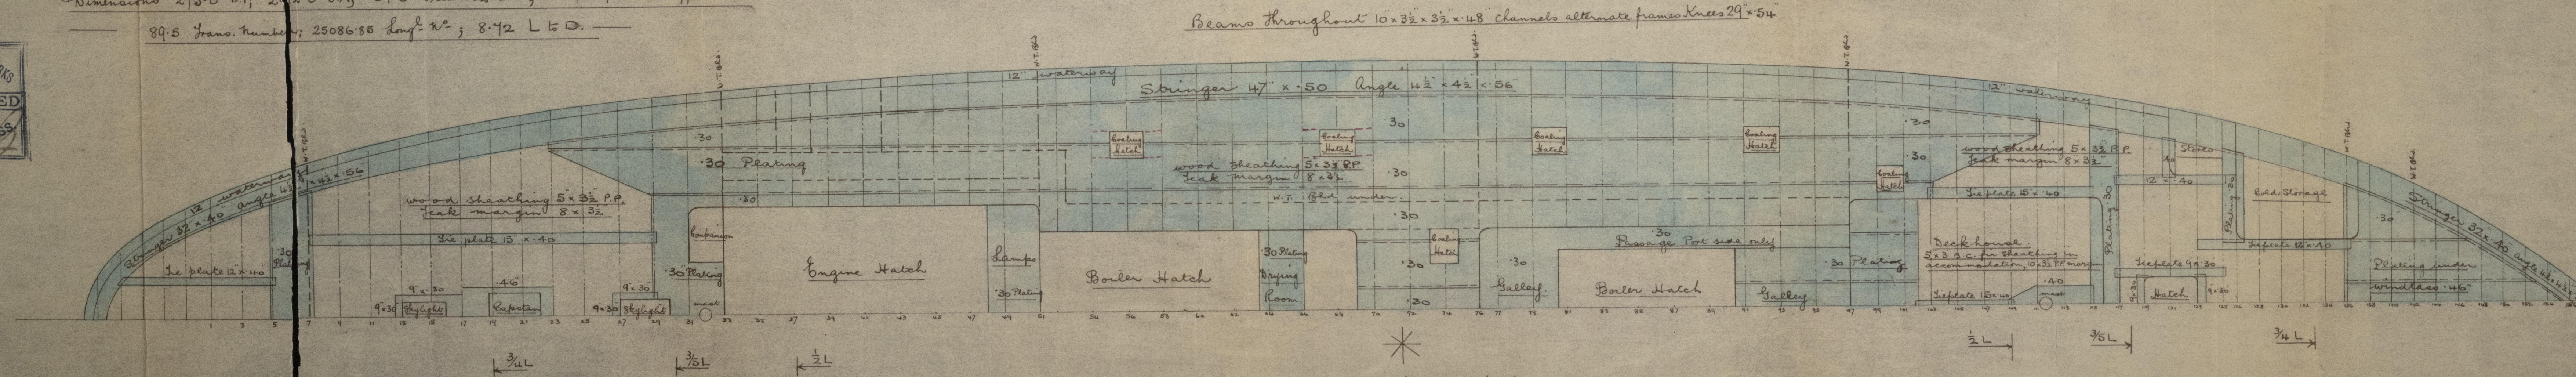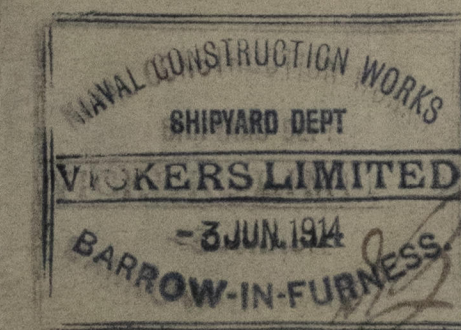

Plan of Upper Deck.

9.6.14

VICKERS  
SHIP DRAWING OFFICE  
35  
P.M.  
3/6/14



*Proposed Modification  
to Upper Deck.*

*Canadian Icebreaker  
Messrs. Vickers Ltd.*



**RETAIN**



© 2021

Lloyd's Register  
Foundation

W1620-0045



(12)

S/S "Mikula Selianovitch"

Int. Reg. No. 1362

CANADIAN VICKERS. ICEBREAKER

PROPOSED MODIFICATION TO UPPER DECK



© 2021

Lloyd's Register  
Foundation