


SCALE $\frac{1}{2}'' = 1 \text{ FOOT}$

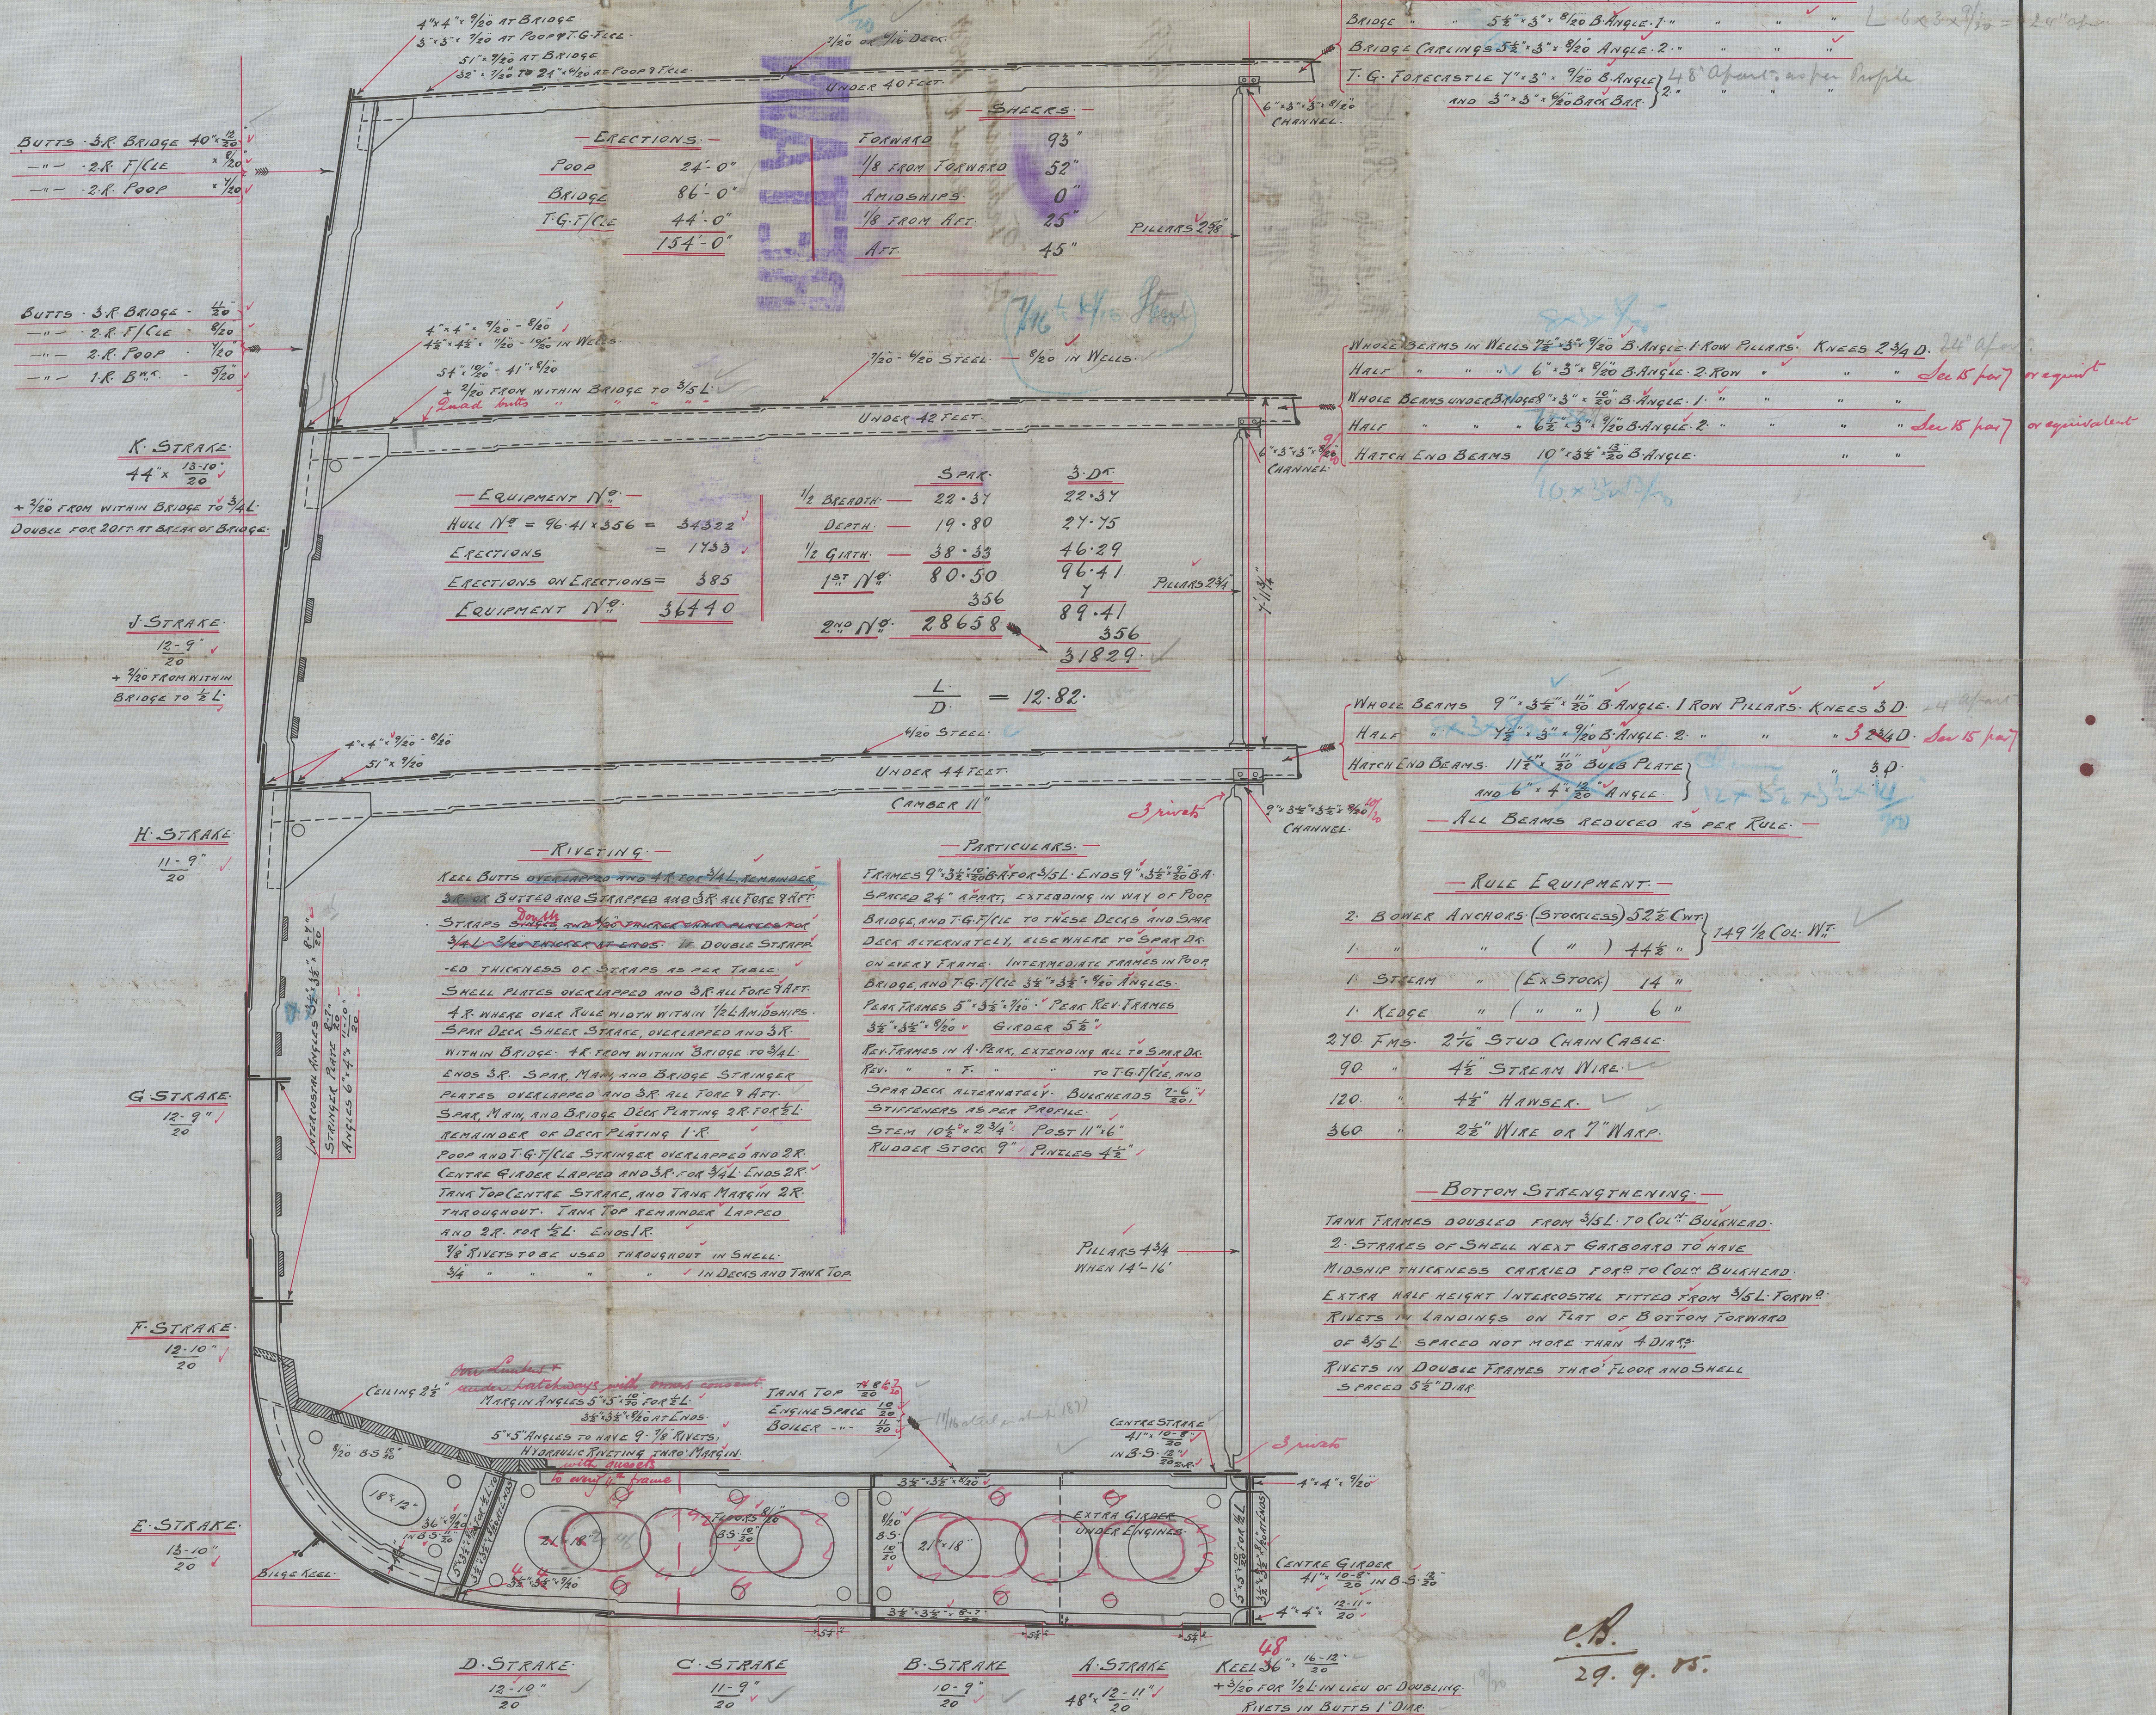

Midship Section
Hamilton & Co's

N^o. 184-8.

Curistan 187.

Greenock Report N^o. 14791

S.S. Tabaristan

Greenock Report N^o. 14881

RETAI

LR

© 2021

Lloyd's Register
Foundation

W1622-0089

Midship Section
Hamilton & Co's
No. 184-S.

Curistan 187.

Greenock Report No. 14791

S.S. Tabaristan

Greenock Report No. 14881

RETAIN

W1622-0089

1874



© 2021

Lloyd's Register
Foundation