


16.1.02

THICKNESSES	STEEL	IRON


SURFACES ETC.		
120 TUBES 3/4" EXT. DIA. @ 5.52 #	663.6 #	
FURNACES	57	
TOTAL HEATING SURFACE	824.6	
GRATE AREA @ 2'-10 1/2" DIA.	31.6	
WATER	82	
TUBE	5.5	
STEAM SPACE	159 cu. ft.	
RATIO GRATE AREA TO HEATING SURFACE	1: 26	
TUBE	1: 21	
AREA	1: 174	
WATER	1: 2.59	
STEAM SPACE	1: 4.87	
1/2" BOILER ABOVE FIREBOX	31.2	
LENGTH OF FIREBOX	5'-6"	
WEIGHT OF WATER	11 TONS	

BACK END STAY  
— 1/8" PITCH OF 2'-5 1/2" —



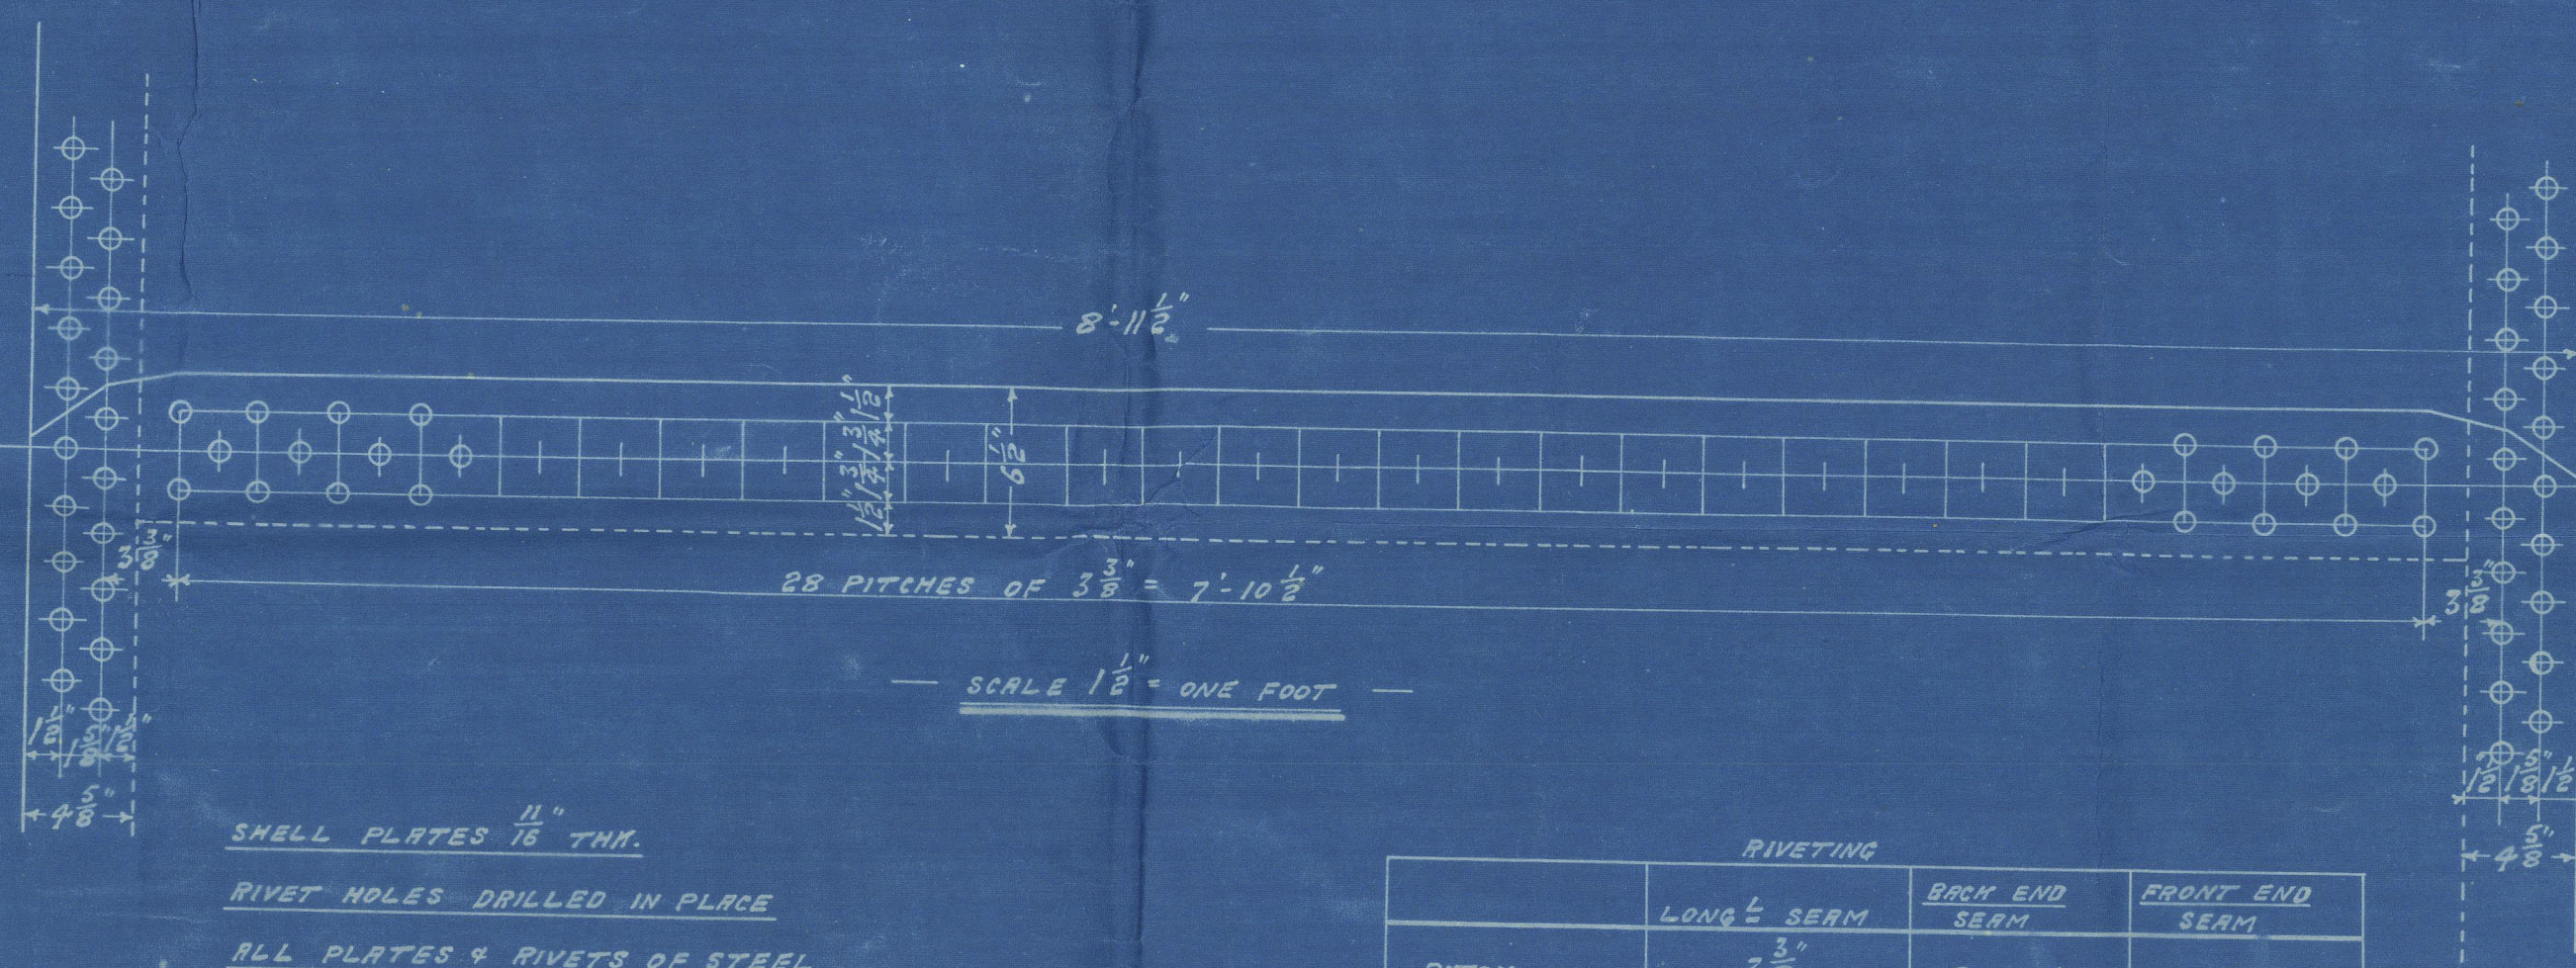


PITCH	RIVETING	
	LONG & SEAM	END END SEAM
3 1/2"	2'-5 1/2"	2'-5 1/2"
DIA. OF HOLES	15"	15"
1/2" PLATE	78.2	65.3
1/2" RIVET	78.2	65.3

Passed Lloyd 21/12/05

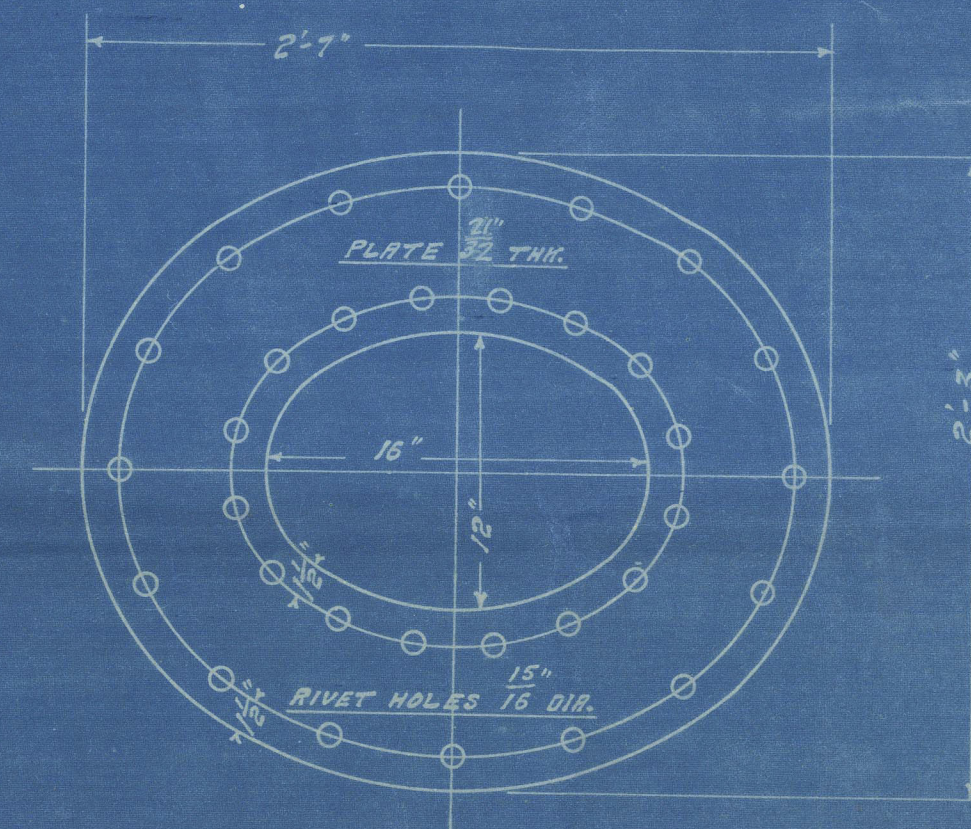

LIMITS OF TENSILE STRENGTHS	
SHELL PLATES	20 TO 32 TONS PER SQ. IN.
OTHER	20 TO 30
MAIN STAYS	27 TO 32
SCREW	20 TO 30

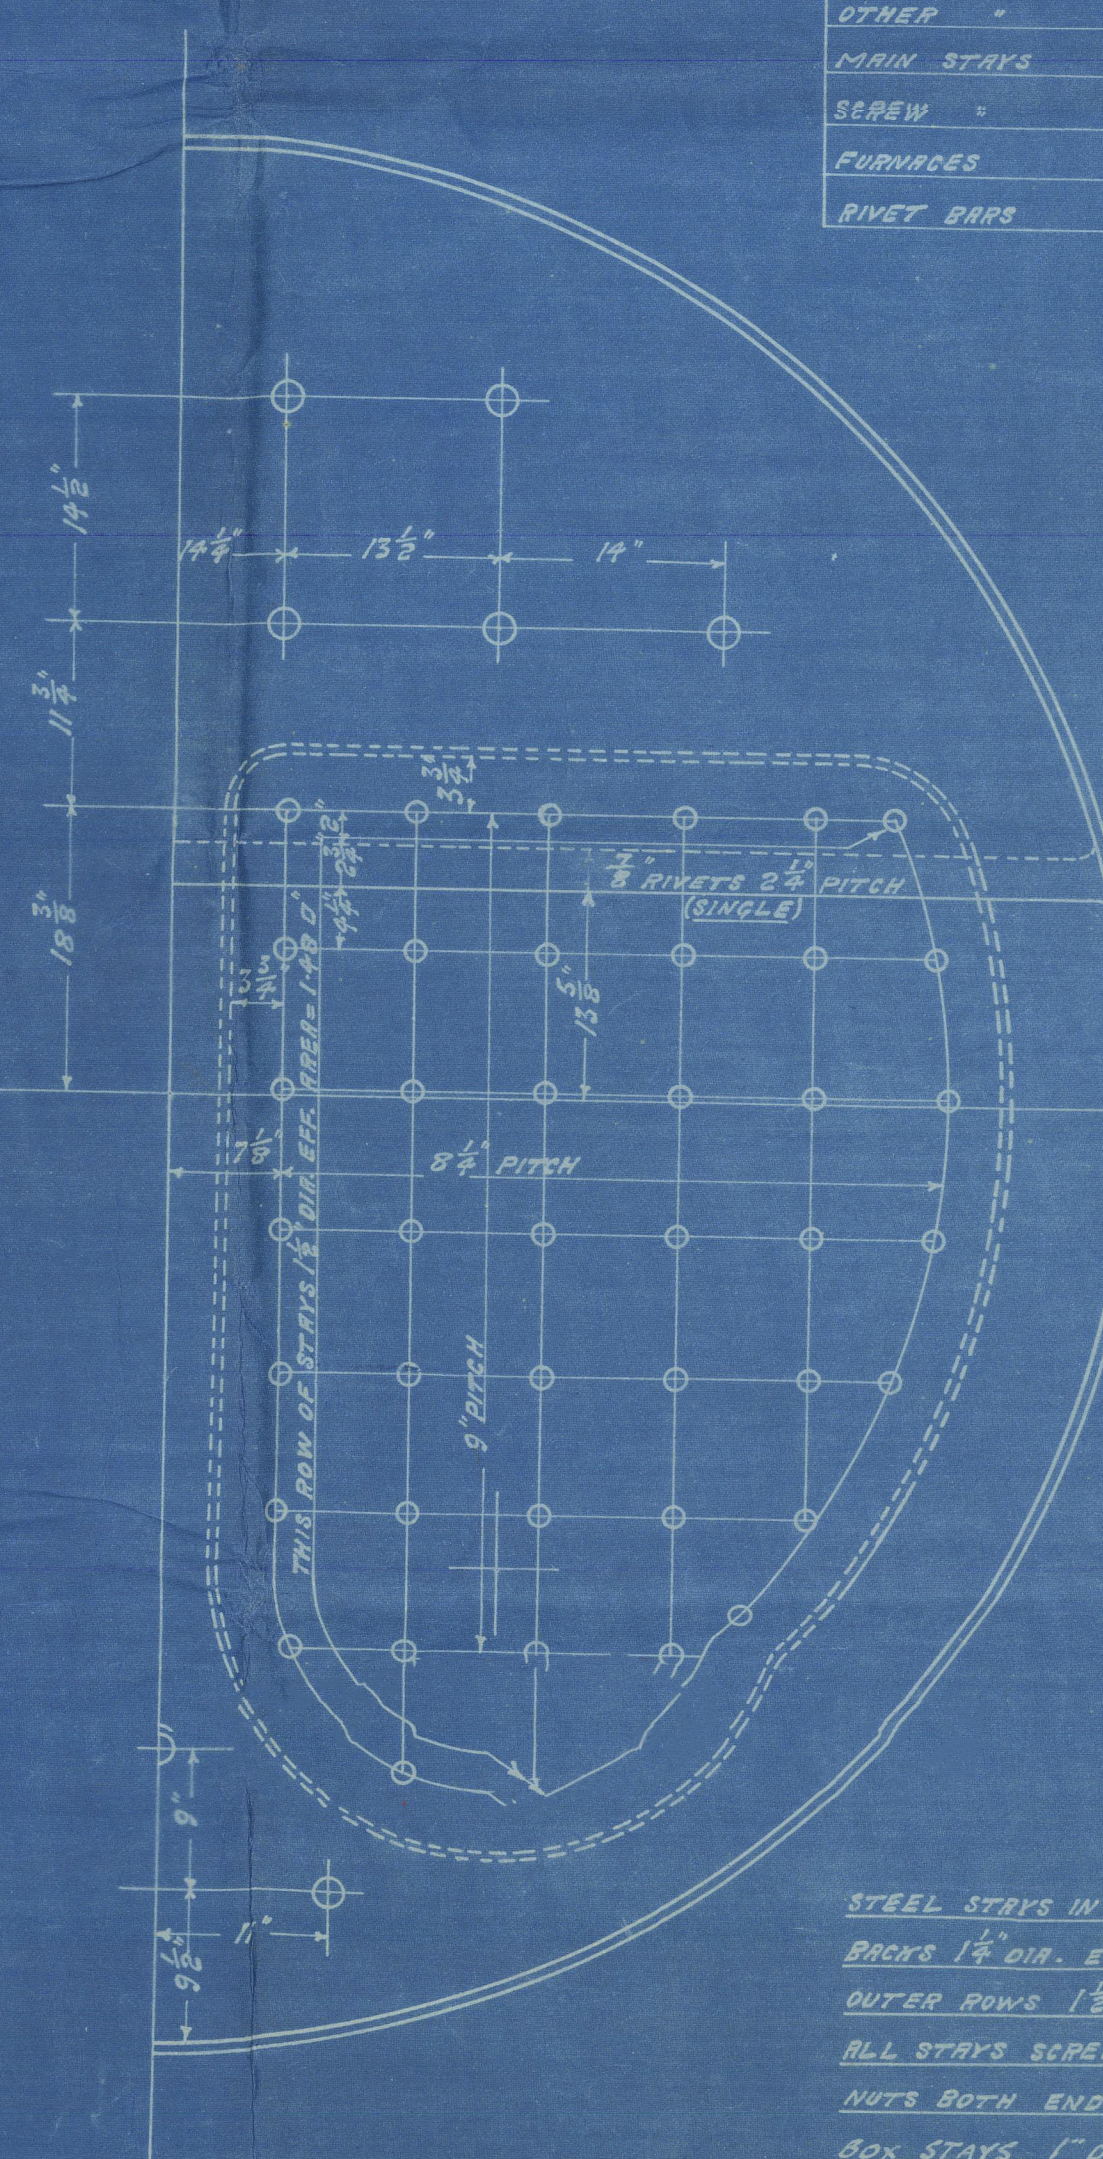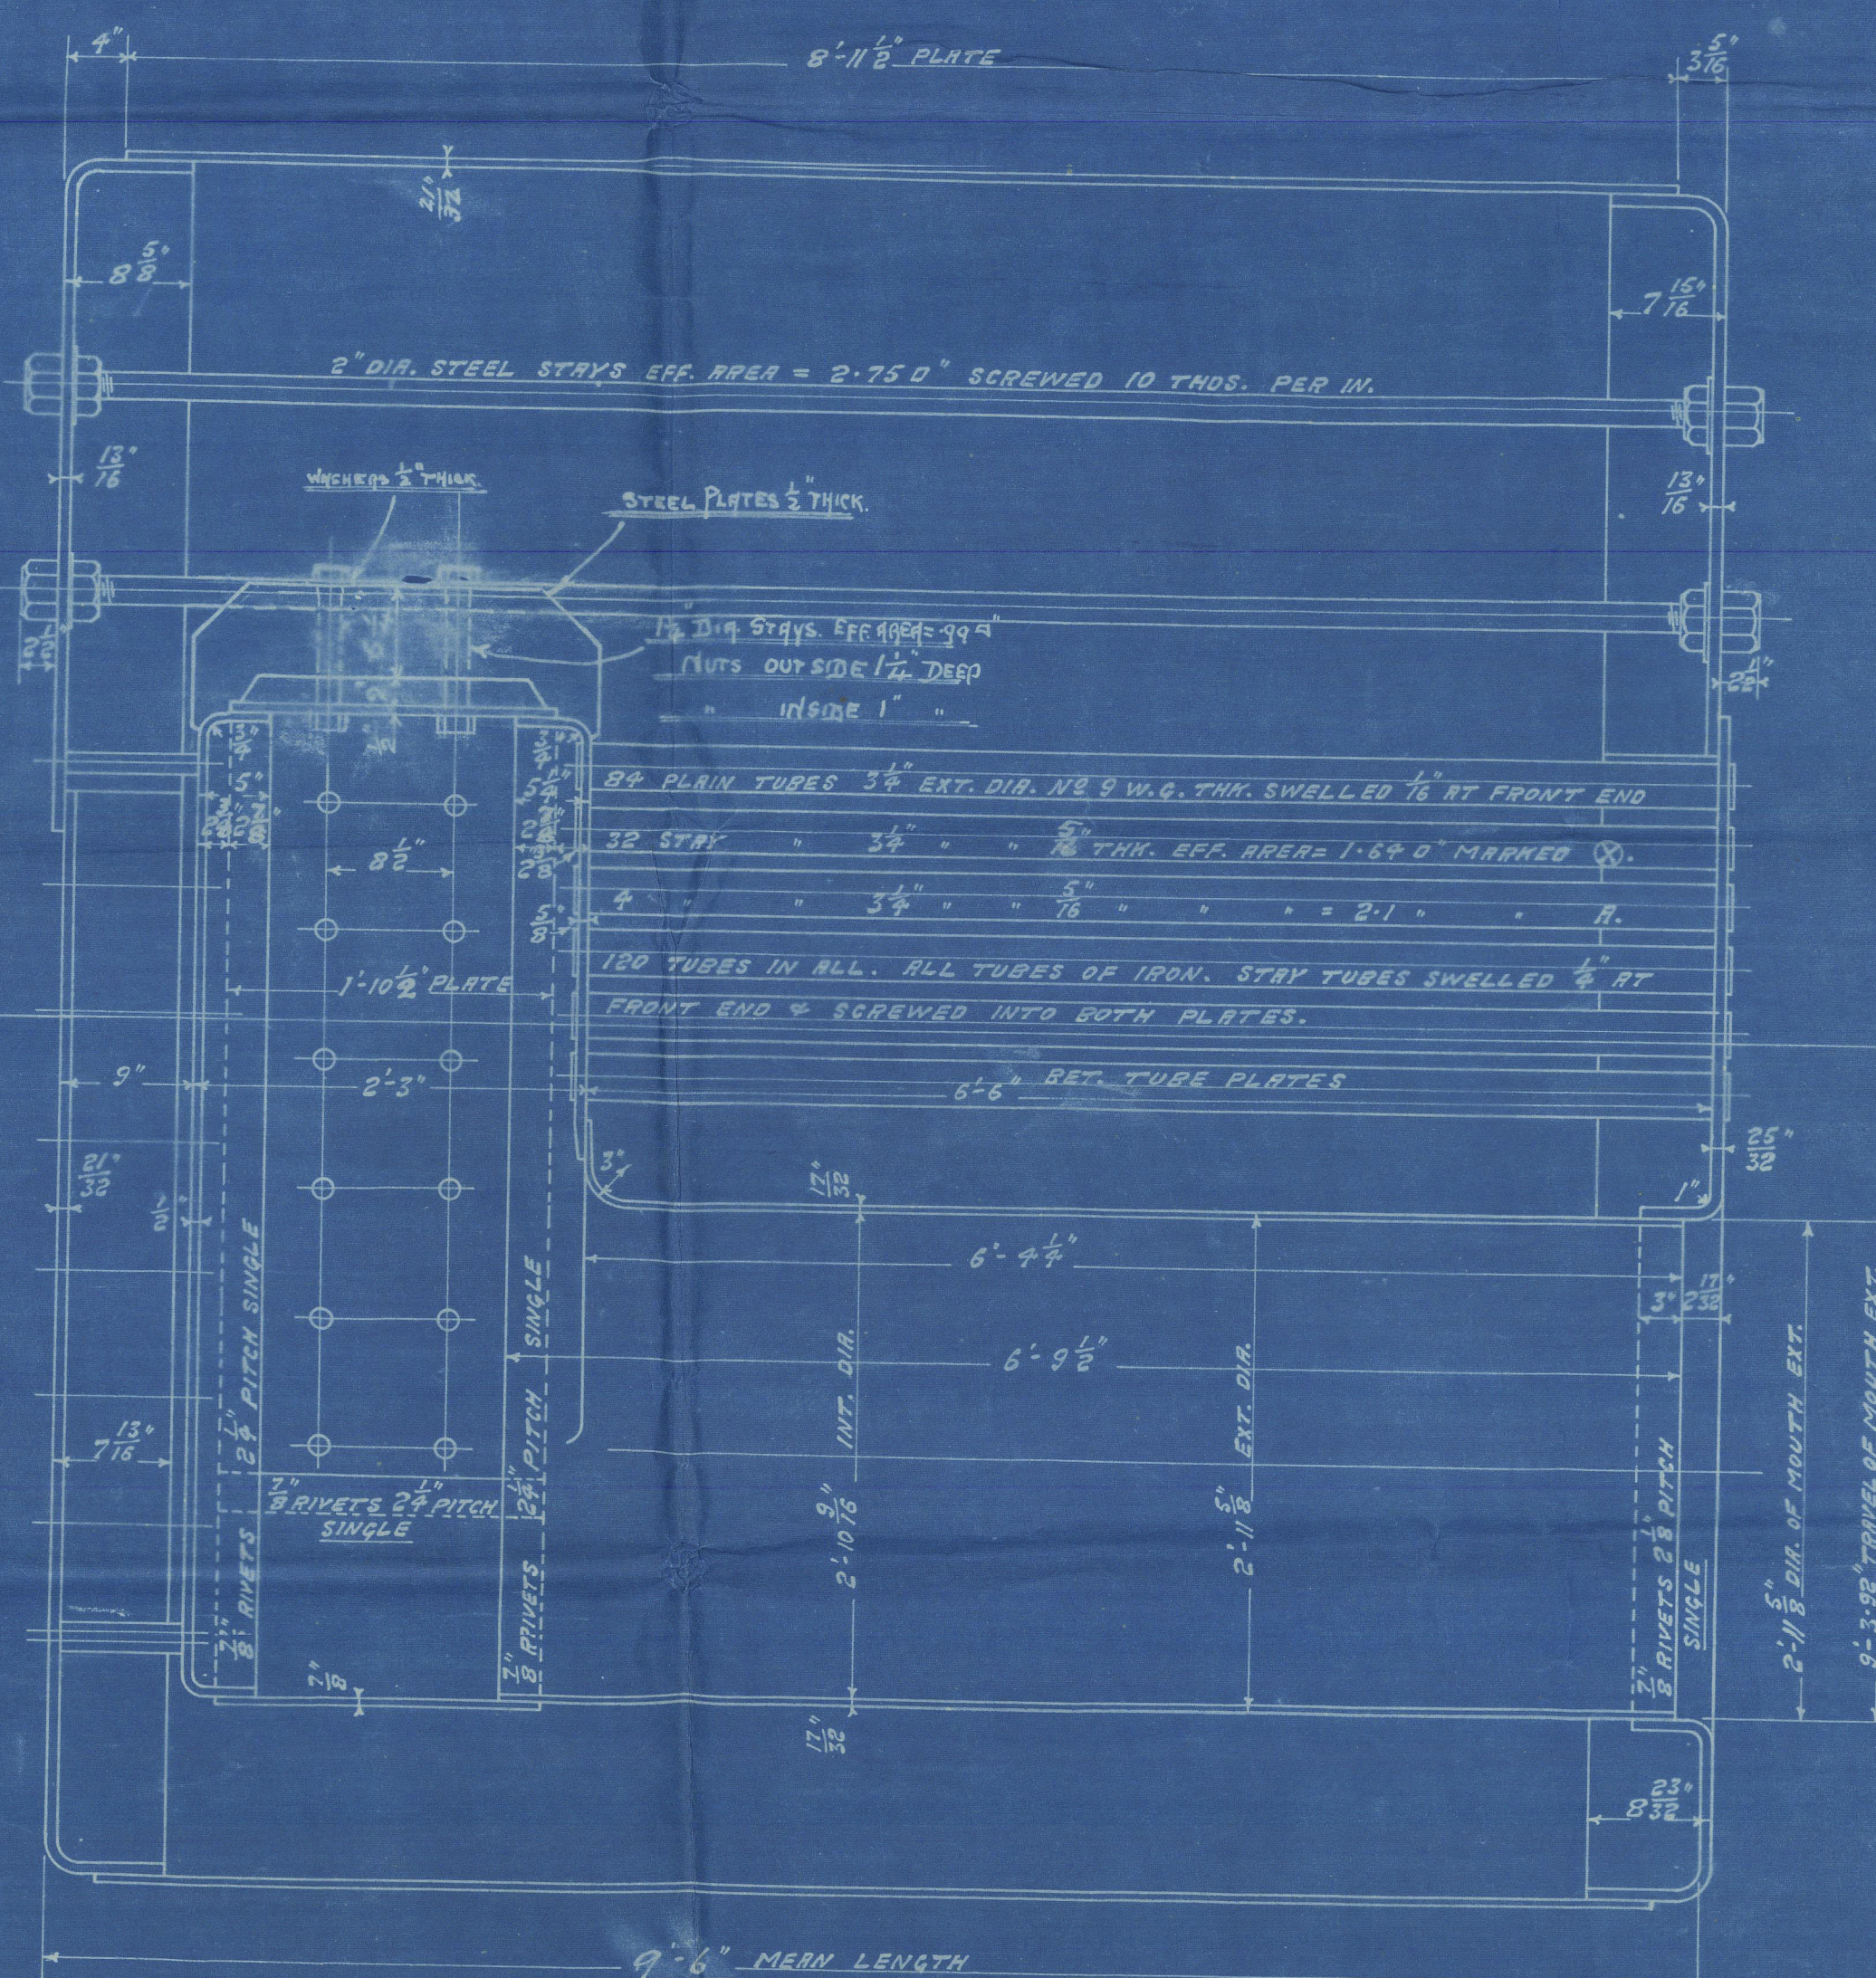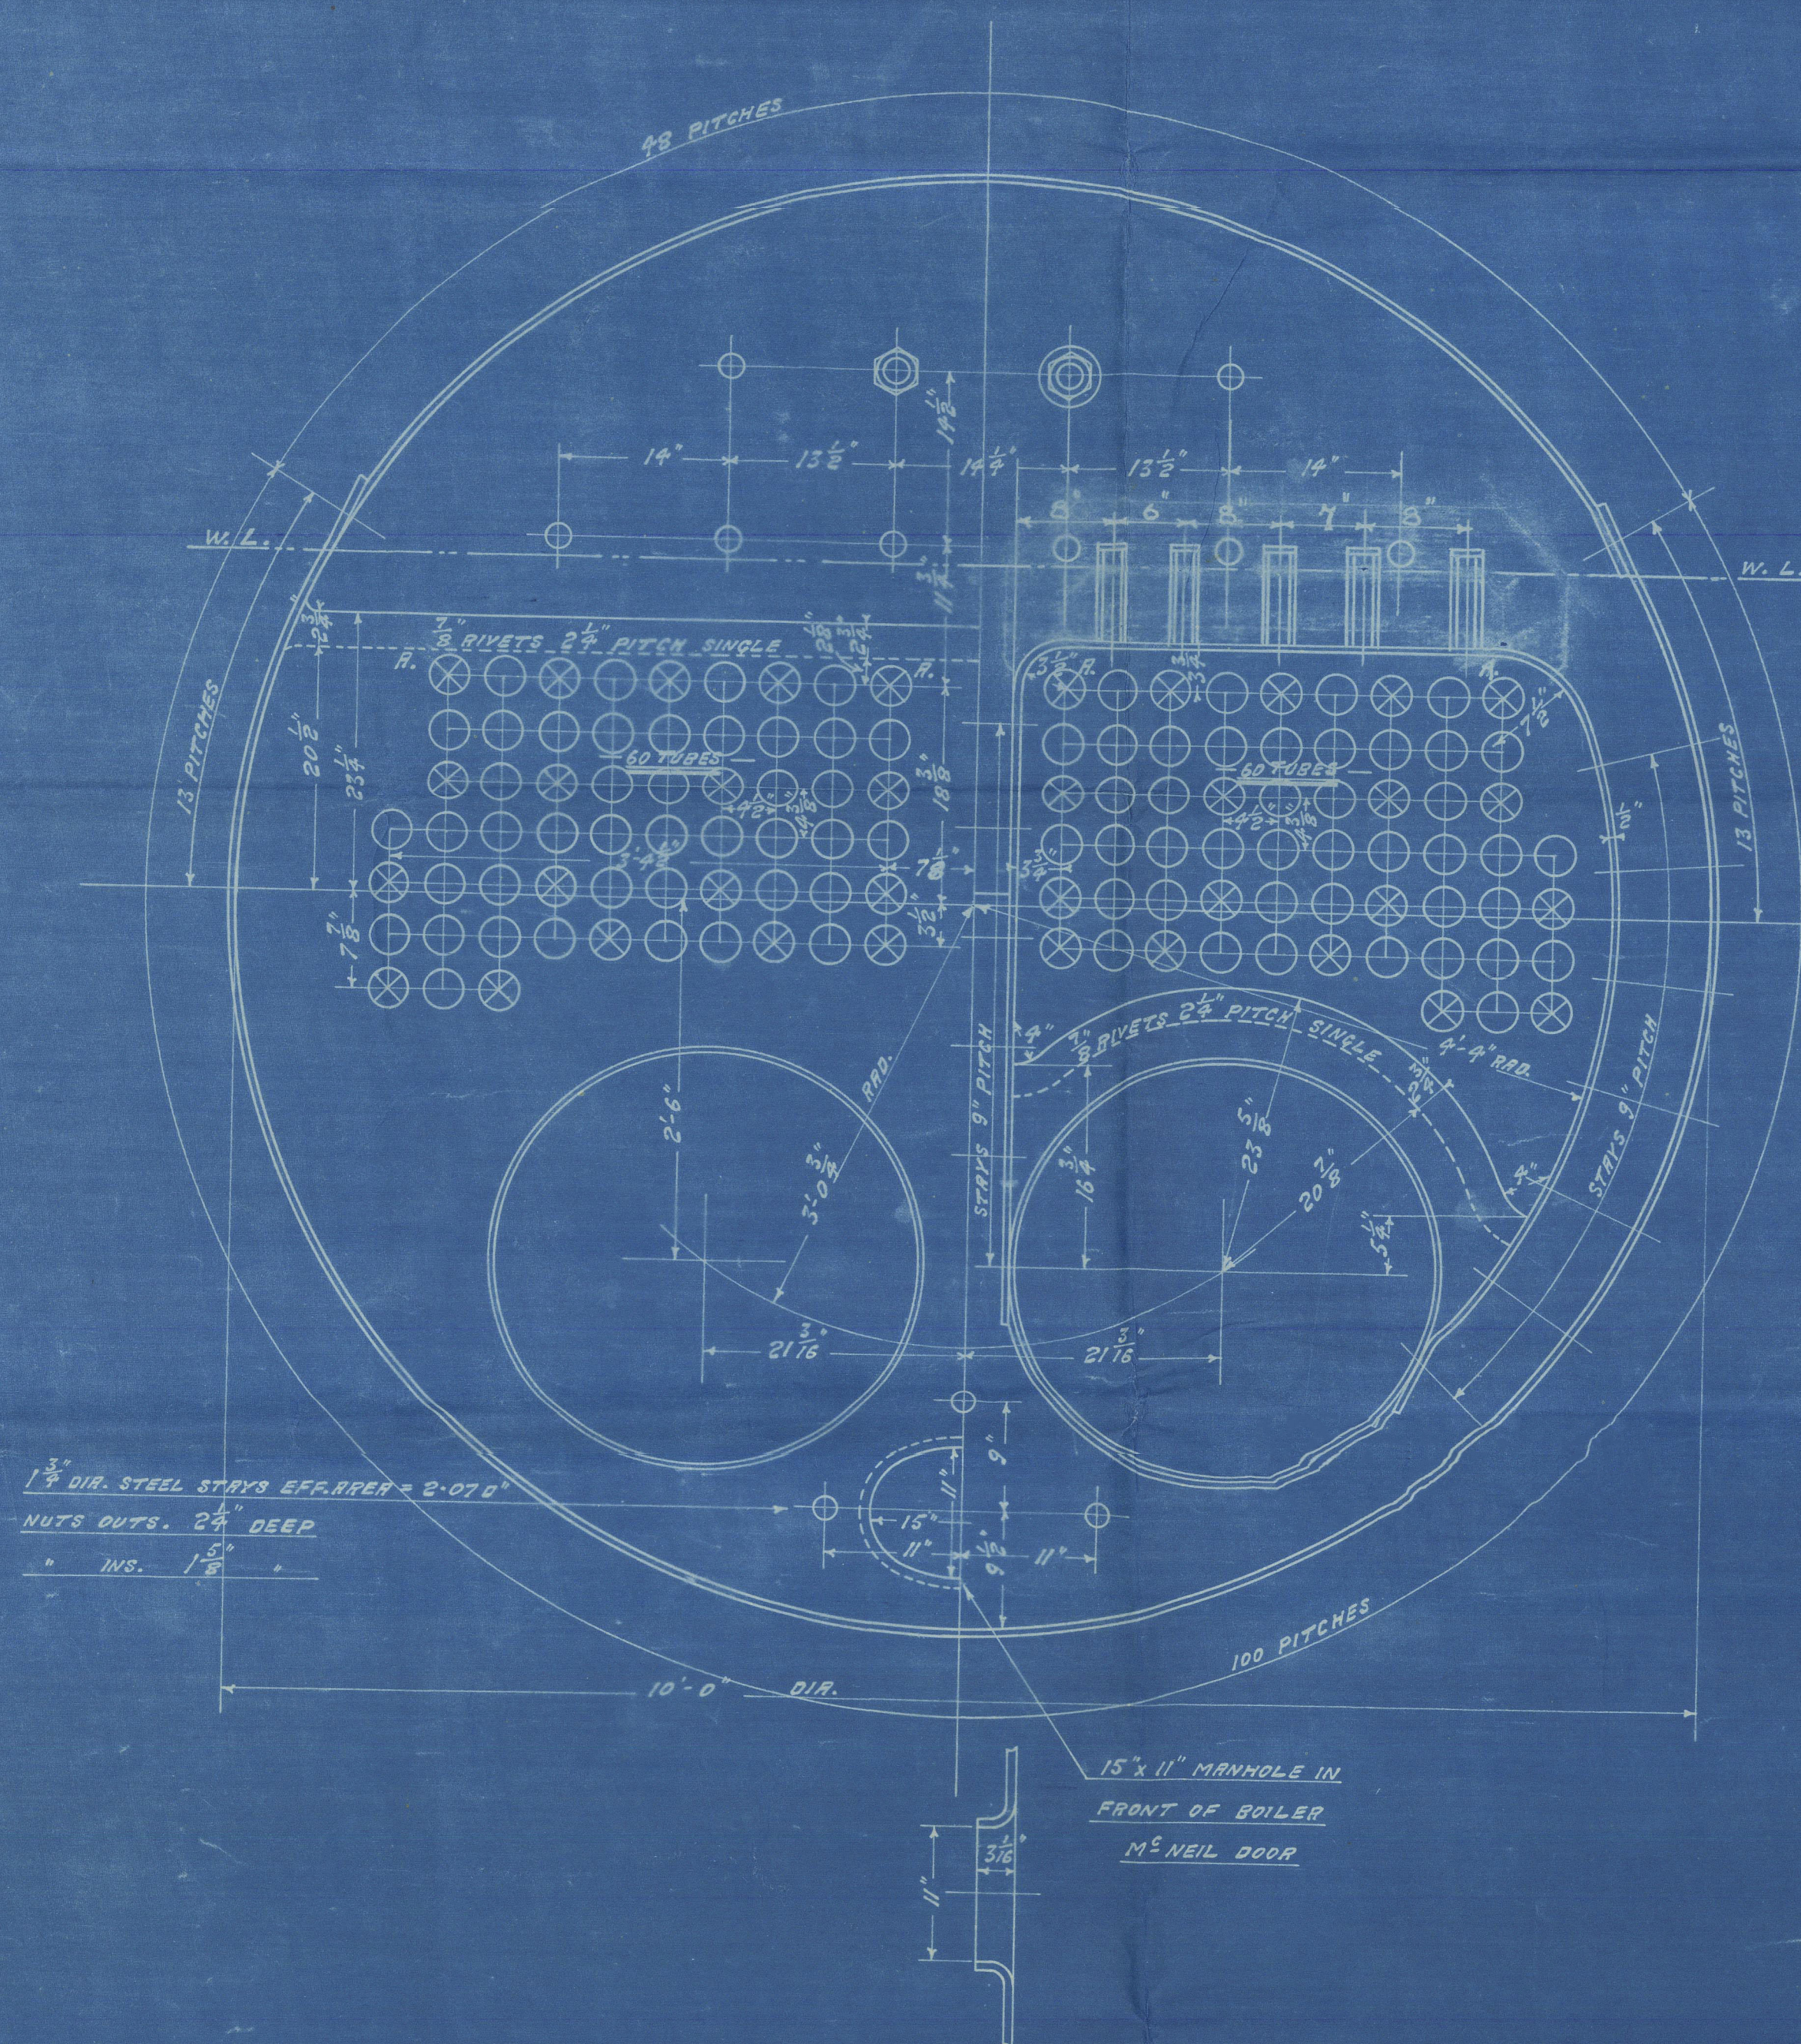

# DONKEY BOILER

FOR  
CONTRACT NOS 446-447

ONE OFF FOR EACH CONTRACT NUMBER

WORKING PRESSURE 100 LBS. PER SQ. IN.

UNDER BOARD OF TRADE & LLOYD'S SURVEYS

SCALES 1/4" 1/8" = ONE FOOT



O.T. 6417

TRIP NO 2013

TRIP NO 2013

Lloyd's Register Foundation



From DAVID ROWAN & CO., GLASGOW.

ENCLOSURE

FOR

*Messrs Floyds Surveyors.*

D. Rowan & Co.


D.B. No. 446/7

S.S. "Lewiston"

Glasgow report No. 24280.

S.S. "Tantaron"

Glasgow report No. 24520

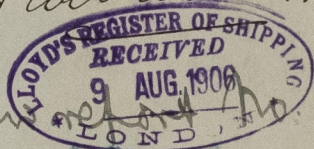

RETAIN



© 2021

Lloyd's Register  
Foundation

W1622-0092