



23.11.04
6.12.04
(10.144) 15.12.04

PROFILE.

S.S. 325-0' x 47-0' x 24-10' (TO SPAR DECK.)

SCALE 1" = ONE FOOT.

S.S. NO. 141 & 23, 4

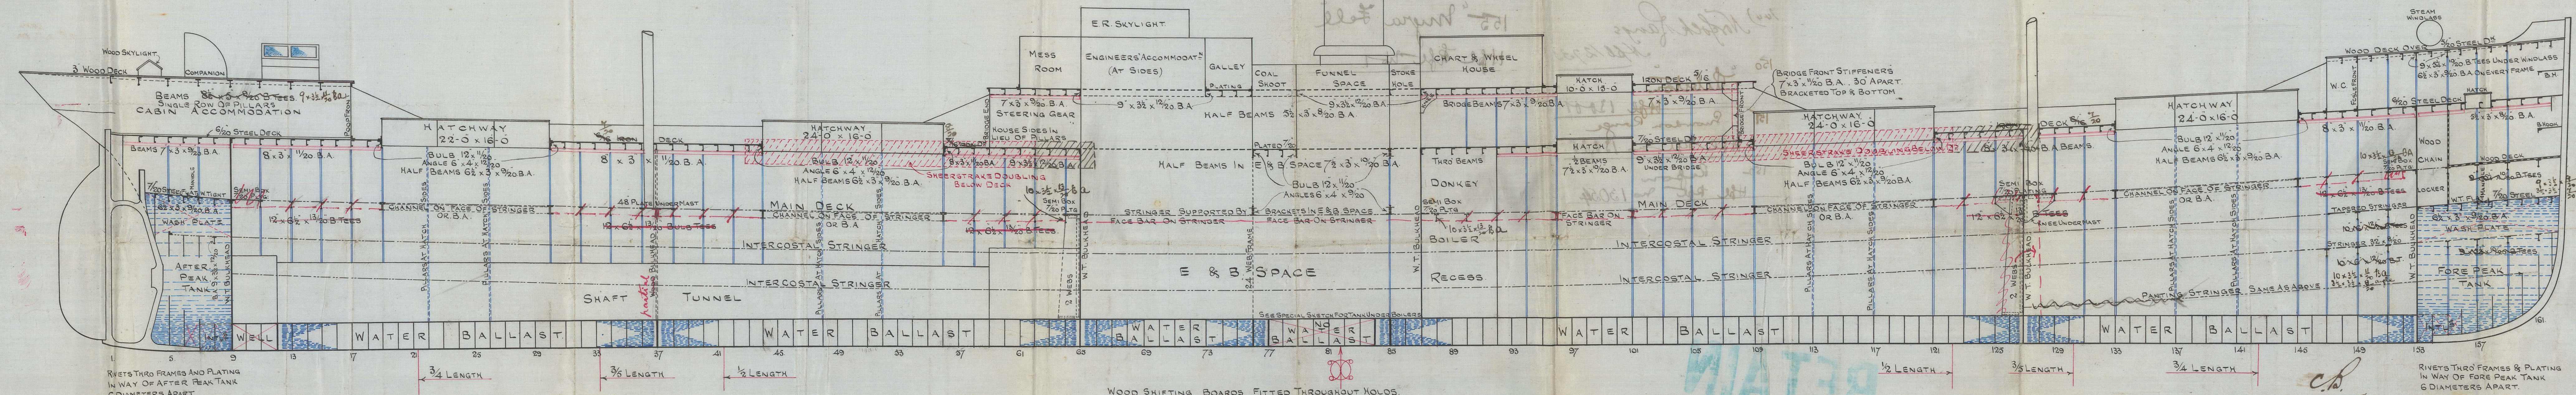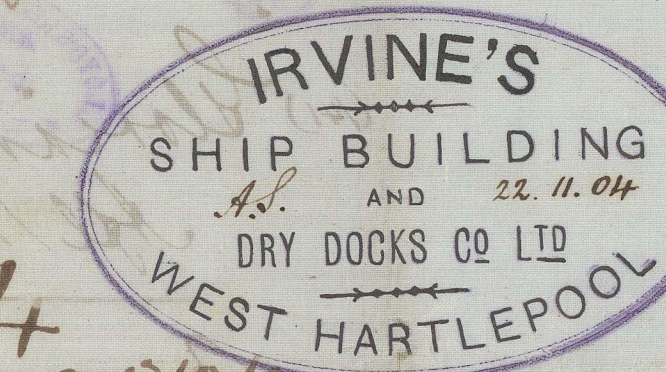

23.11.04

Irvin's PB. & Co. Ltd

Nos 141. 2 143 & 144, 150, 151, 152, 153, 154,

Profile

155, ~~156, 157, 158~~
Cancelled 30/5/06

(141) *Clorina*

Age 13 1/2

153 *Mande*

Hpl Rpt no 13111

(142) *Cameron* Age 12 1/2

154 *Linda Fell*

Hpl Rpt no 13135

(144) *Norfolk Range*

Age 12 1/2

155 *Myra Fell*

Hpl Rpt no 1

150

Libston

Age 13 0 1

151

Snordon Range

Hpl Rpt no 13125

152

Ripon

Hpl Rpt no 13054

RETAIN



© 2021

Lloyd's Register
Foundation

W1623-0251