


Enquiry No. 1126.  
 also No. 770 (app'd 27.6.05)  
 No. 761 Ships.

Section showing Proposed Amended Arrangement of Shell Plating.

Scale 1/2" = 1 Foot.

29.12.04  
 27.6.05 (No. 770)

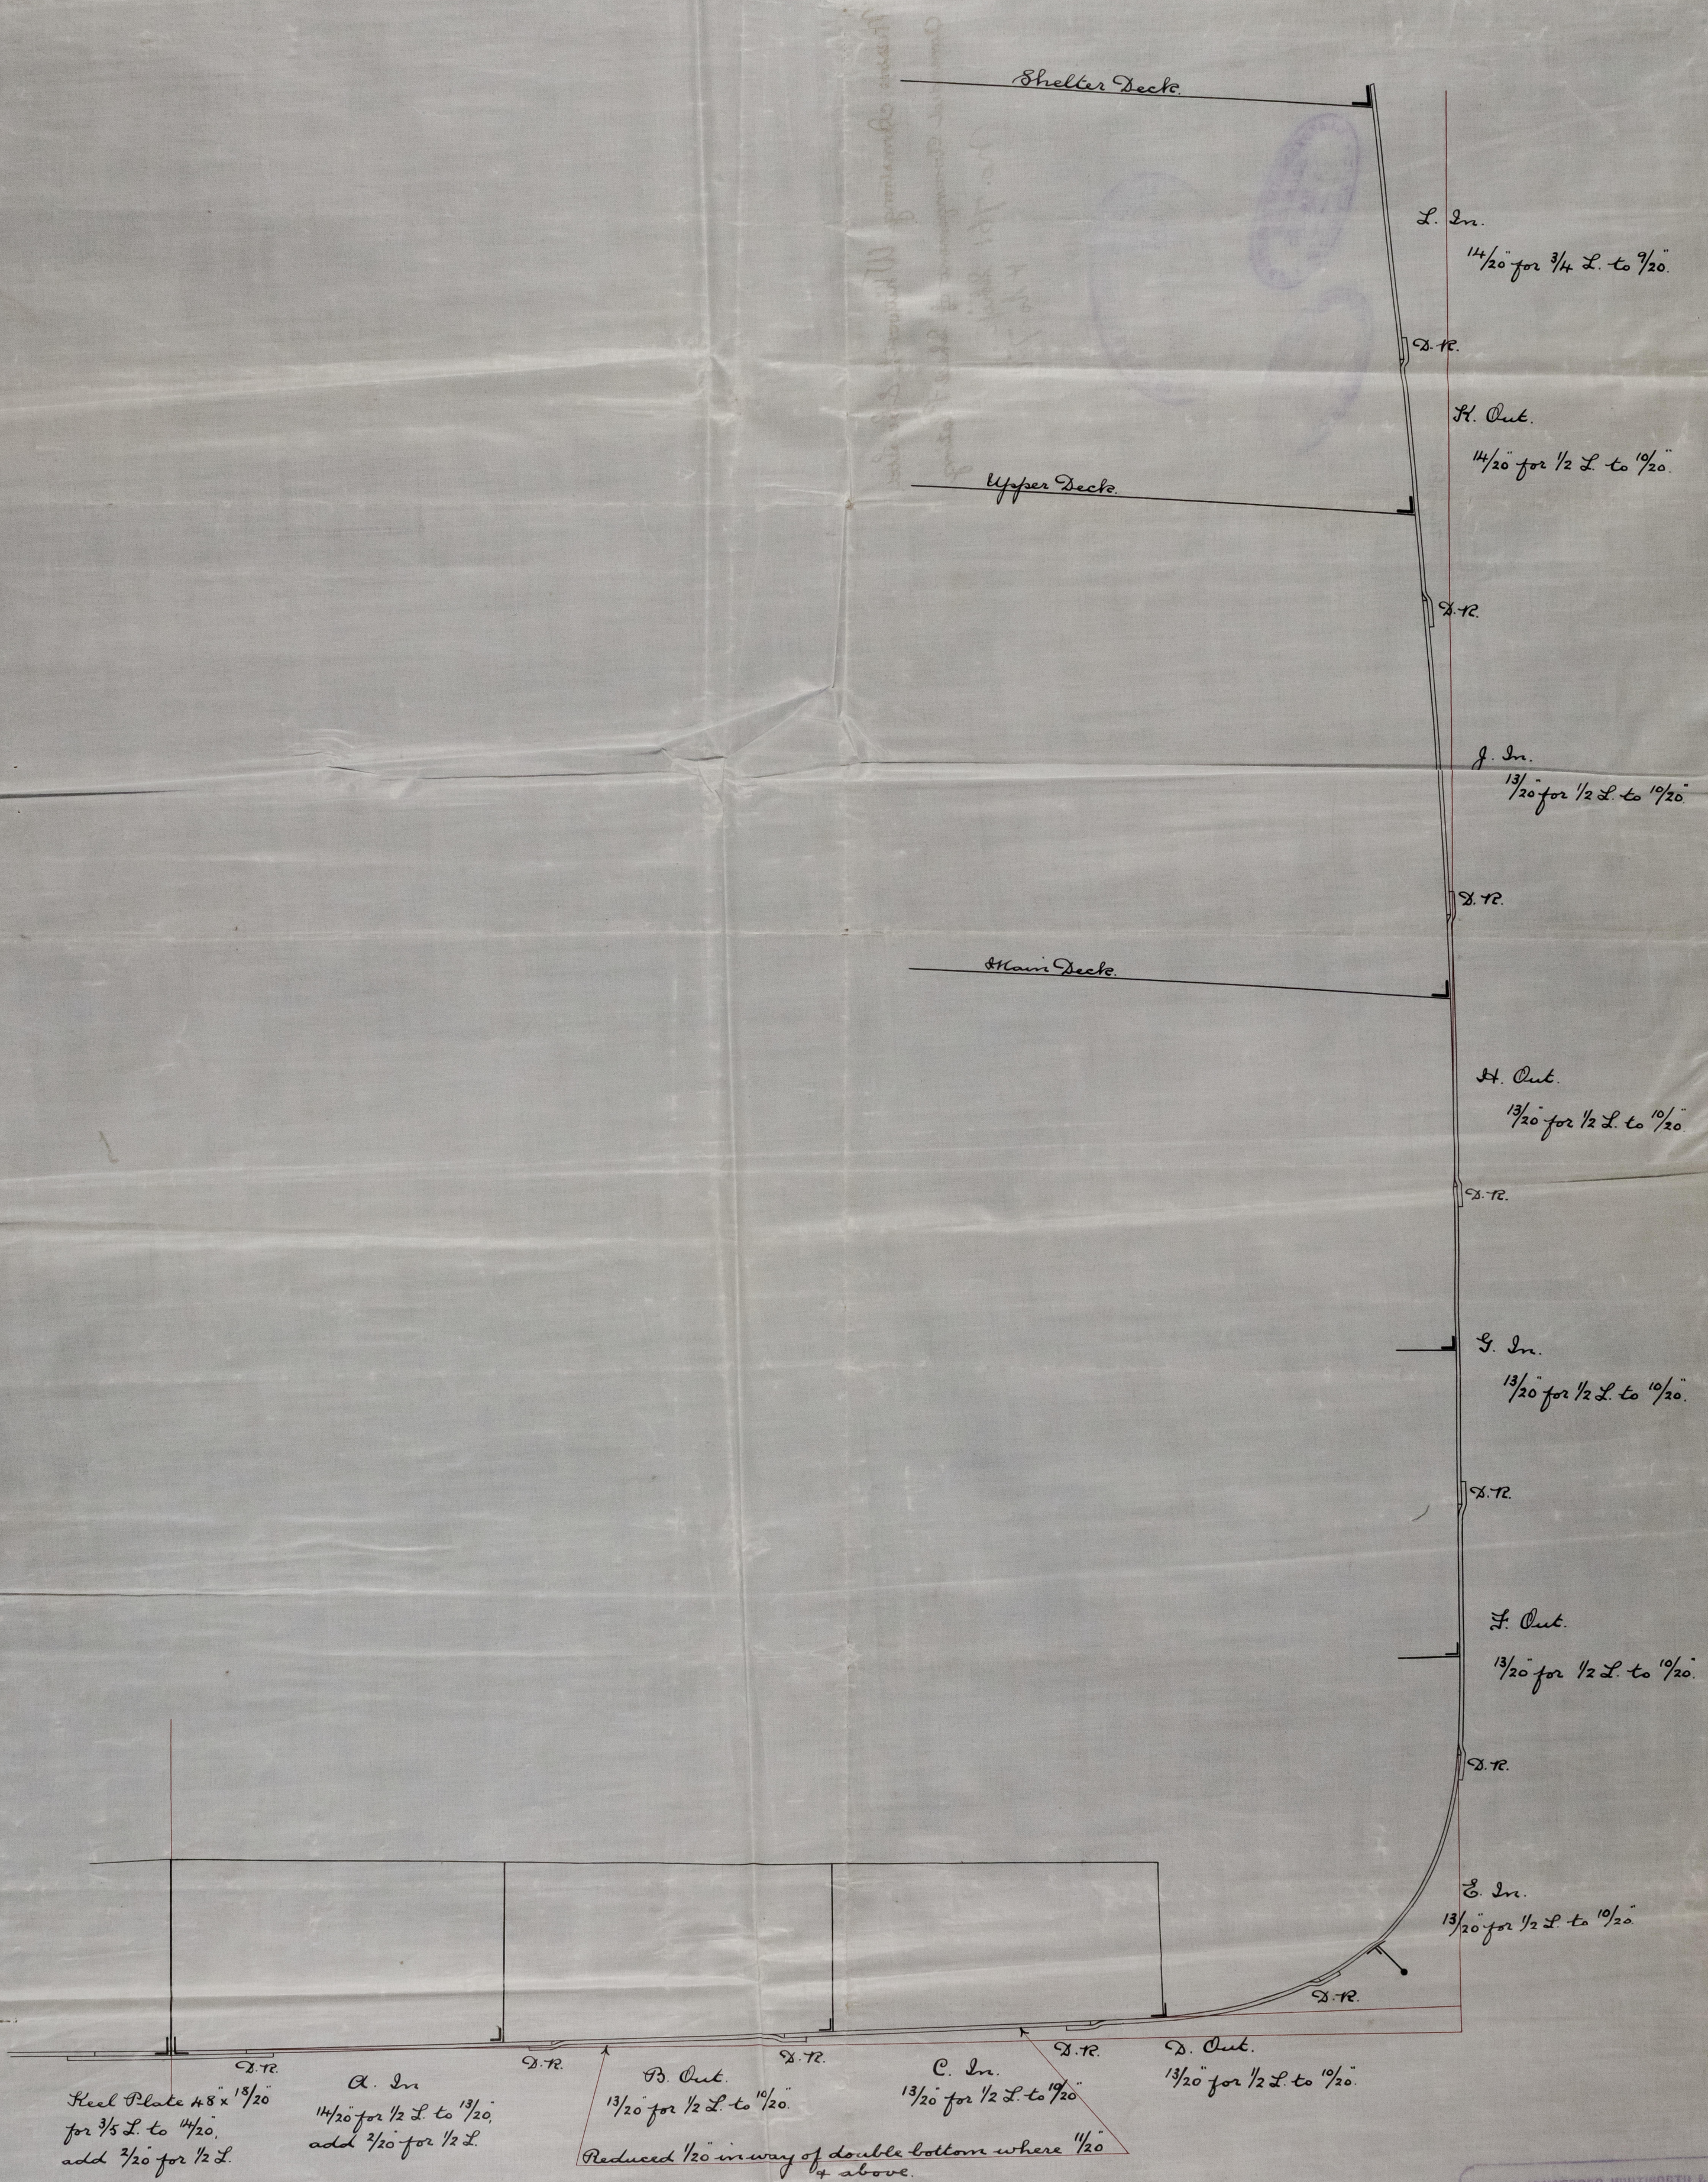

B. & C. Strakes midship thickness to be maintained  
 fwd. to collision bulkhead.

29/12/04

Sir W. G. ARMSTRONG, WHITWORTH & CO. Limited.  
 NEWCASTLE-ON-TYNE.  
 No. 5345 DATE 21/12/04.  
 WALKER SHIPYARD Register  
 Foundation C.W.




Messrs. Armstrong Whitworth & Co. Ltd.  
Amended Arrangement of Shell Plating.  
No. 761 Ship.  
4 to 770

about 1840

3726  
D. 26


28  
29

$\frac{7}{4}$   
 $\frac{10}{7}$   




25. 6.

of

10/10/10

25

Handwritten: 40

$\frac{1}{2}$   
