




SHIP No 285 & 6

No 681 DESIGN.

31.1.00 AMENDED MIDSHIP SECTION FOR TURRET STEAMER.

20.3.00

SCALE. $\frac{1}{2}$ = 1 FOOT


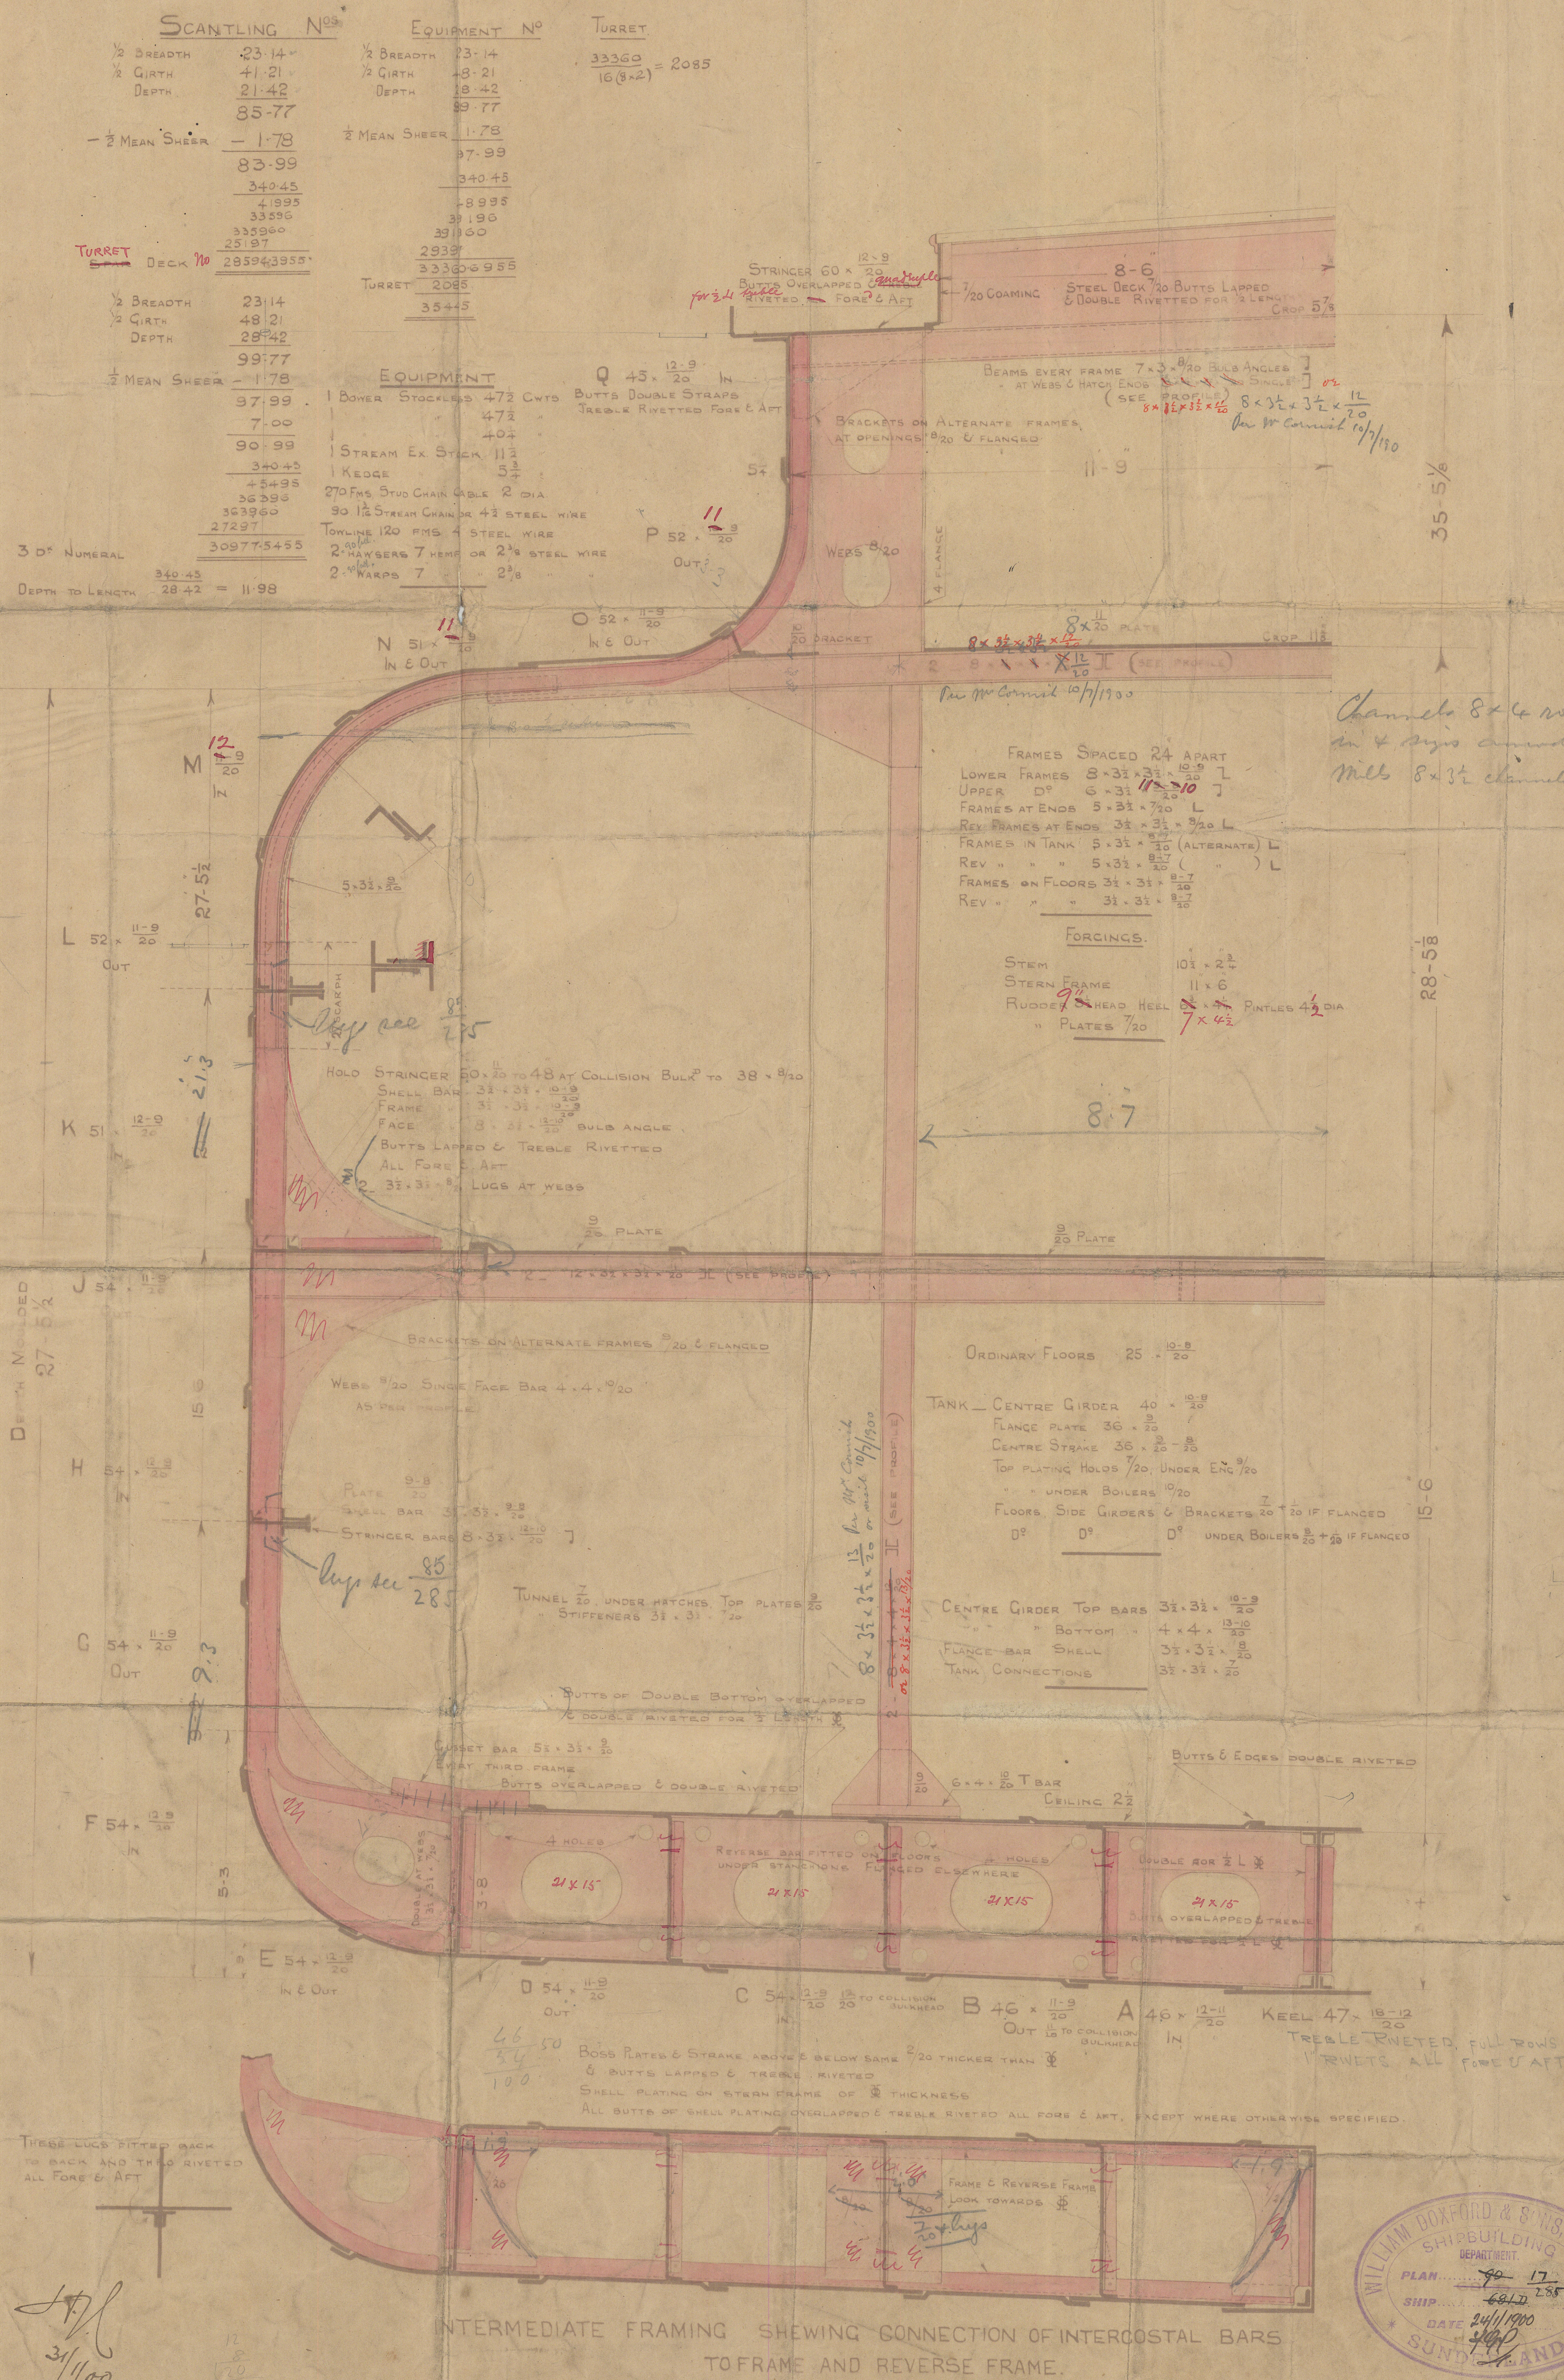


Midship Section No. 2896.

H. Dwyer & Co. Ltd.

S. S. "Cheltenham"


London No. 20455

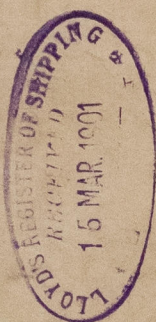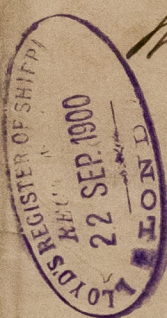


*Water gauge
at here
sea 20471*

W1623-07386

RETAIN

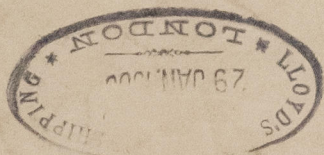

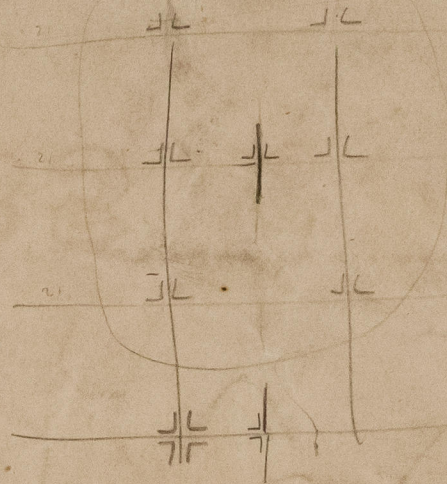

7
+

W1623-0386



© 2021
Lloyd's Register
Foundation