

31.1.00
20.5.00


SHIP No 285 & 6

DESIGN No 681.

AMENDED SECTIONAL ELEVATION & DECK PLANS

SHOWING METHOD OF CONSTRUCTION FOR
TURRET DECK STEAMER

342-3 BP x 46-6 EXT x 27-5 1/2 MP.

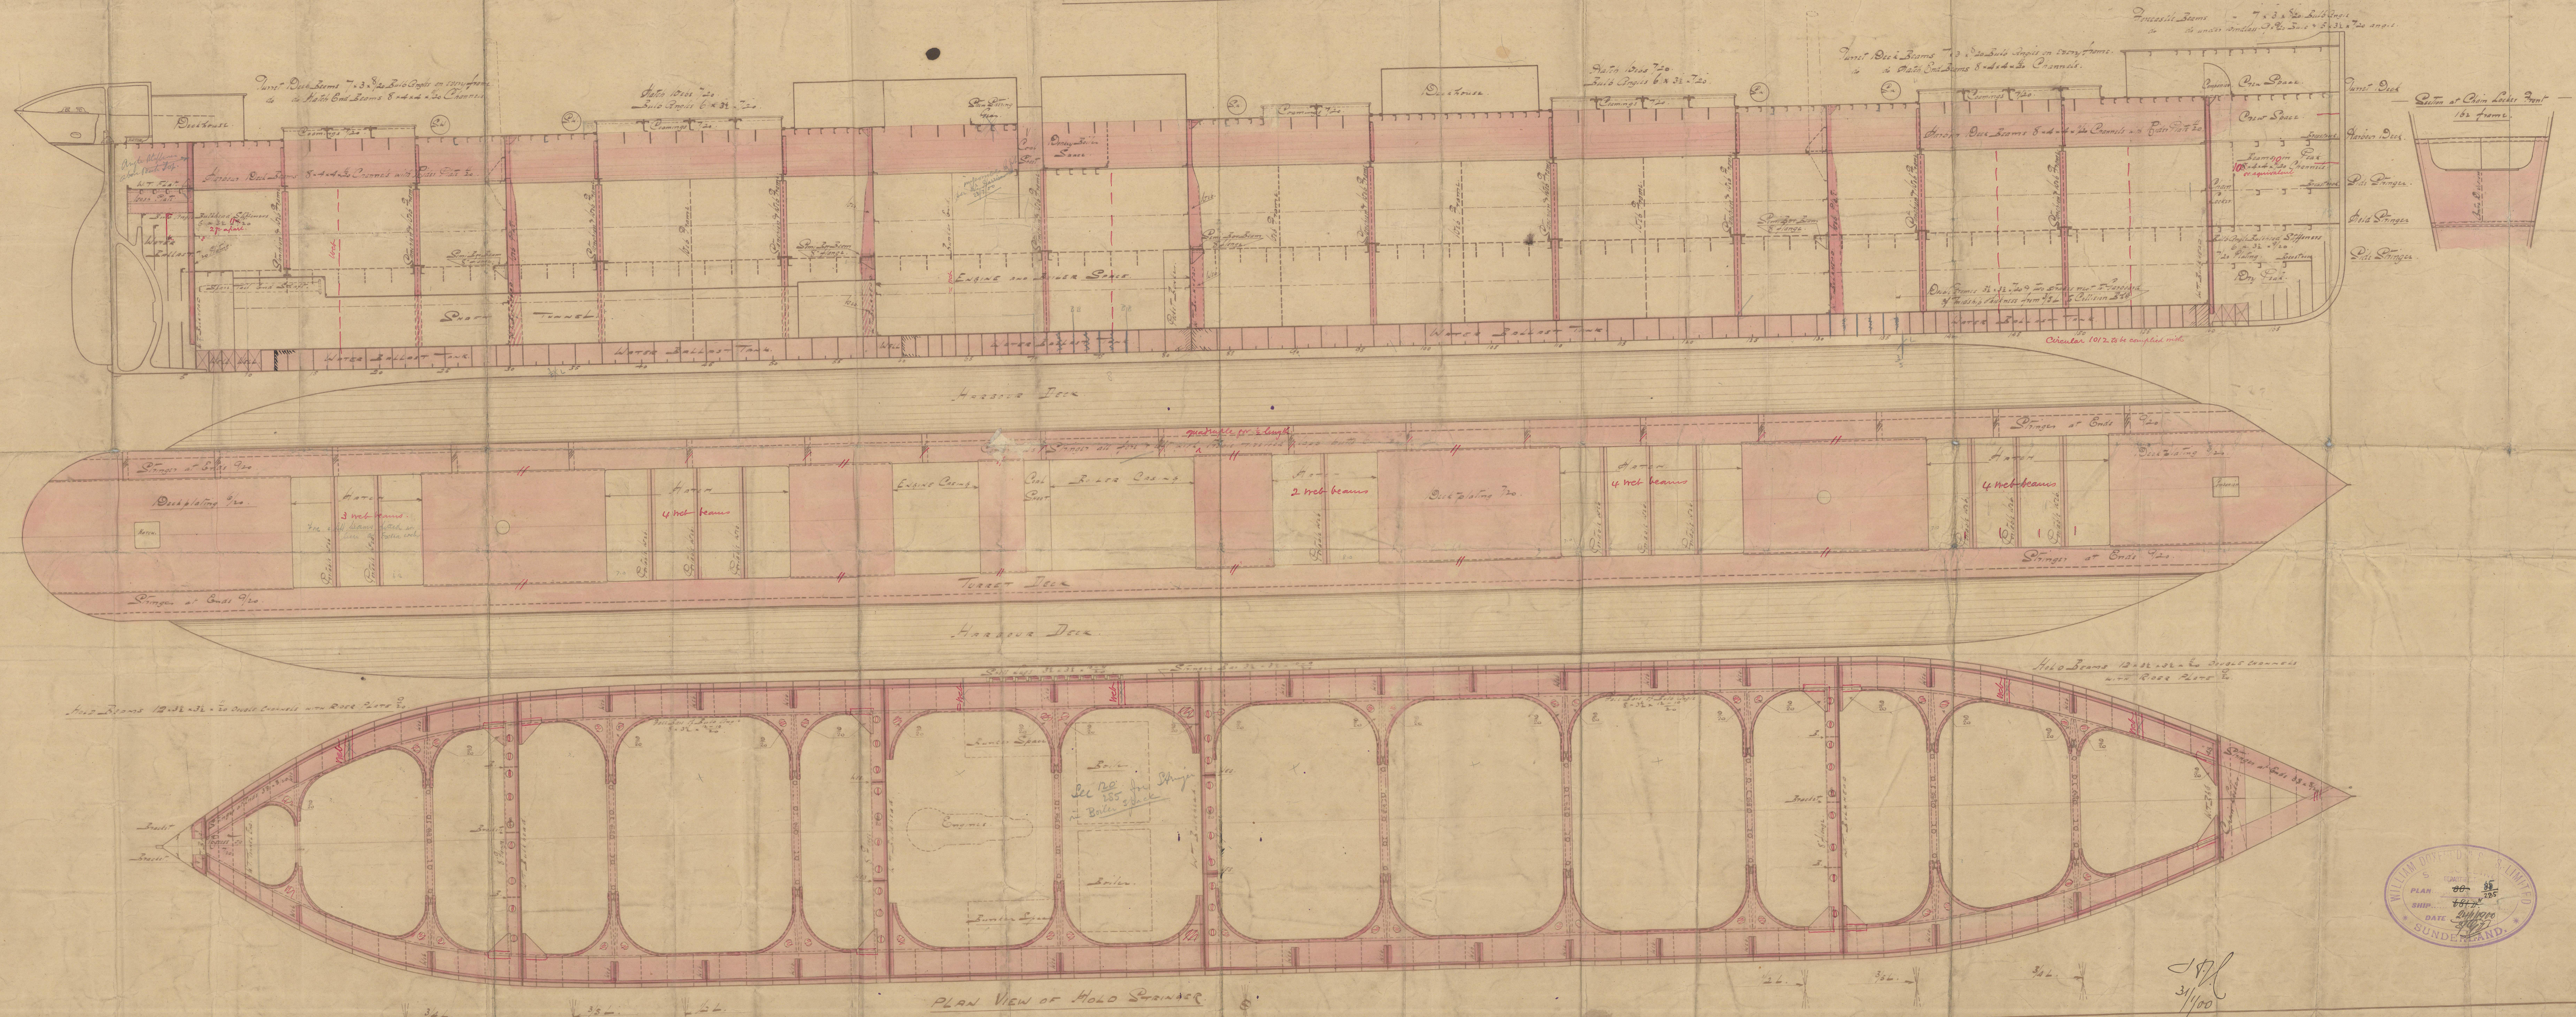

Profile & D. Plans.

R. Doxford & Son L^d

S/S. N^o 28576.

S. S. "Cheltenham"

Gundaham N^o 20455



S. S. Nereus

S/S. 20471



© 2021

Lloyd's Register
Foundation

W1623-0387



© 2021

Lloyd's Register
Foundation