


SINGLE SCREW STEAMER.
STEELWORK PROFILE AND DECK PLAN.

DIMENSIONS 135.0" B.P. - 24.0" - 10' S M.L.D.

SCALE $\frac{1}{4}" = \text{ONE FOOT.}$

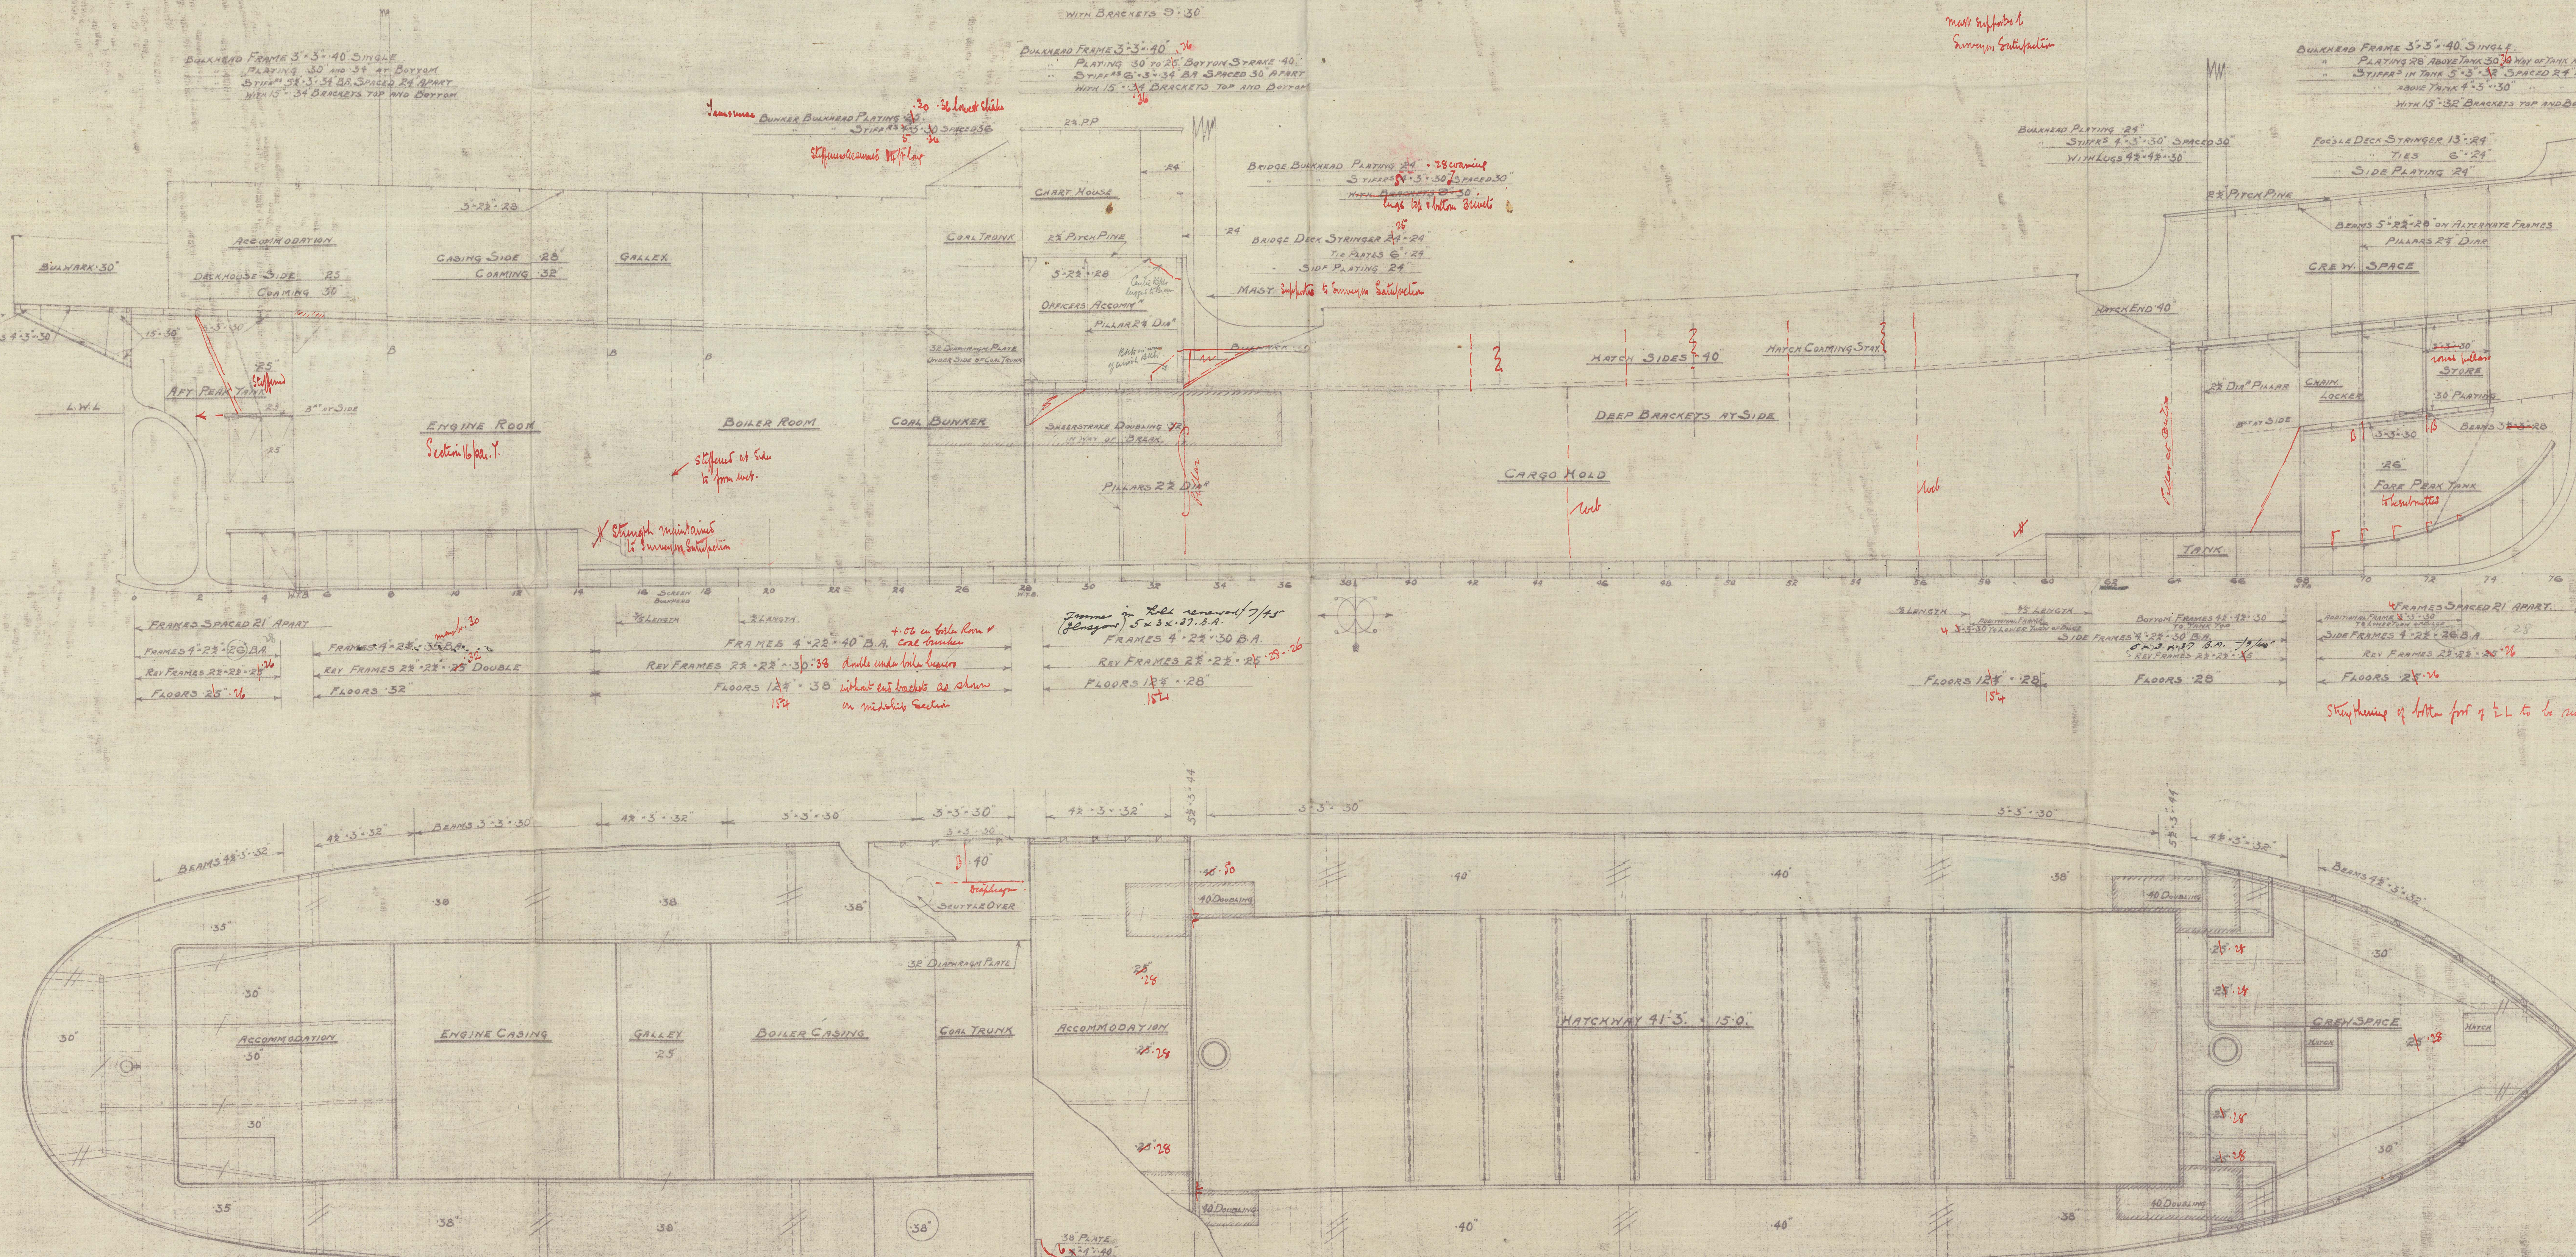

APPROVED
LLOYD'S REGISTER OF SHIPPING



Bow McLachlan & Co
Profile & Deck Plan
No. 414.

"CROMARTY FIRTH."

n. n.

Cragman.

GLASGOW REPORT No.

43999

© 2021

Lloyd's Register
Foundation

W1624-0029