

5. 2.14
16. 9. 14

18	
20.58	TRANSVERSE N°
58	
12348	
10290	
115248	LONG N°


DEPTHS TO LENGTH	$\frac{56}{2.58}$
	= 21.7 DEPTHS
BREADTHS TO LENGTH	$\frac{56}{18}$
	= 3.1 BREADTHS.

MIDSHIP SECTION

STEAM FERRY DIMENSIONS 56'0" x 18'0" x 2'7" MLD.

TO CLASS 'A' AT LLOYDS FOR "FERRY PURPOSES ONLY" ON LAKE WINDERMERE.

SCALE $\frac{3}{4}$ " = 1 FOOT.

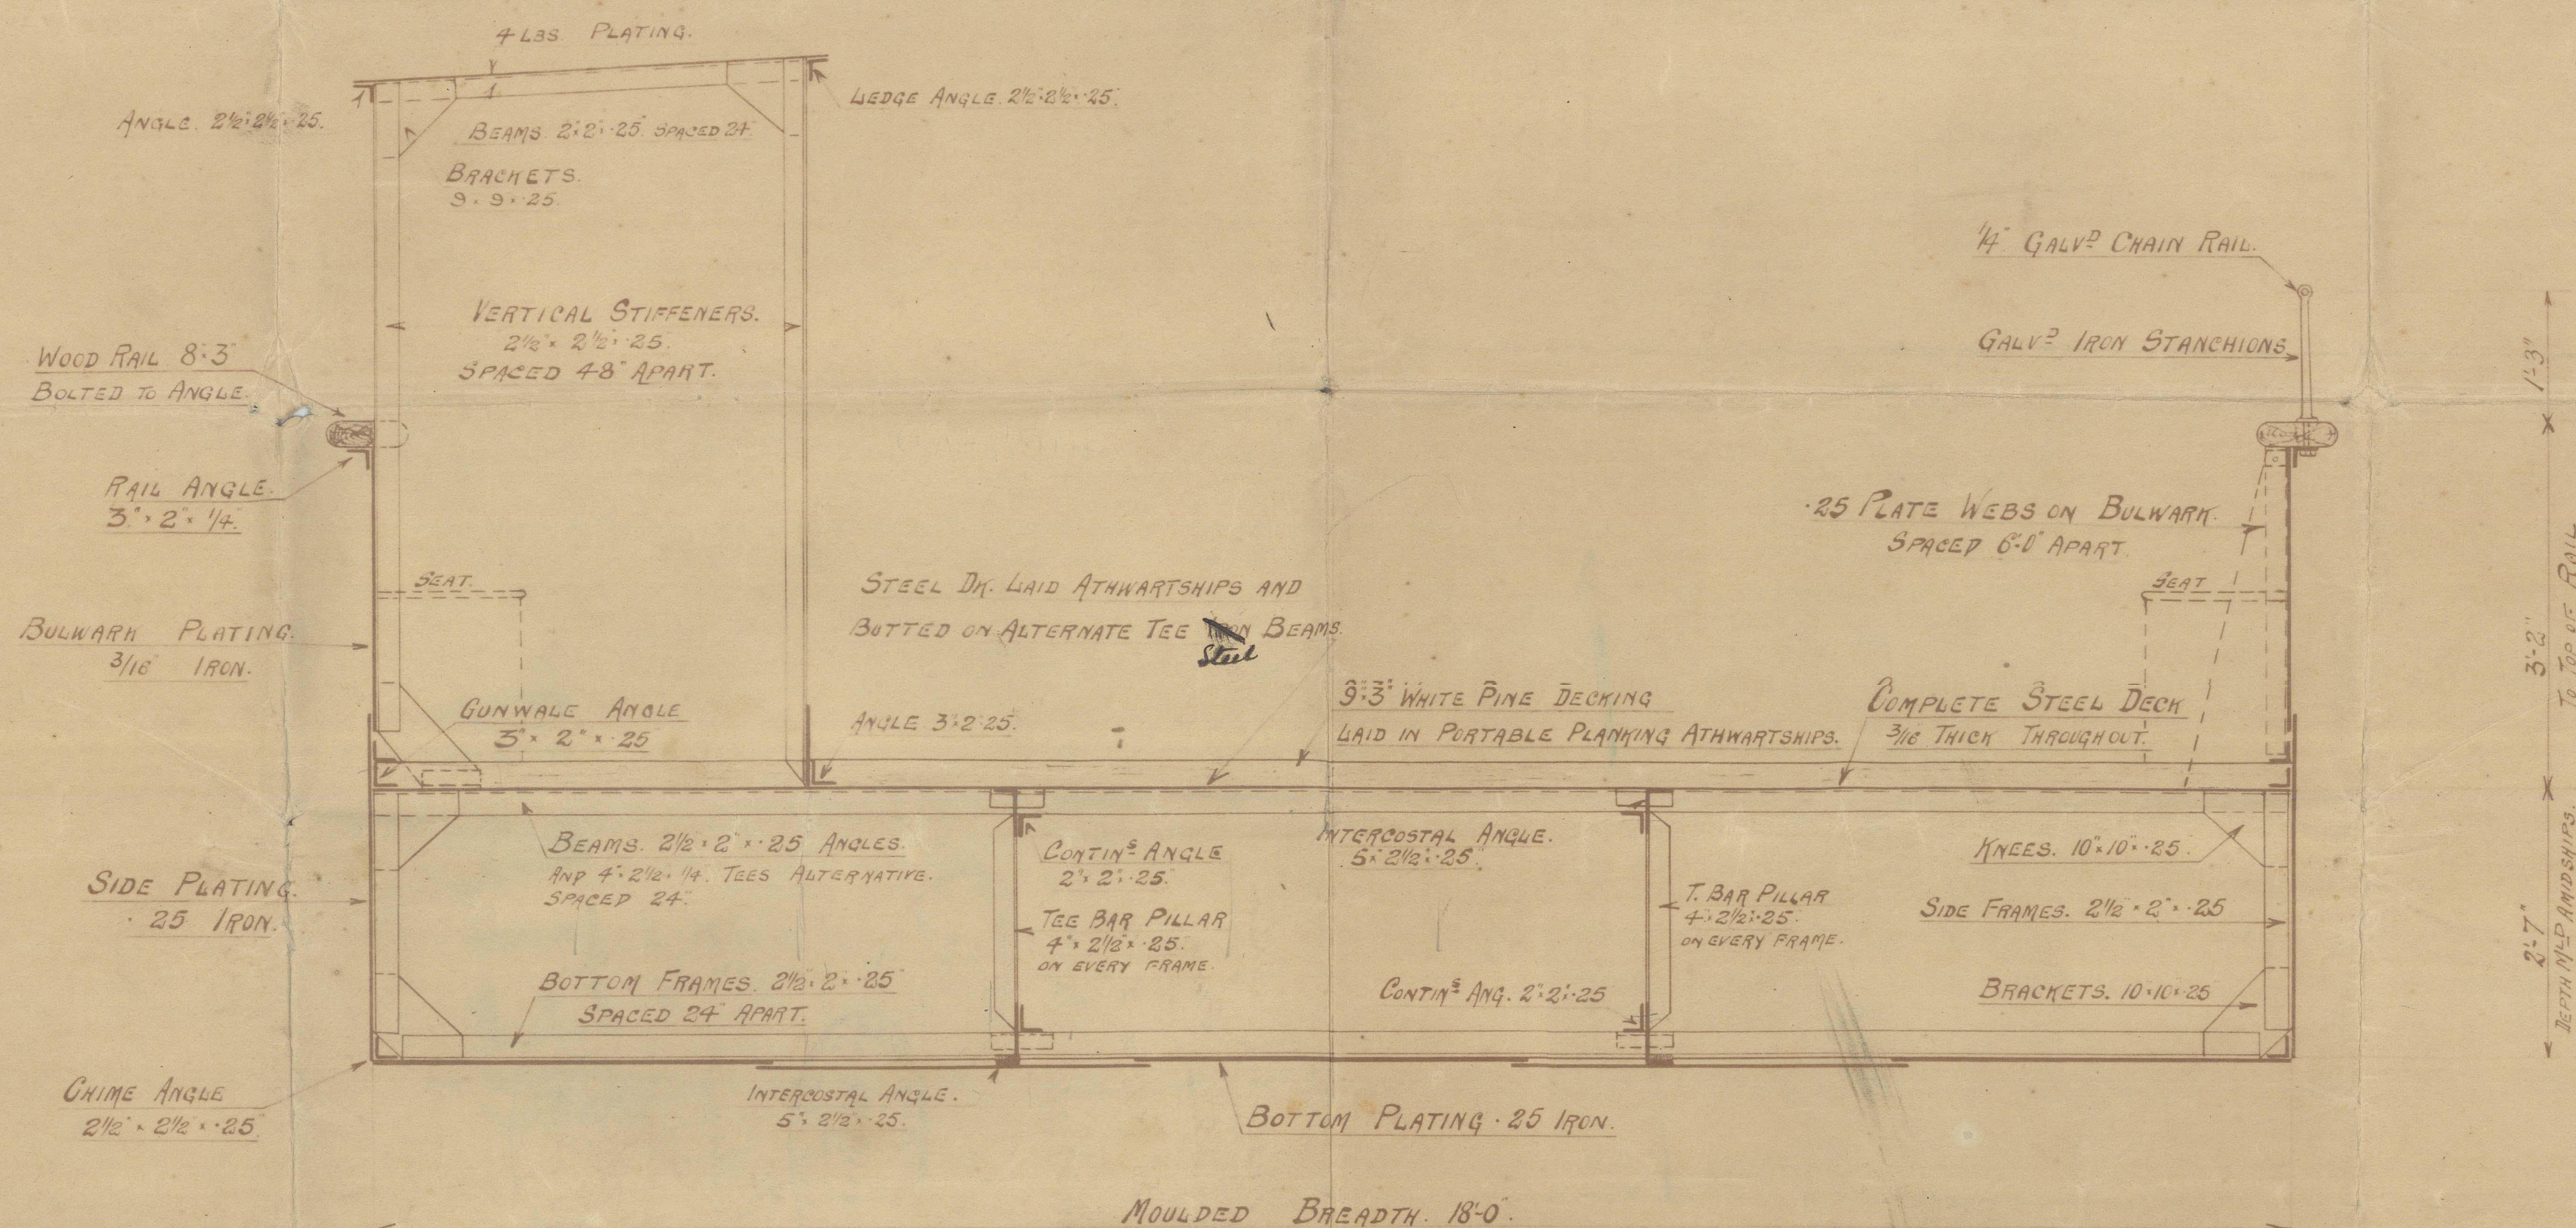

RIVETING

SHELL LANDINGS OVERLAPPED & SINGLE RIVETED 2" LANDINGS 1/2" RIVETS 2" PITCH.
 BUTT " " DOUBLE " BUTTS 1/2" " 2" "
 FRAMES TO SHELL 1/2" RIVETS 3 1/2" PITCH.
 GUNWALE & CHIME ANGLES 1/2" RIVETS 2" PITCH ON BOTH FLANGES.
 RIVETING GENERALLY 1/2" DIA.

C.F.
5. 2. 14




N^o 527
Melshup Section


Steam Ferry.

56' x 18 x 2'-7'



Med-alley - McKenna

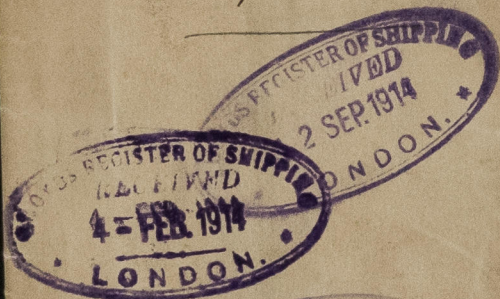

Wundersee Ferry
- Gls. 33960

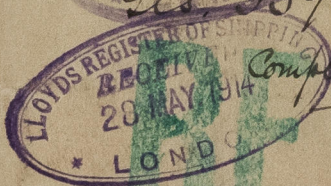

Completed at Barrow on same report.

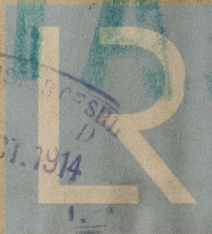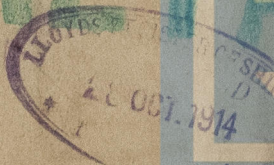

© 2021

Lloyd's Register
Foundation

W1624-0117