


N^os 523-4.
 DETAIL OF STEAM DRUM.
 FULL SIZE.


N^o 174

| SUBMITTED TO | DATE |
|-----------------|-------|
| PER LETTER | DATED |
| APPD PER LETTER | DATE |
| SENT TO | DATE |
| | |
| | |
| | |
| | |
| | |
| | |

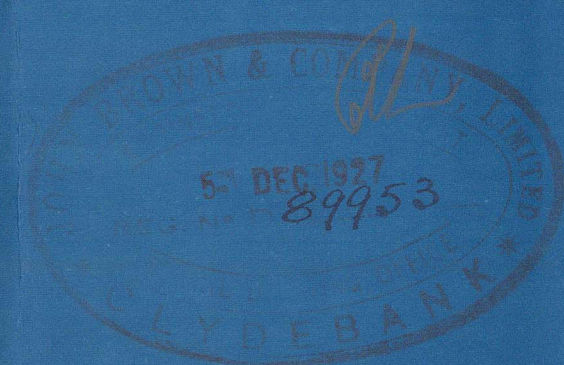

102 255 - 1 BELT OF STEAM DRUM D N S

NOTE: ALL SHARP EDGES TO BE TAKEN OFF.
 HOLES IN TUBE PLATE, ON OUTSIDE OF PLATE.

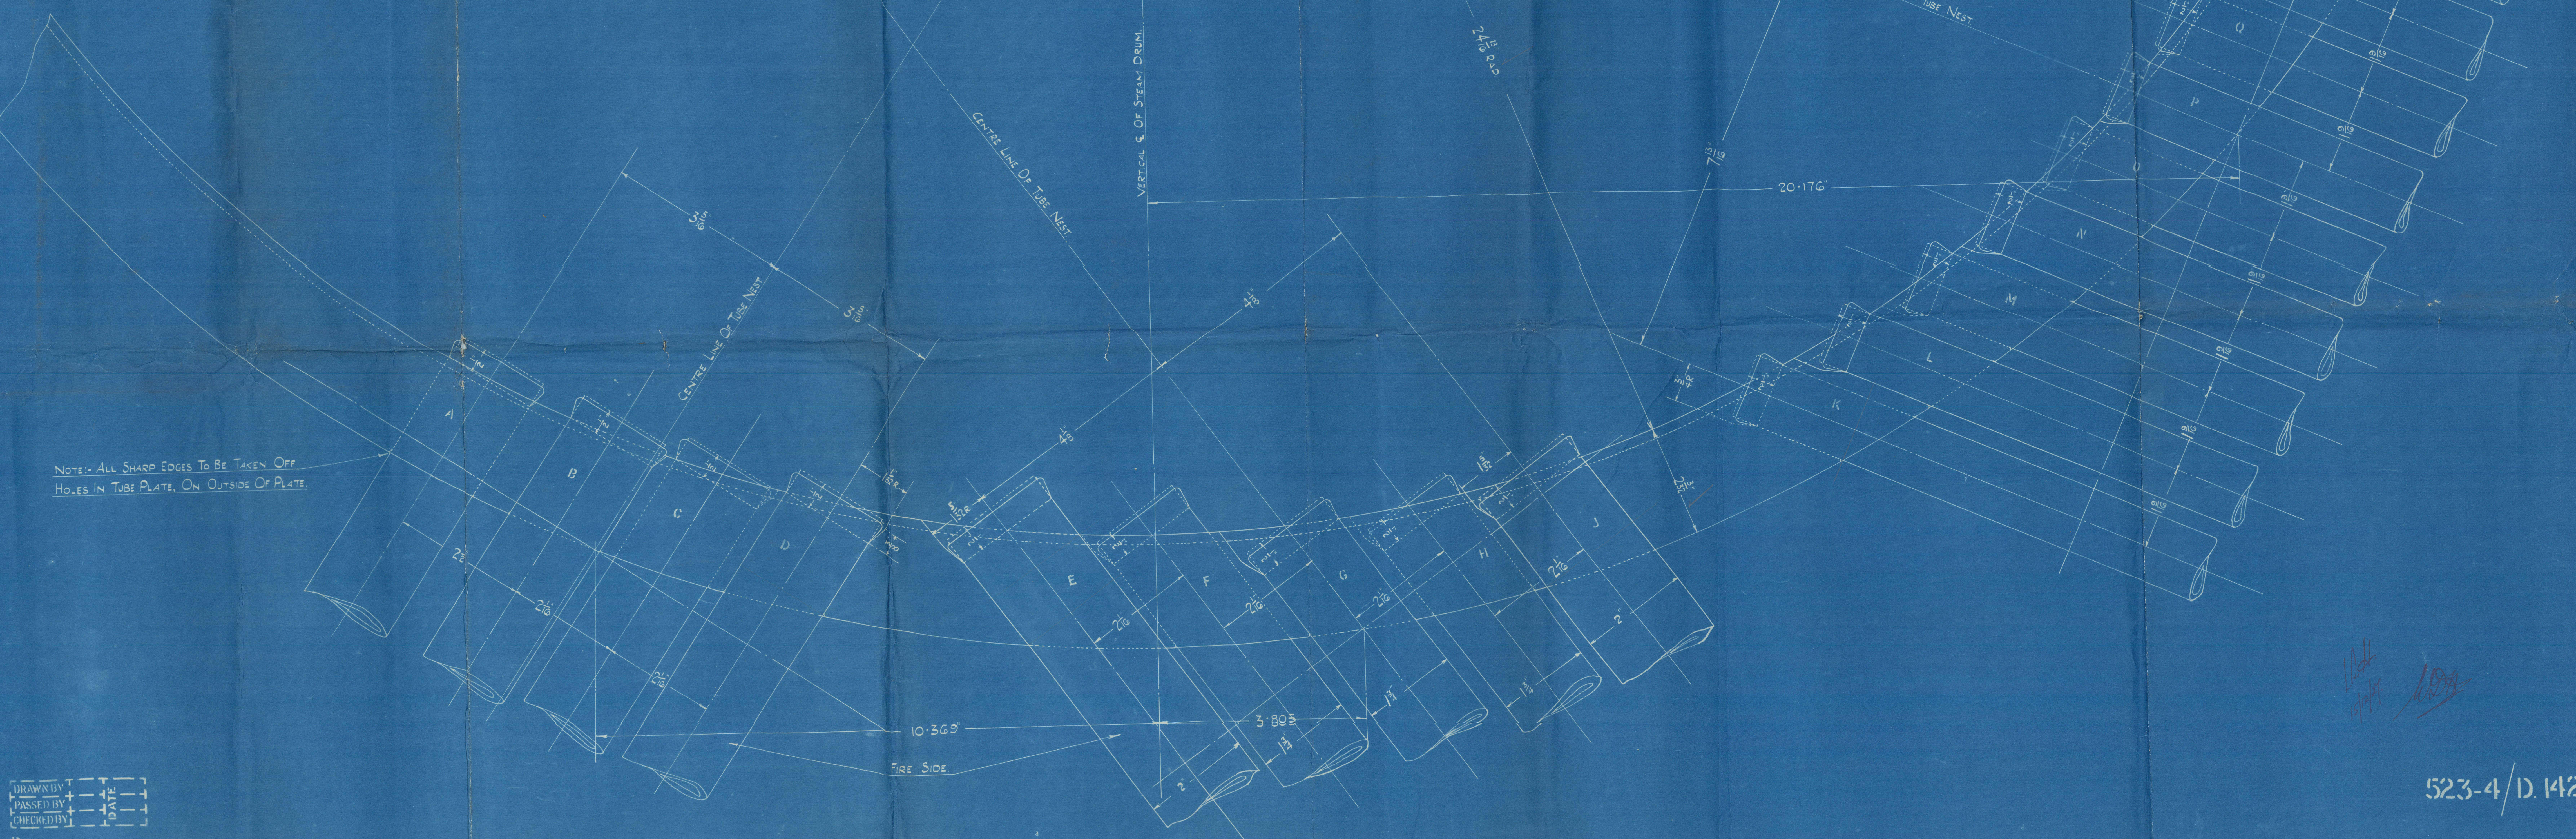

| | | |
|------------|--|------|
| DRAWN BY | | DATE |
| PASSED BY | | |
| CHECKED BY | | |
| B. | | |

523-4/D. 142.

N^o 523-4

Steam drum.

| N ^o 523 | Superheaters. | N ^o 524 | Superheaters |
|--|--|--|--|
| <p>N^o 17811 Lloyds list 605 lbs W.P. 370 " J.S.C. 8-3-28.</p> | <p>N^o 17811 Lloyds list 605 lbs W.P. 370 " J.S.C. 15-3-28</p> | <p>N^o 17923 Lloyds list 605 lbs W.P. 370 " J.S.C. 31-5-28</p> | <p>N^o 17923 Lloyds list 605 lbs W.P. 370 " J.S.C. 31-5-28</p> |
| <p>N^o 17822 Lloyds list 605 lbs W.P. 370 " J.S.C. 15-3-28</p> | <p>N^o 17822 Lloyds list 605 lbs W.P. 370 " J.S.C. 20-3-28</p> | <p>N^o 17928 Lloyds list 605 lbs W.P. 370 " A.C. 7-6-28</p> | <p>N^o 17928 Lloyds list 605 lbs W.P. 370 " A.C. 7-6-28</p> |
| <p>N^o 17842 Lloyds list 605 lbs W.P. 370 " J.S.C. 29-3-28</p> | <p>N^o 17842 Lloyds list 605 lbs W.P. 370 " J.S.C. 29-3-28</p> | <p>N^o 17941 Lloyds list 605 lbs W.P. 370 " J.S.C. 21-6-28</p> | <p>N^o 17941 Lloyds list 605 lbs W.P. 370 " J.S.C. 21-6-28</p> |
| <p>N^o 17851 Lloyds list 605 lbs W.P. 370 " J.S.C. 5-4-28</p> | <p>N^o 17851 Lloyds list 605 lbs W.P. 370 " J.S.C. 5-4-28</p> | <p>N^o 17953 Lloyds list 605 lbs W.P. 370 " J.S.C. 28-6-28</p> | <p>N^o 17953 Lloyds list 605 lbs W.P. 370 " J.S.C. 28-6-28</p> |
| <p>N^o 17869 Lloyds list 605 lbs W.P. 370 " J.S.C. 19-4-28</p> | <p>N^o 17869 Lloyds list 605 lbs W.P. 370 " J.S.C. 19-4-28</p> | <p>N^o 17970 Lloyds list 605 lbs W.P. 370 " J.S.C. 26-7-28</p> | <p>N^o 17970 Lloyds list 605 lbs W.P. 370 " J.S.C. 1-8-28</p> |
| <p>N^o 17895 Lloyds list 605 lbs W.P. 370 " J.S.C. 1-5-28</p> | <p>N^o 17895 Lloyds list 605 lbs W.P. 370 " J.S.C. 1-5-28</p> | <p>N^o 18011 Lloyds list 605 lbs W.P. 370 " J.S.C. 10-8-28</p> | |

Duchess of Richmond

GLASGOW REPORT No 48696

Duchess of York.

GLASGOW REPORT No 48940.

