




— SCALE $\frac{1}{8}" = \text{ONE FOOT.}$ —

SCALE $\frac{1}{2}$ = 1 FOOT.

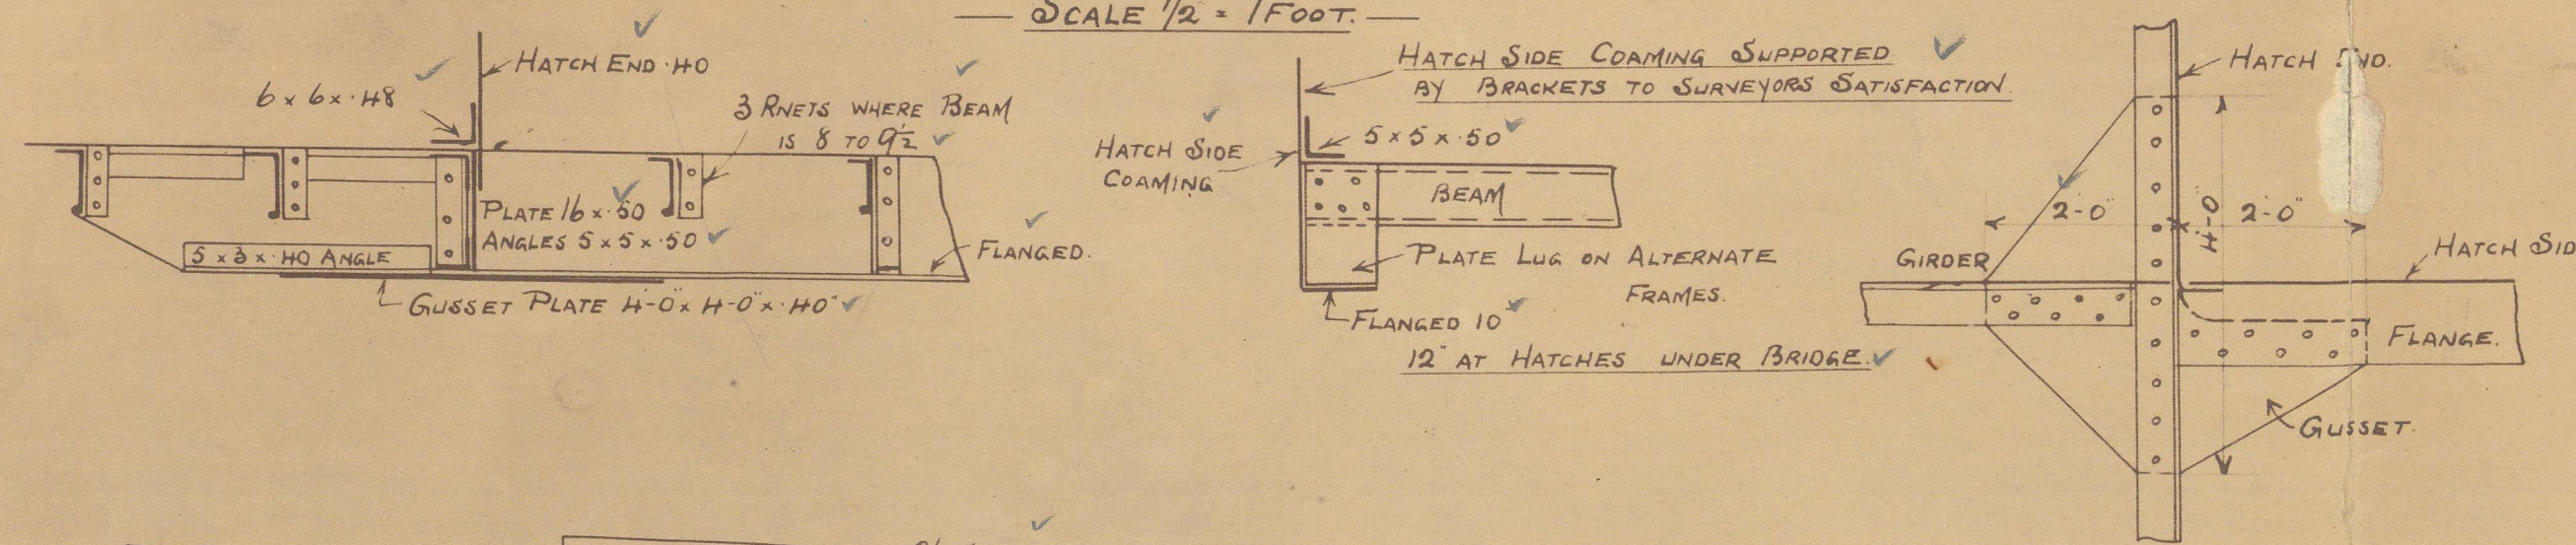

28.10.12

PLAYING 36 to 30.
FRAME ANGLE $5 \times 5 \times 5H$.
VERTICAL STIFFENERS AROUND PEAK TANK ✓
 $9 \times 3\frac{1}{2} \times 5H$ B.A. ON FIRE SIDE SPACED 2H APART & KNEED TO PEAK TOP ✓
VERTICAL STIFFENERS ABOVE PEAK TANK $6 \times 3 \times 40$ ANGLES SPACED 2H APART ✓
HORIZONTAL STIFFENERS $7\frac{1}{2} \times 3 \times 42$ B.A. ✓
SPACED AS SHOWN & KNEED TO SIDE OF SHIP. ✓

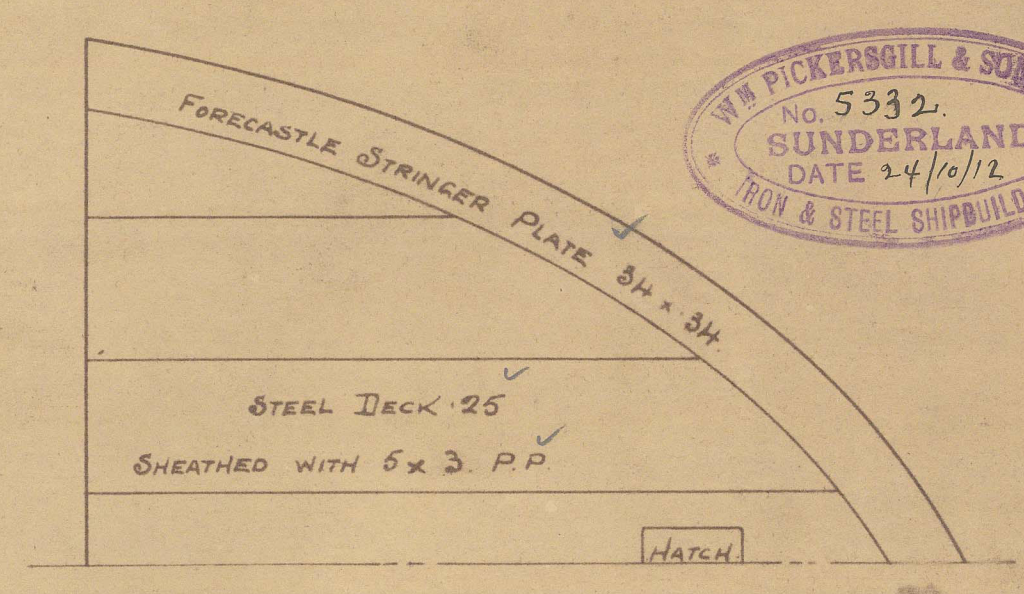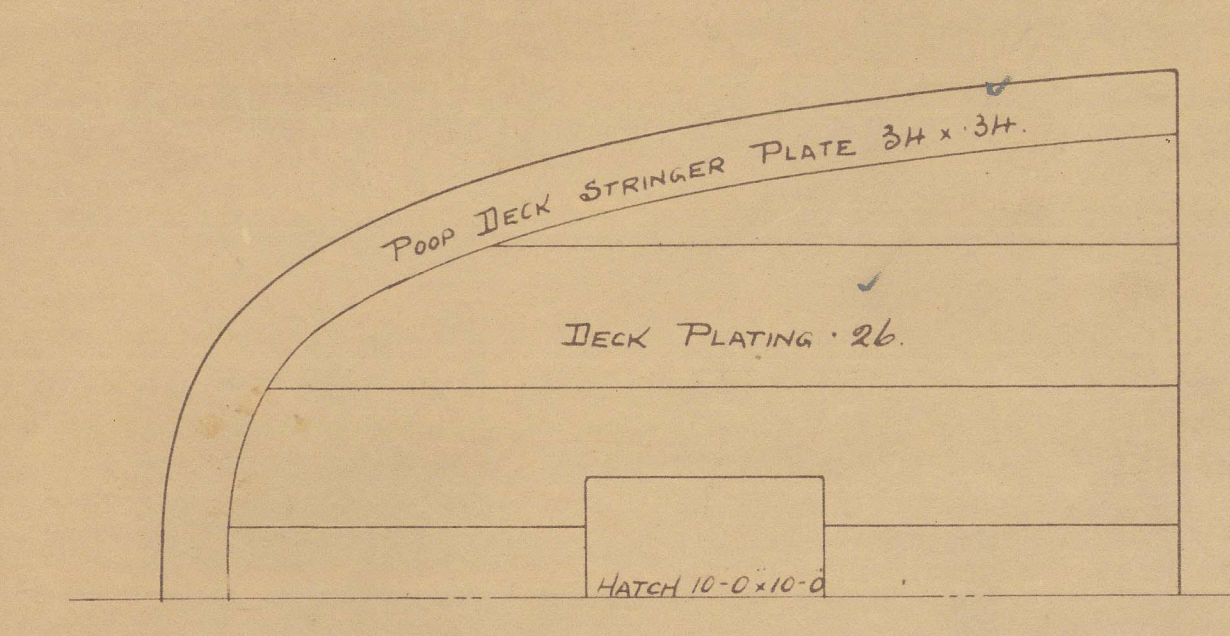


Nº180

C. B. 25. 10. 12.

A purple oval stamp from Lloyd's Register of Sunderland Shipping. The text "LLOYD'S REGISTER OF" is curved along the top, "SUNDERLAND" is in the center, and "SHIPPING" is curved along the bottom. The date "25-10-12" is stamped in the middle. Above the stamp, the handwritten number "116" is visible.

CKERSGILL & SONS LTD
HIPBUILDERS
SUNDERLAND © 2021

 Lloyd's Register Foundation

W. PICKERSGILL + SONS

Nº 180



S.S. HELMSLOCH

PROFILE AND DECK PLANS

Sld Rpt No 25859



SAT. NOV. - 2 1912

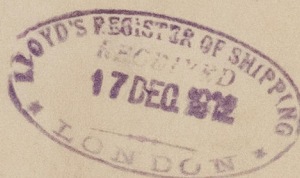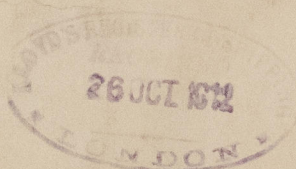

Calanda

RETAIN



Lloyd's Register
Foundation

W1629 - 0026