

20.7.11
27.7.11
3.8.11
14.9.11
13.10.11
16.11.11
18.5.12



Schwaben

MIDSHIP SECTION

SCALE $\frac{1}{2}'' = 1 \text{ FOOT.}$

DRAFT OF WATER ABOUT 22'-6" (1.8)

Sketch of Brackets to be submitted.

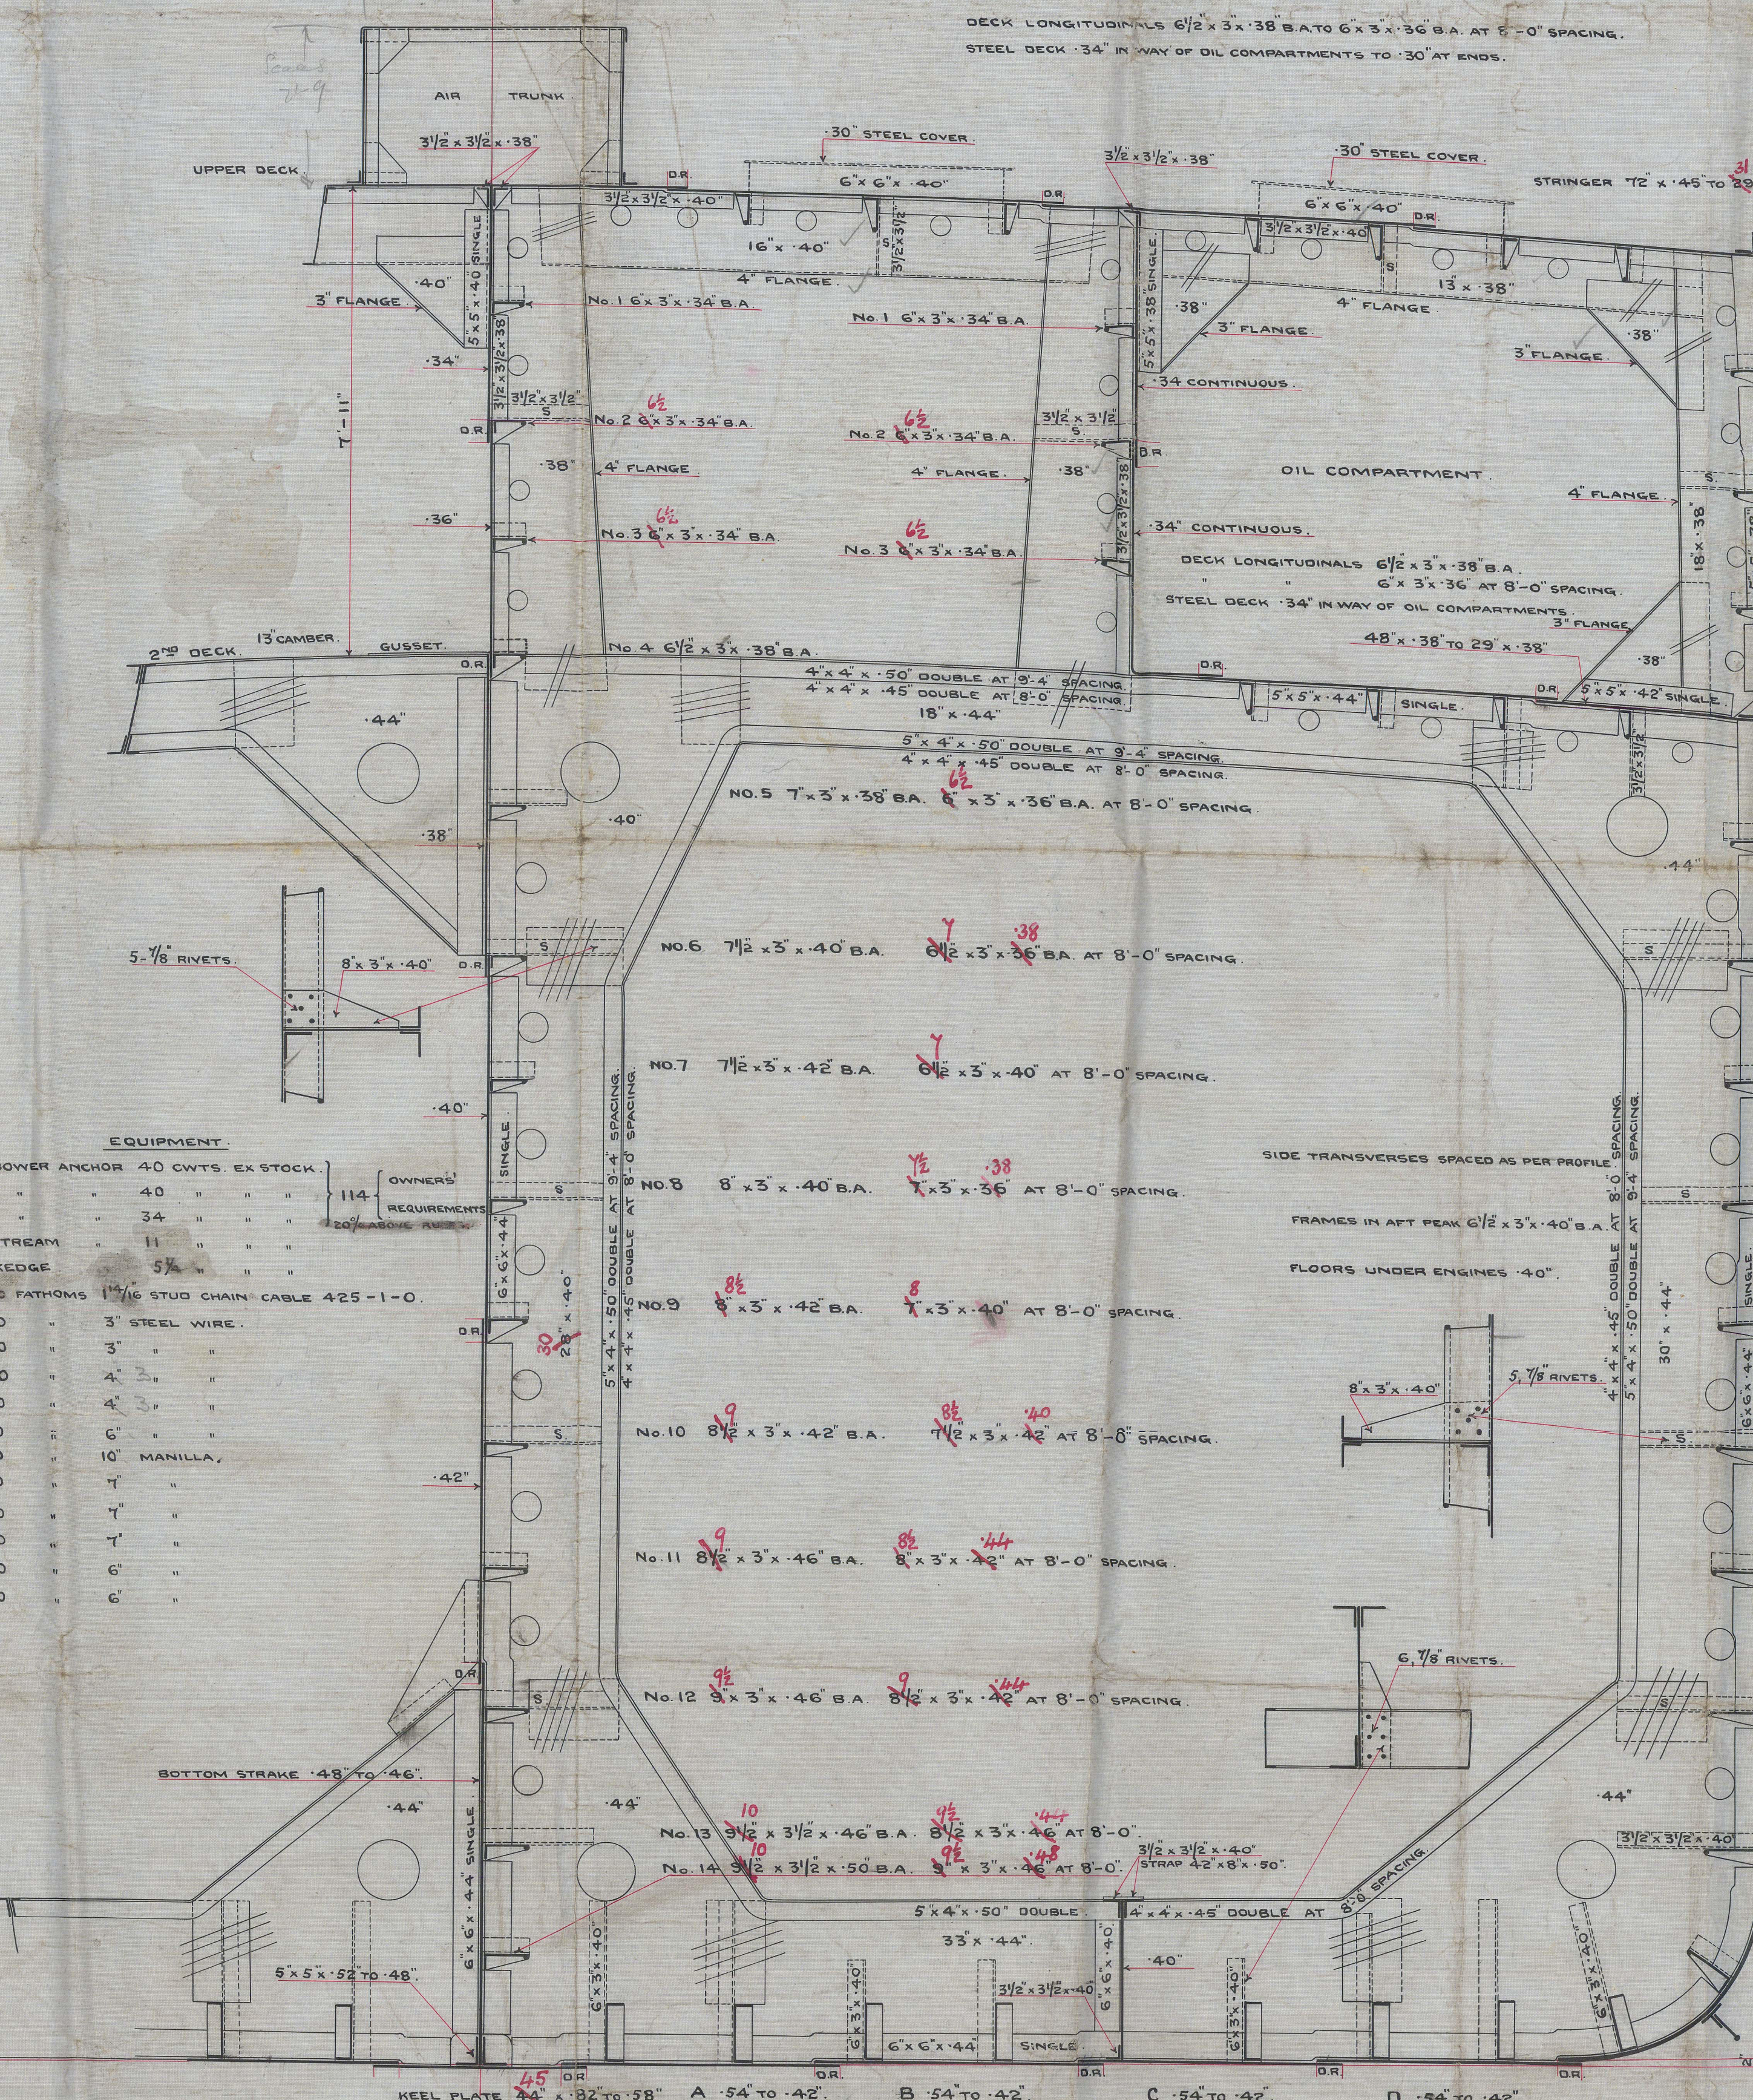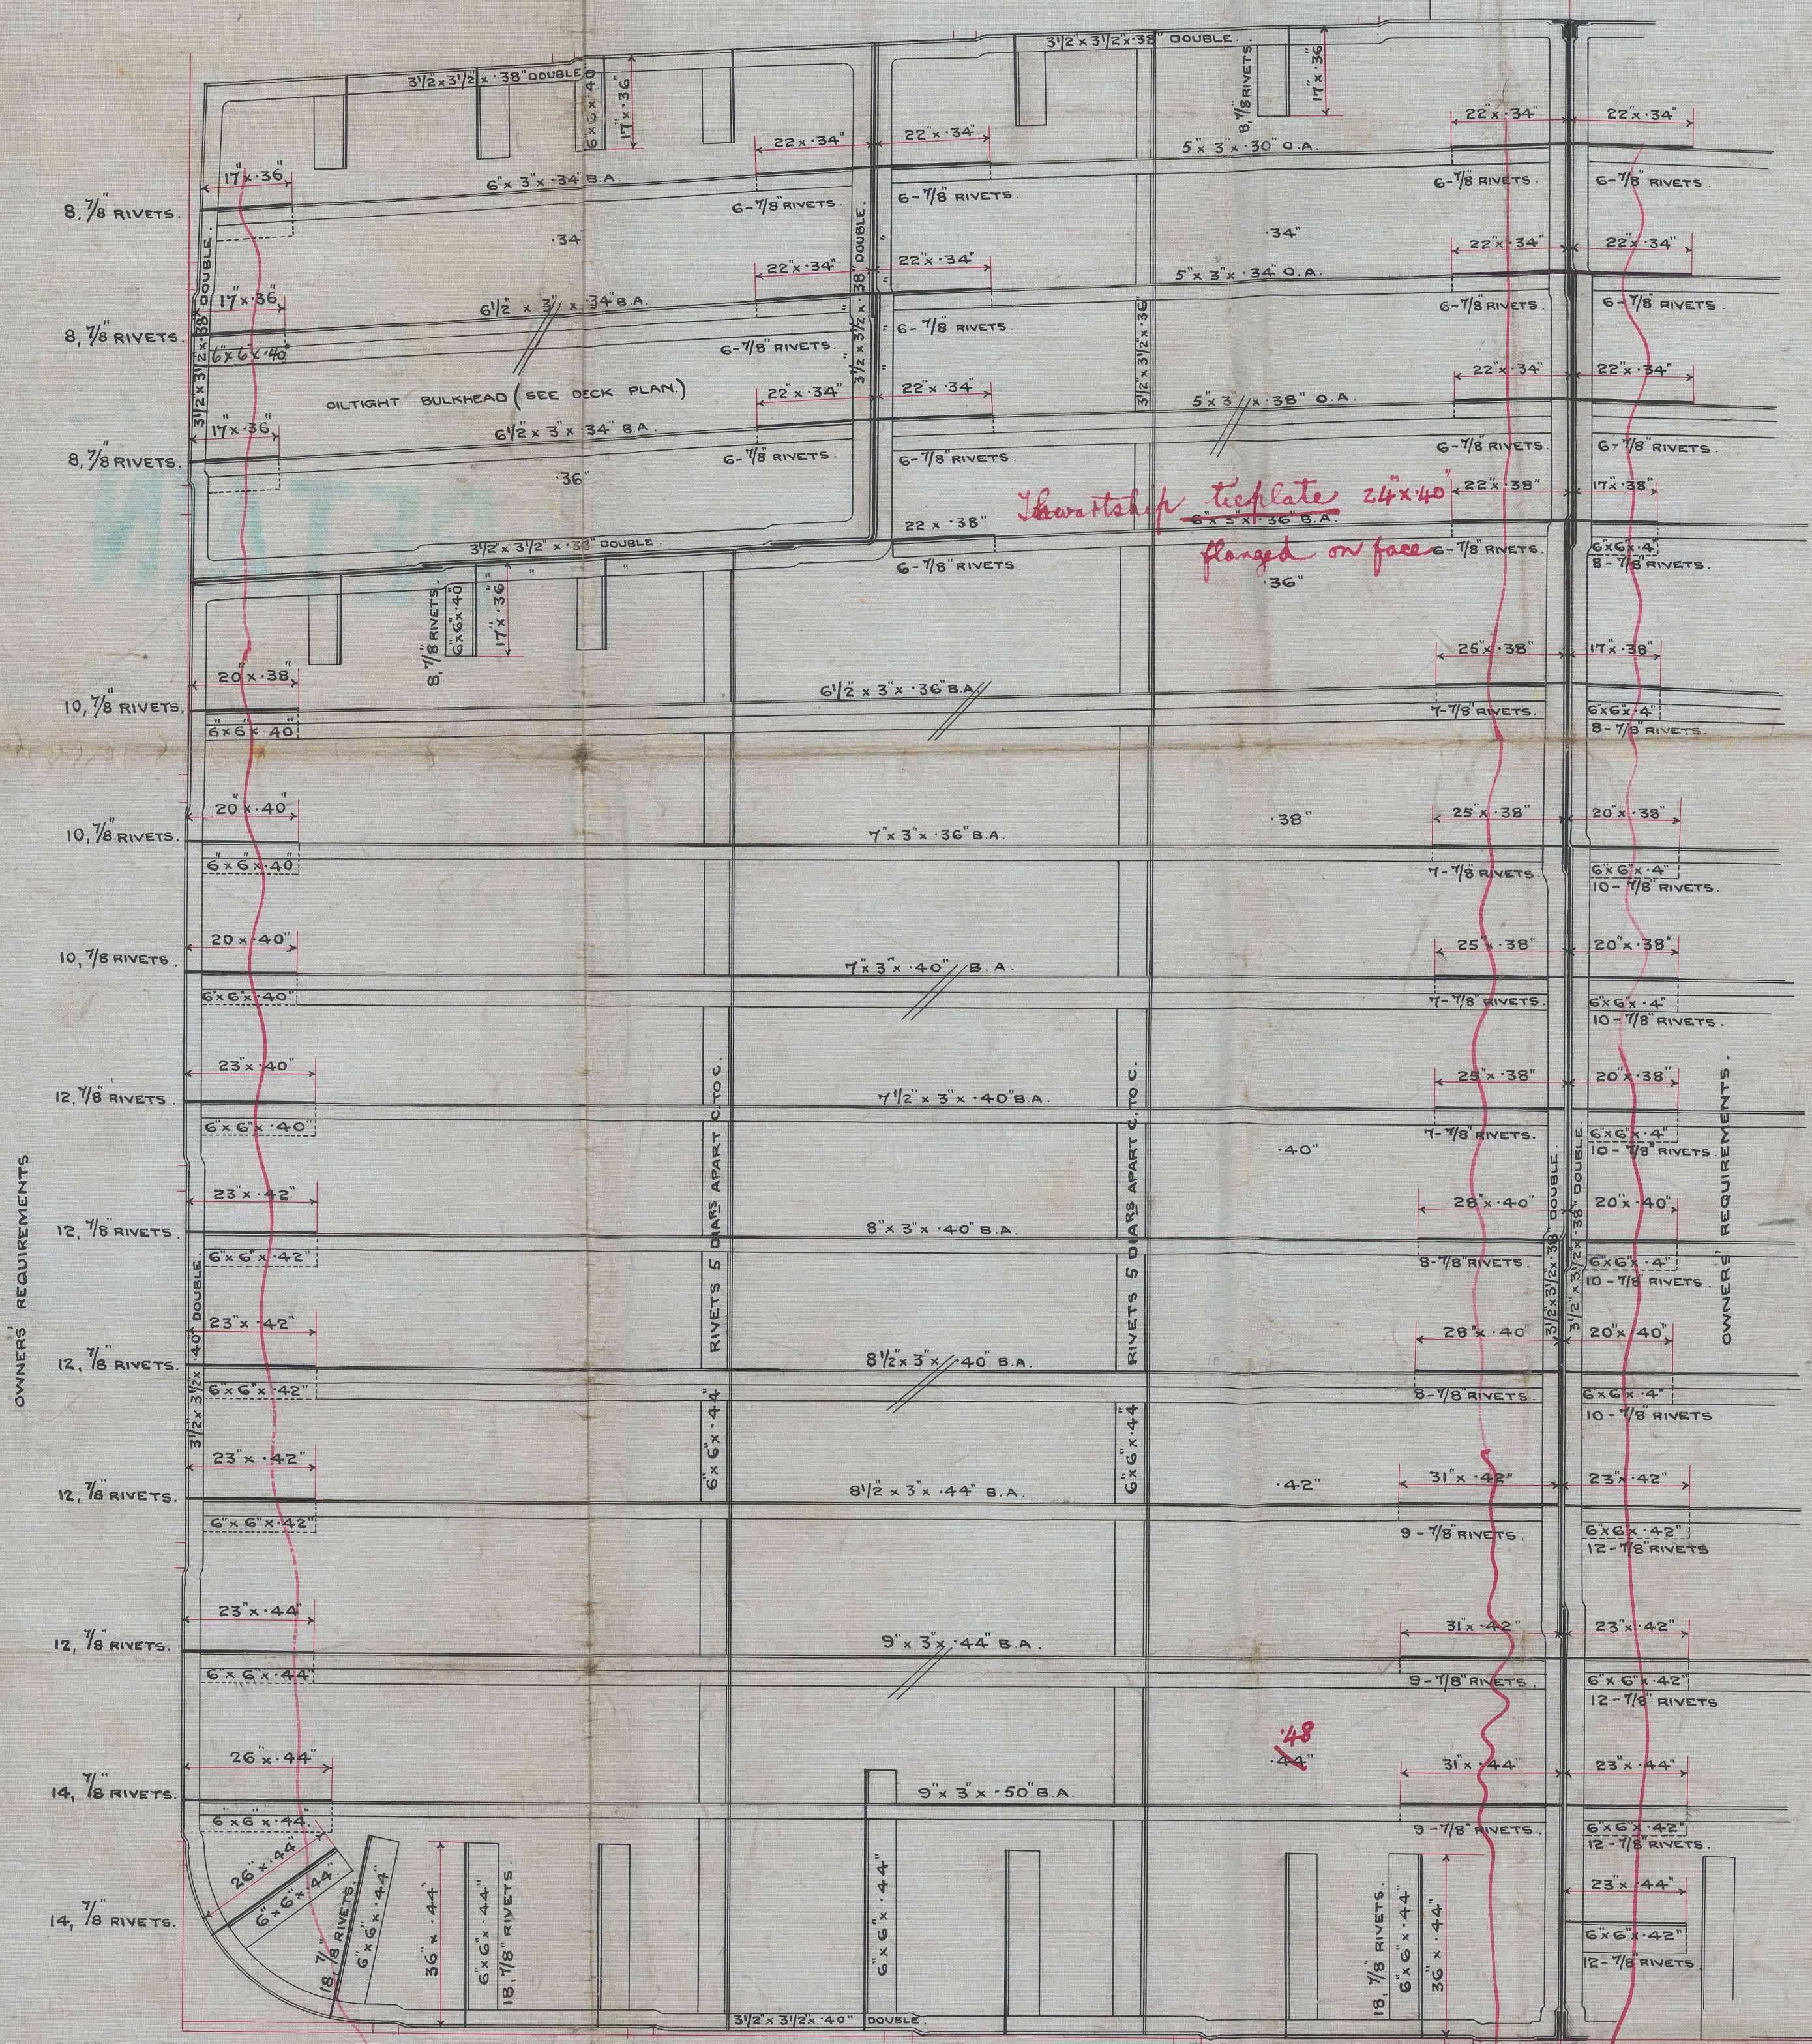

SIDE LONGITUDINALS IN FUEL BUNKER
AND NOS. 1, 2 & 3 OIL TANKS.

[illegible]

Sketch to be submitted

Sir W. G. Armstrong
Whitworth & Co Ltd


SS 843

Midsup Section

S.S. SHWEDAGON

NEWCASTLE ON TYNE

REPORT No. 62442

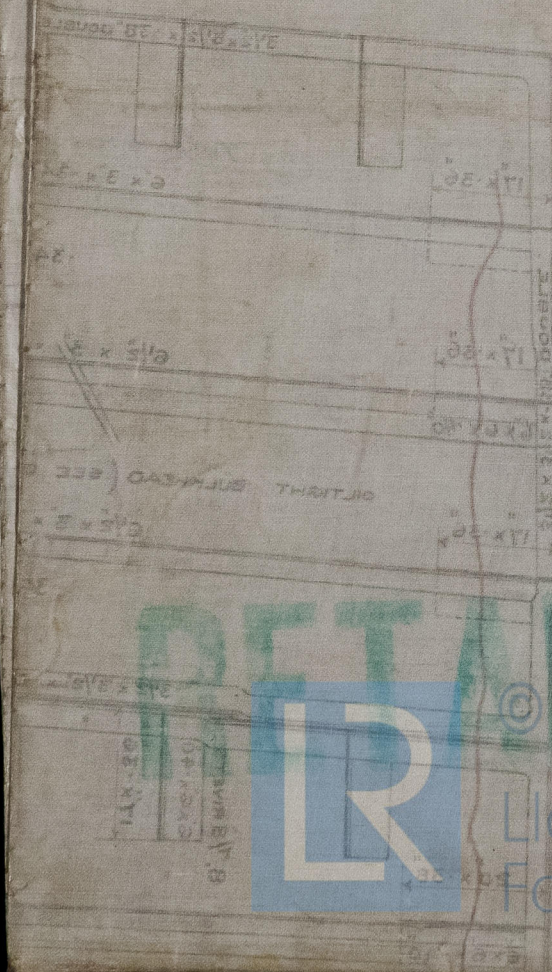

© 2021

Lloyd's Register
Foundation