

Particulars of 2 Boilers		
Heating Surface of Tubes	3348	sq. feet
" " " " " " " " " " " "	260	" "
" " " " " " " " " " " "	394	" "
" " " " " " " " " " " "	88	" "
Total Heating Surface	4090	sq. feet
" Grate Surface	104	sq. feet

BOILERS № 241. 242. 243.

SCALE 1" = 1 FOOT.

2 BOILERS. PER NO

Nº ~~241, 242~~ 243.

16-0' CENTRES

Central No. 243.



Two Main Boilers

180 lbs. w.p.

for SSho. 36 of
Compania Rustalduna de
Construccion y Reparacion
de Buques, Bilbao.

S/S. Mouro

net Hbl report 15253

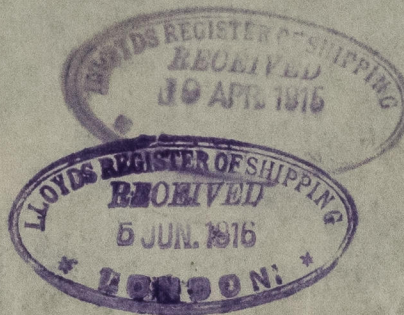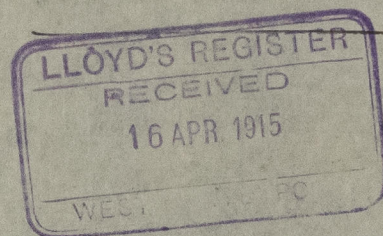

© 2021

Lloyd's Register
Foundation

W1630-0036