





SUNDERLAND


LAINGS 679

MIDSHIP  
SECTION



$\frac{5}{15}$  "BRITISH JUDGE"

SUNDERLAND RPT No 28236

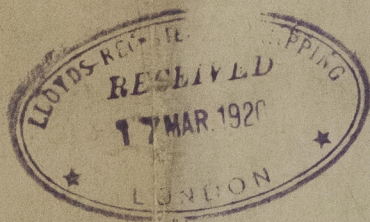

RETAIN

W1630-0076



© 2021

Lloyd's Register  
Foundation



Approved

Heeter

No 679

W1630-0076



© 2021

Lloyd's Register  
Foundation