


4.12.14

Nº 349 T.S.S


AMENDED ARRANGEMENT OF 2ND DECK PLATING IN WAY OF BOILER OPENINGS.

SCALE 1/8=ONE FOOT.

Revised by J. Baker

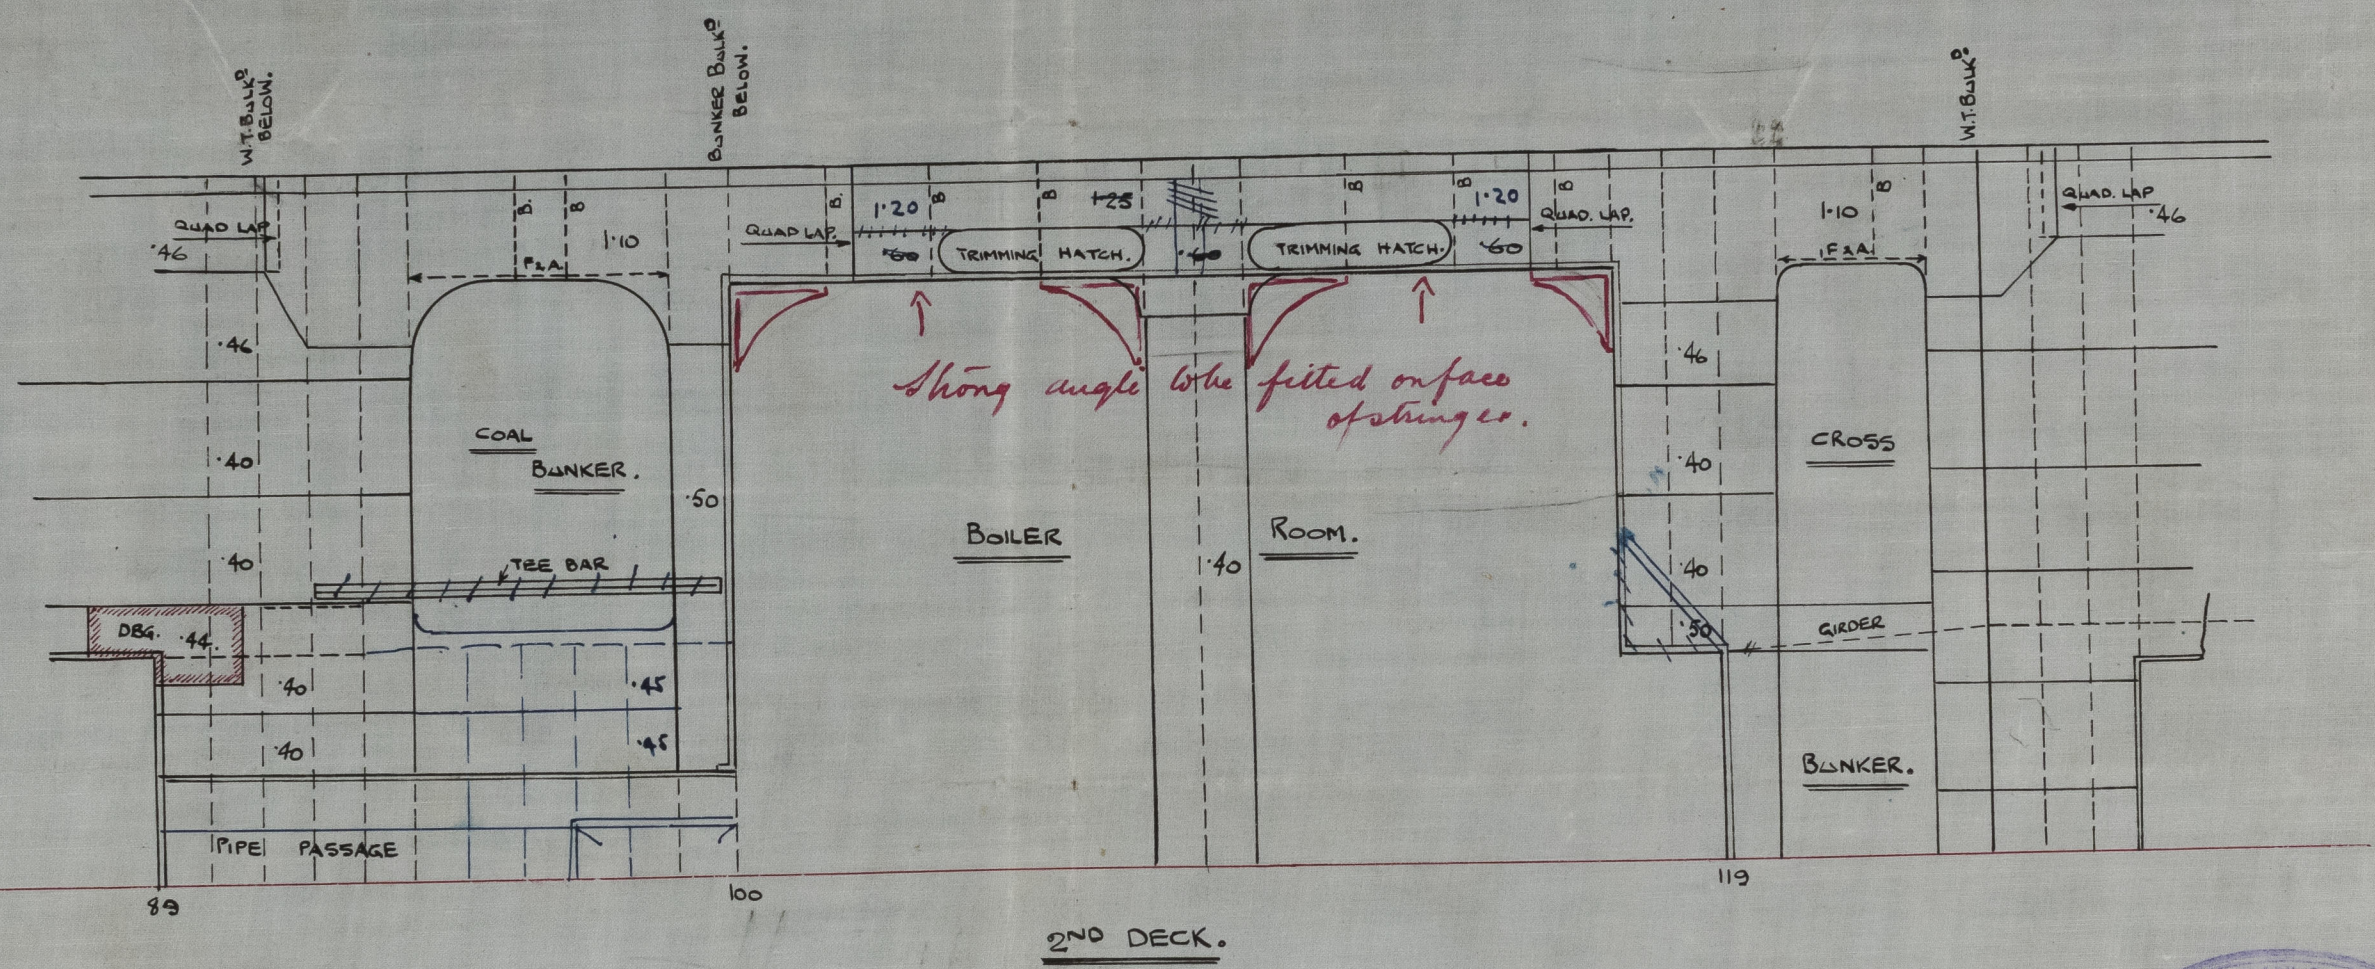

W.C.
4.12.14

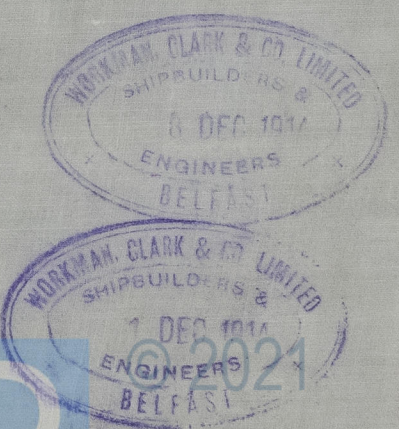

W1633-0201.1


