N° 349

AMENDED UPPER Dk PLATING AT Br CASING.

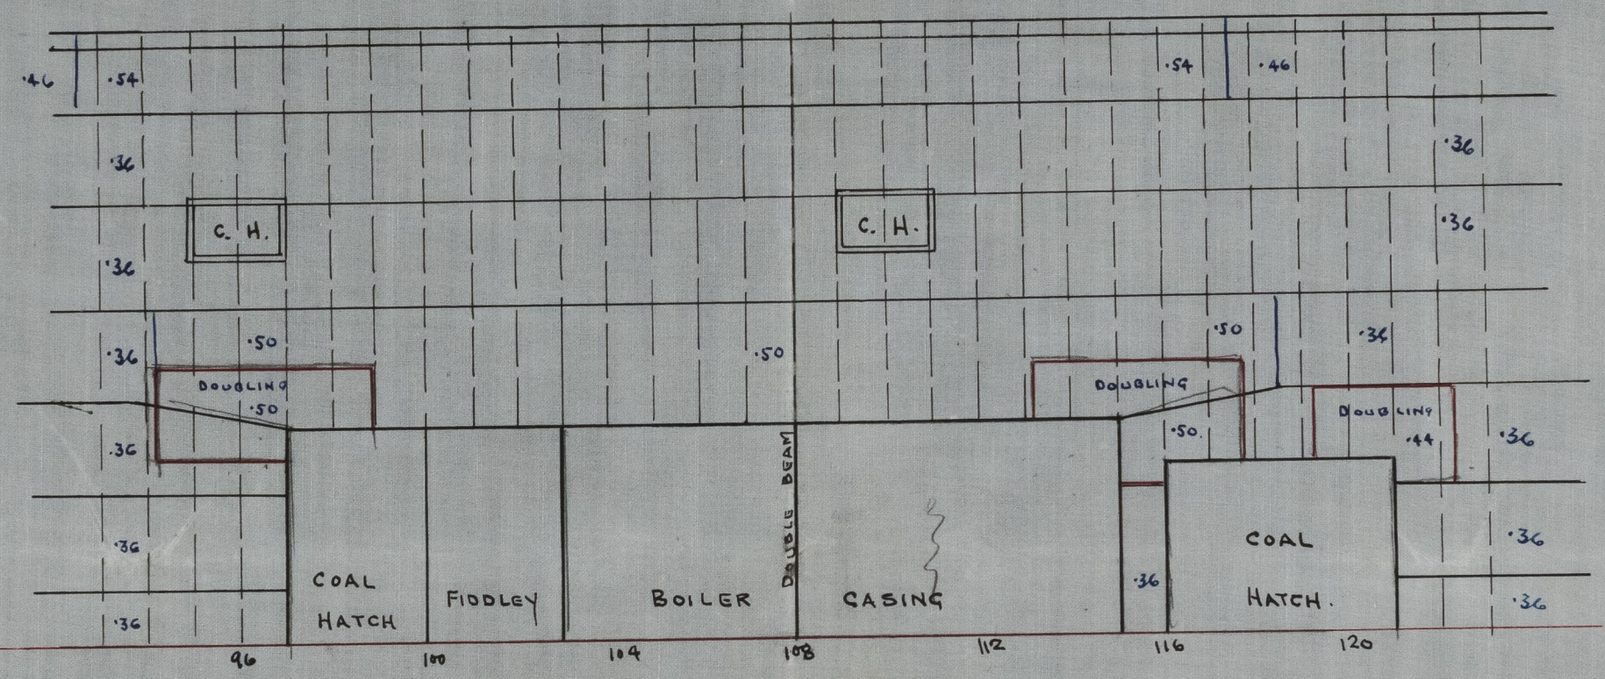

© 2021
Lloyd's Register Foundation

W1633-0201.2