
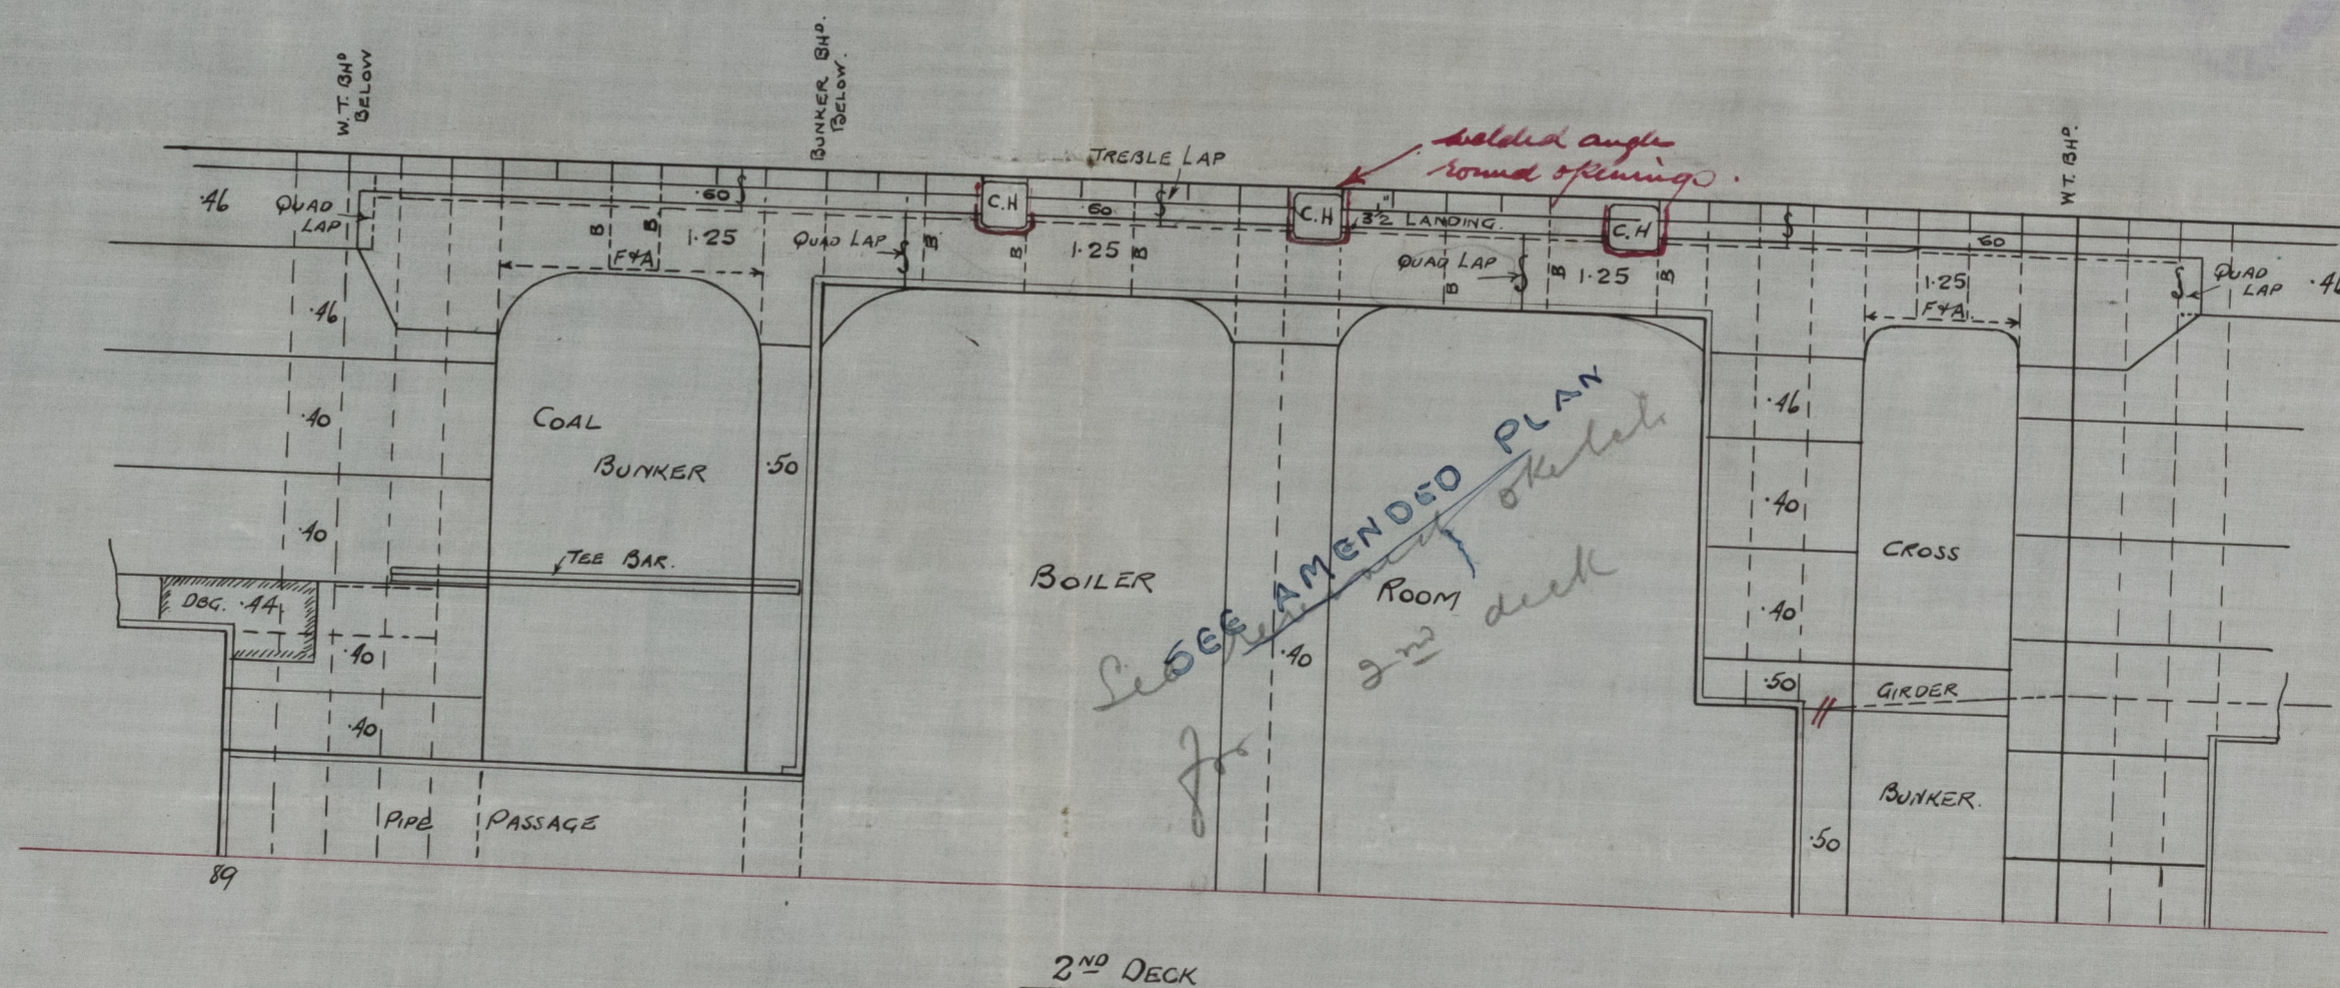


AMENDED ARRANGEMENT OF DECK PLATING IN WAY OF BOILER OPENINGS



SCALE $\frac{1}{8}'' = \text{ONE FOOT.}$

4.12.14

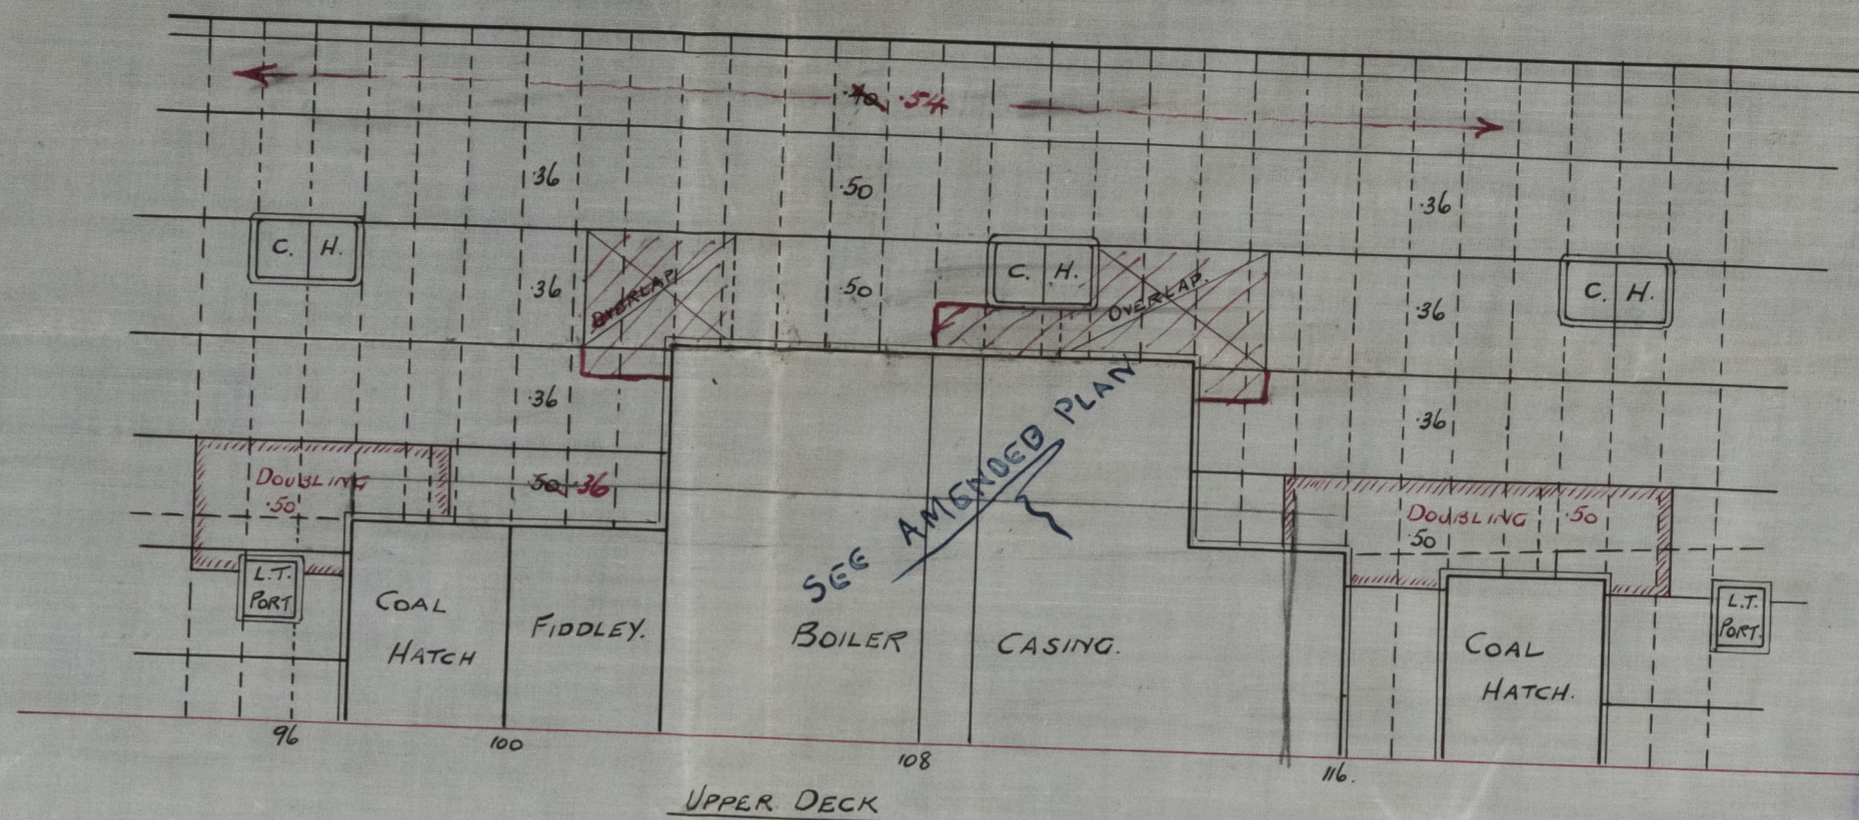

2ND DECK




C. J.
6. 11. 14

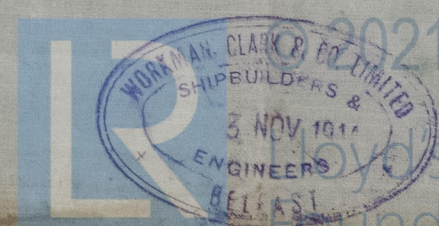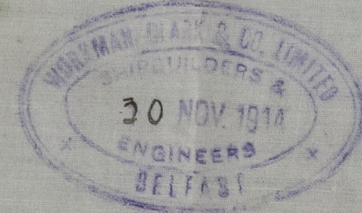

W1633-0201.3

No 249

Alteration to decks
in way of boiler space

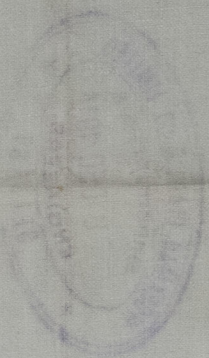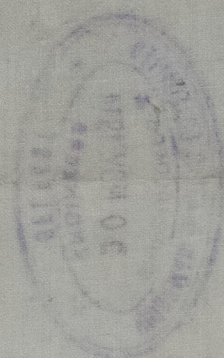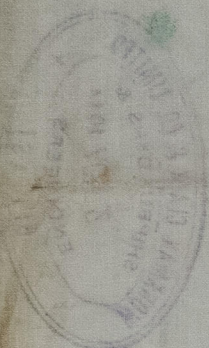


1/2
1/2
1/2
1/2



W1633-0201.3

3rd DECK

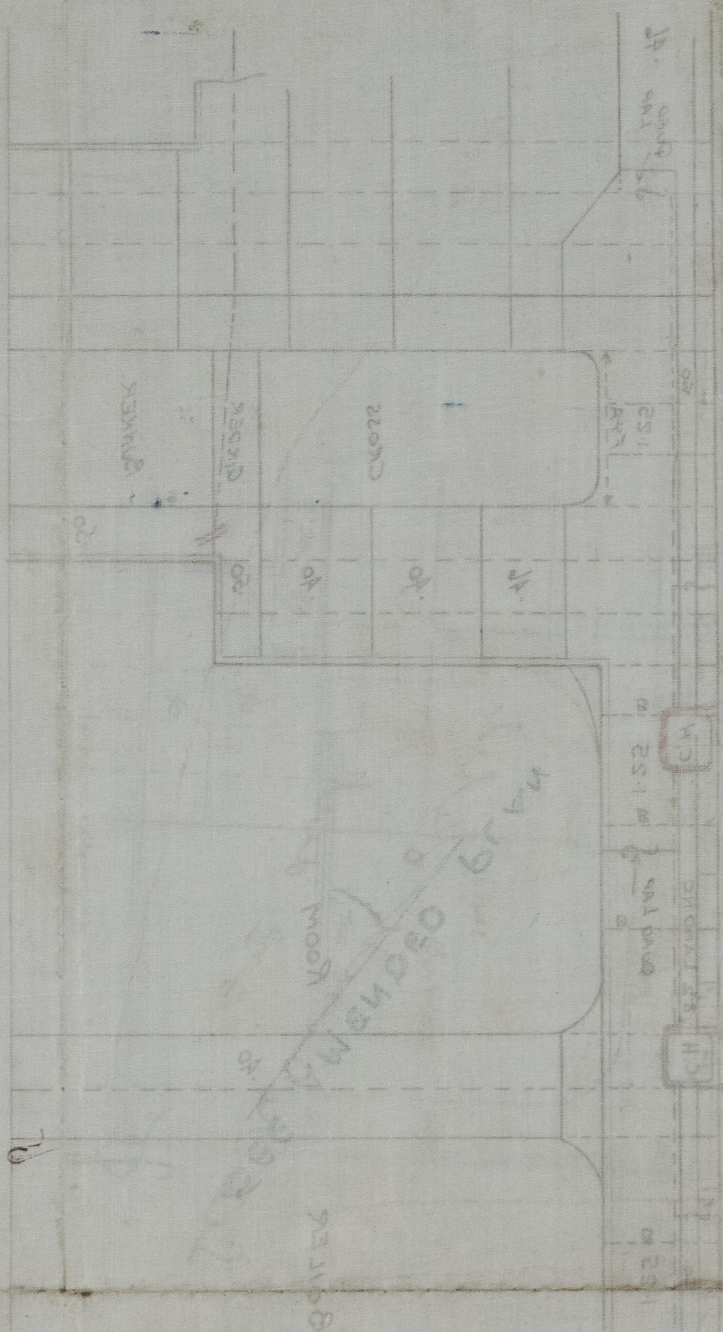

3rd DECK



© 2021
Lloyd's Register
Foundation

TOP


221