





For Enclosure to

*Messrs. Lloyds Surveyors.*

6202 2/2



Wickman Clark & Co.

N<sup>o</sup> 349

Amended Profile  
showing alteration to stern  
and framing in Nos 1 and  
5 Holds.

J. S. Mahana

Blf 4824

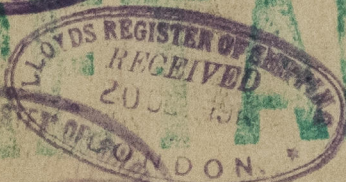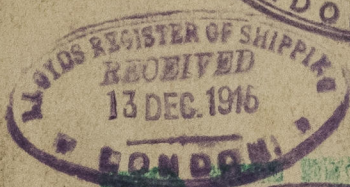

Lloyd's Register  
Foundation

W1366-0202 1/2



No. 349

W1633-0202 1/2



© 2021

Lloyd's Register  
Foundation