


N^o 349. "MAHANA"

MIDSHIP SECTION OF T.S. TURBINE STEAMER

DIMENSIONS 500' x 63' x 34' ^{6"} TO UPPER DECK 42-10' TO SHELTER DECK
+3'-0"

TO CLASS 100A1. AT LLOYDS

SCALE $\frac{1}{2}$ " = ONE FOOT.

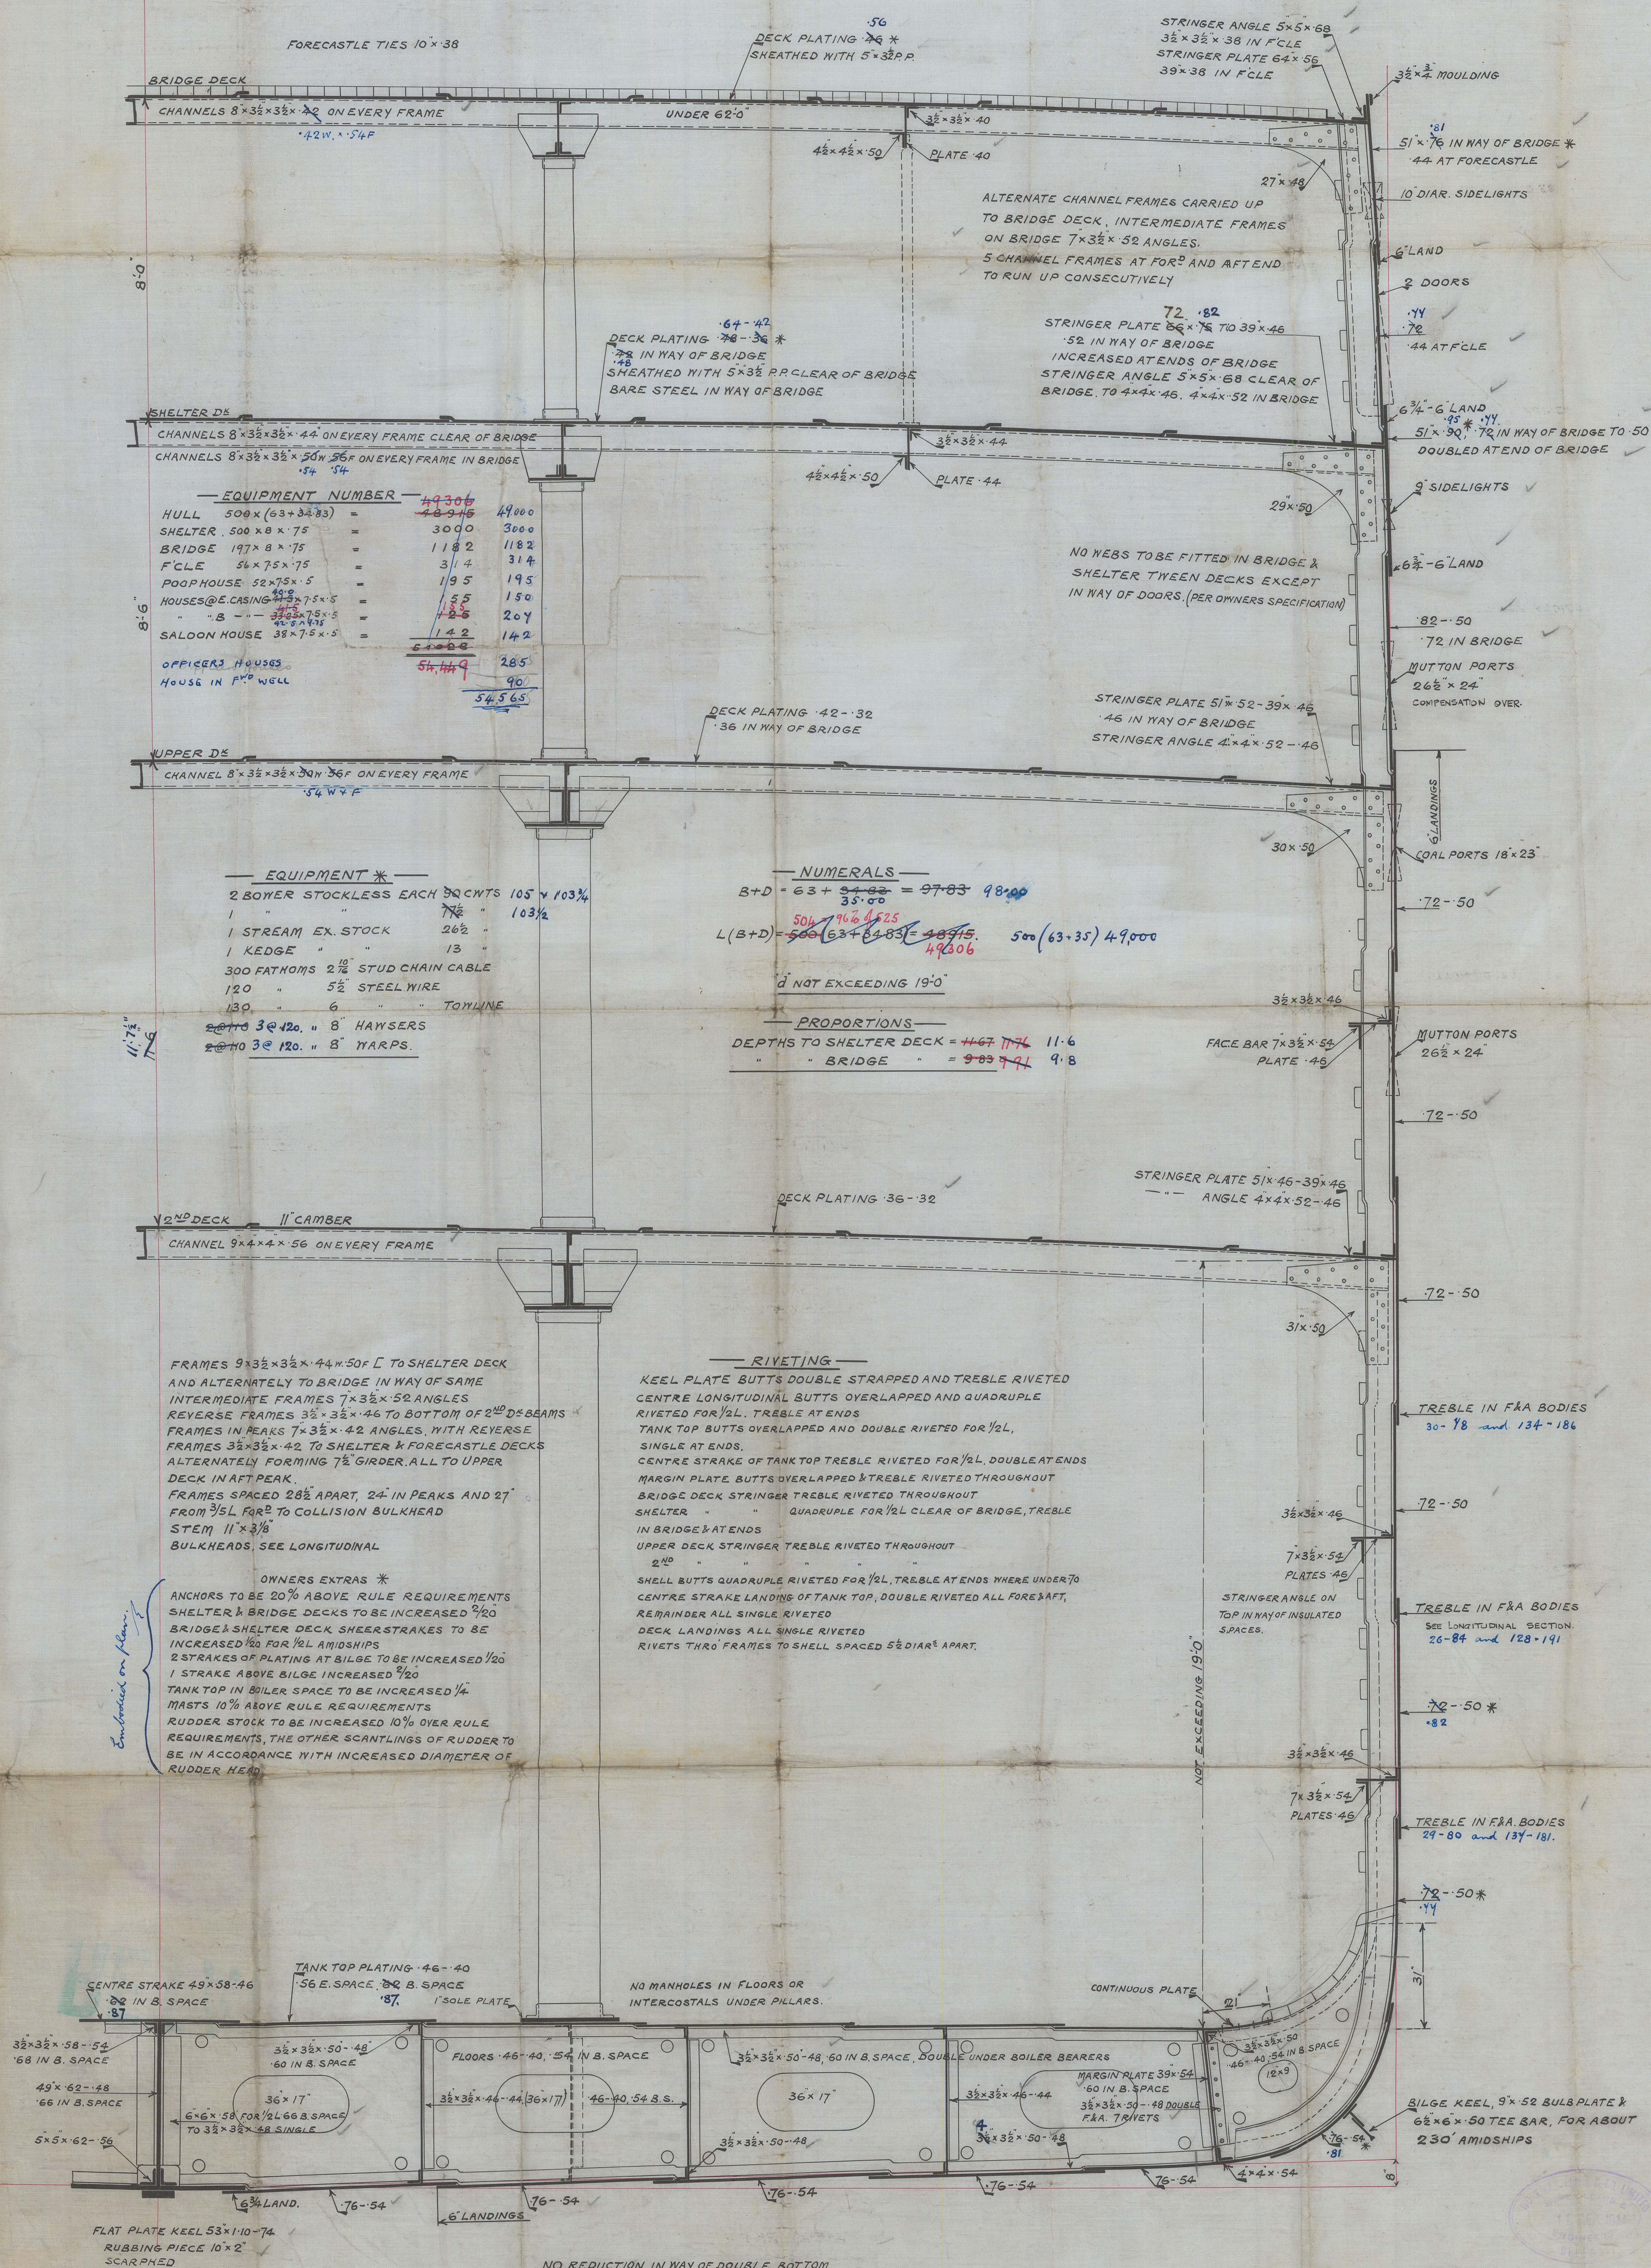

C.F.
3.9.14

Workman Clark & Co

Nº 349

Midship Section

SS "Makana"

Blf 4824

RELEASED



© 2021

Lloyd's Register
Foundation

W1633-0204