


COOK WELTON & GEMMELL

N^{os} 335-6-7-8-9-40

PROFILE

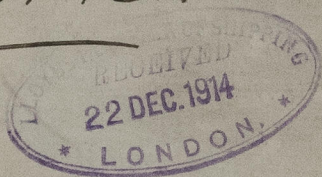

See amended plan

for 340



* "Riviera" Hull Rpt

19313.

S. S. Novelli Hull Rpt
N^o 29349.

"Salvini" Hull Rpt No
29341.

S. Louis Botha Hull Rpt
No. 29404

S. Orvieto Hull Rpt No. 29457