

$B+D = 35.41$ ✓
 $L \times (B+D) = 4142.97$ ✓
 $\frac{d^2}{D} = 12.25$ ✓
 $\frac{L}{D} = 86$ ✓
 22.12.14
 NUMERAL FOR RUDDER 46.31. ✓

MIDSHIP SECTION.

N^{OS} 335-6-7-8-9 & 40 ✓


DIMENSIONS: 117'-0" BP x 22'-0" EX x 12'-9" DEPTH OF HOLD.

SCALE 1/2" = 1 FOOT.

CLASS 100 A.I. STEAM TRAWLER.

STEEL.

EQUIPMENT	
1	ANCHOR 5 1/4 CWT EX STOCK.
7	4 1/2 " "
1	2 1/2 " "
90	FTMS 1" STUD LINK CABLE.
60	" 6" HAWSER.
60	" 4 1/2" WARP.

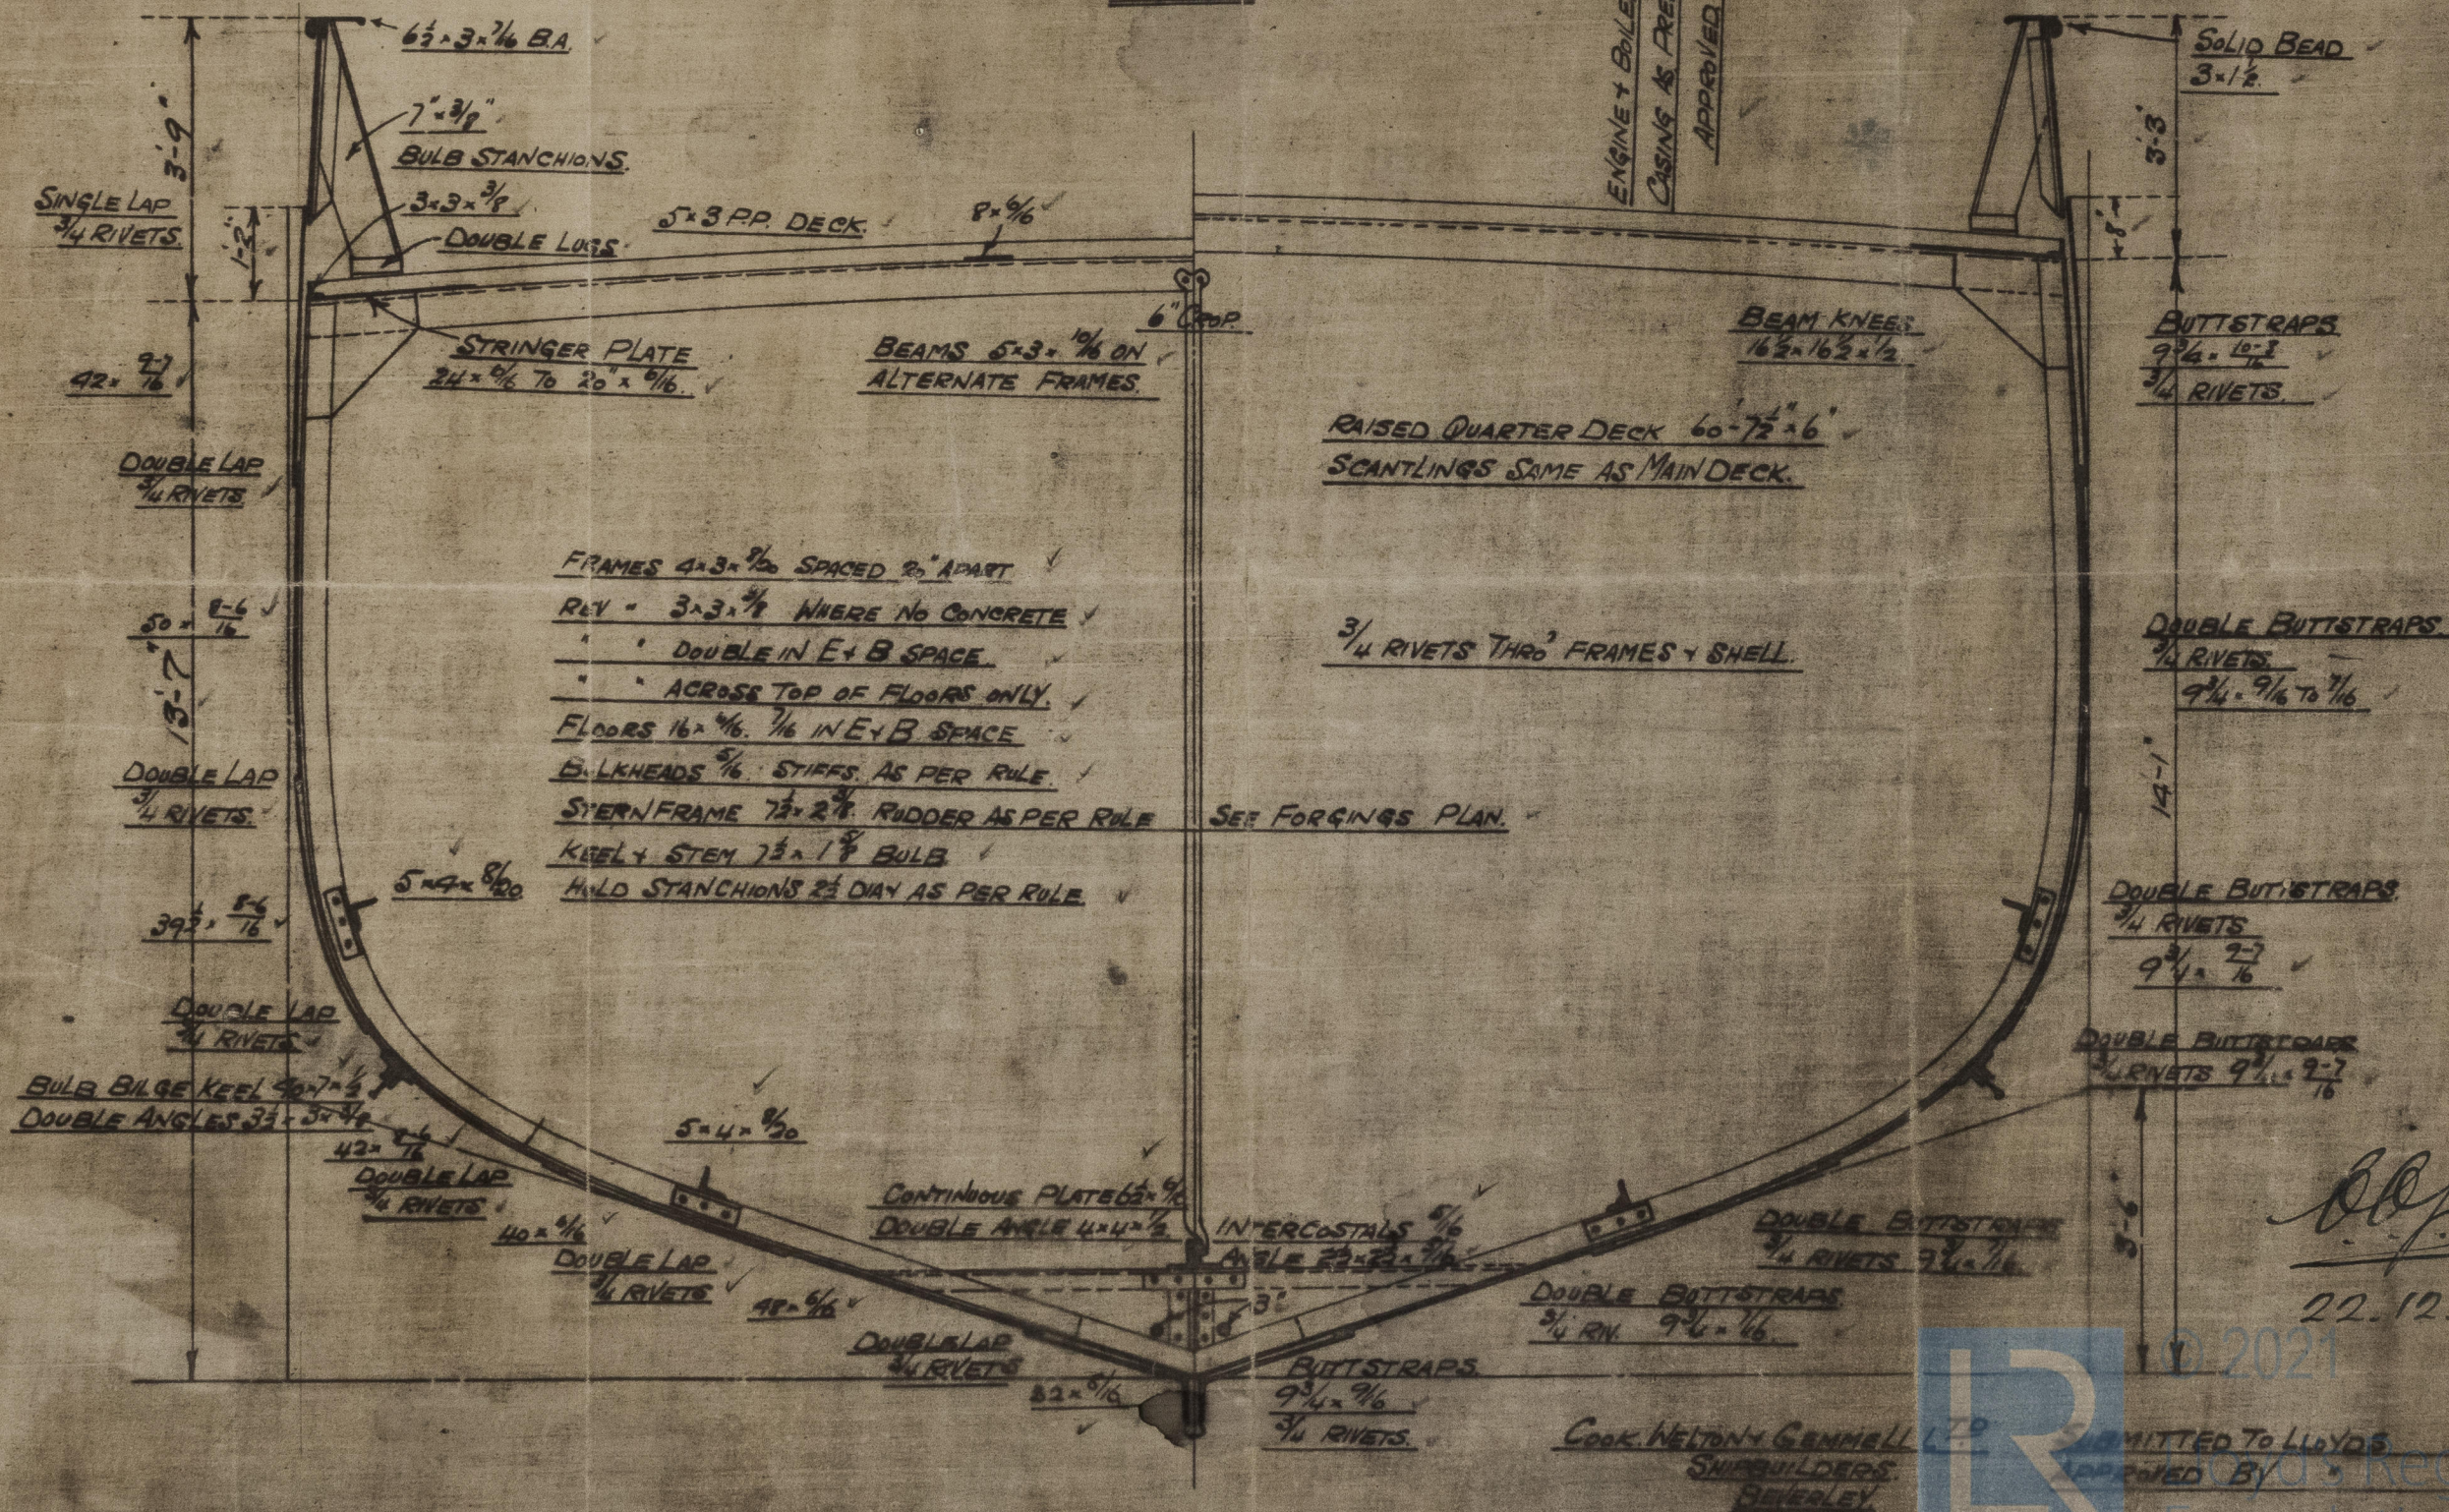

COOK WELTON + GEMMELL

N^{os} 335-6-7-8-9-~~Ad~~


MIDSHIP SECTION

See amended plans
for 340.

* A. L. Riviere Hull Rpt 29313.



RETAIN

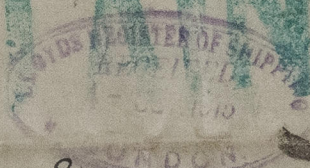

S. S. Novelli Hull Rpt
N^o 29349.

S. "Salvini" Hull Rpt no 29371
S. Louis Robt Hull Rpt no 29407
S. "Gusto" Hull Rpt no 29457

