

25-1-10
8-2-10
16-2-10
17-2-10
(18-2-10) 24-2-10
7-3-10


: MIDSHIP SECTION:

: T.S.S. NO. 483 : 484

: MOULDED DIMENSIONS : 390' 0" x 50' 0" x 24' 0" TO UPPER DECK:

: SCALE 1/2" = ONE FOOT:

: TO CLASS 100 A LLOYDS

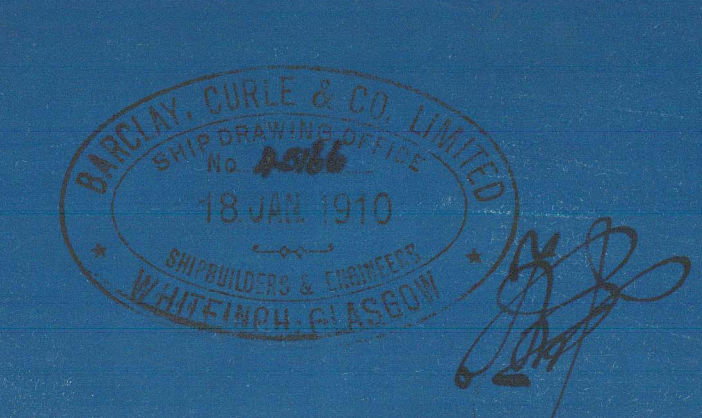


LOYDS NUMERALS:
1st No (80 + 24) = 74
2nd No (390 + 74) = 2860
1/2 = 16.25 TO UPPER DECK, 12.18 TO SHELTER DECK
2 = 11.92 FEET

EQUIPMENT:
L(B+D) = 28800
SHELTER DECK 390 x 8 x 1/4 = 2340
FOUR 56 x 7 1/2 x 3/4 = 315
SHADE 150 x 5 x 1/2 = 180
BART DIA. 80 x 8 x 1/2 = 783
AFF BART DIA. 80 x 8 x 1/2 = 112
CHAINS ETC 80 x 8 x 1/2 = 355
EQUIPMENT NO. 33254

EQUIPMENT:
TWO BOWER ANCHORS EACH 60 OUTS STOKLESS ONE 50T
ONE STEAM ANCHOR 16 1/2 OUTS EX STEEL
ONE KEDGE ANCHOR 7 OUTS
ONE KEDGE ANCHOR 7 OUTS
270 FATHOMS 2 1/2 SKID CHAIN CABLE
90 FATHOMS 1 1/2 SKID CHAIN CABLE
100 FATHOMS 1 1/2 SKID CHAIN CABLE
TWO EACH 90 FATHOMS 8 MANILA HAWSEY
TWO EACH 90 FATHOMS 7 MANILA WARPS

END CONNECTIONS	FOR 1/2 LENGTH 36	AT ENDS
KEEL	QUADRUPLE RIV	TREBLE RIV
SHEER STRAKE (SHELTER DECK)	---	---
STRAKE BELOW	---	---
OUTSIDE PLATING FROM KEEL TO UPPER TURN OF BILGE	TREBLE RIV IN WAY OF C.D.B. QUAD RIV AT BILGE	TREBLE RIV
PLATING ROUND BOSS EYE	---	QUADRUPLE RIV
OUTSIDE PLATING FROM UPPER TURN OF BILGE TO STRAKE BEAM	TREBLE RIV	TREBLE RIV
SHEER STRAKE (SHELTER DECK)	OVER 66" IN WIDTH	OVER 66" IN WIDTH
FORECASTLE SIDE PLATING	---	DOUBLE RIV
FORECASTLE DECK STRINGER	---	DOUBLE RIV
---	---	DOUBLE RIV
SHELTER DECK STRINGER	QUADRUPLE RIV	TREBLE RIV
---	---	TREBLE RIV
SECOND DECK STRINGER	DOUBLE RIV	TREBLE RIV
---	---	TREBLE RIV
THIRD DECK STRINGER	TREBLE RIV	TREBLE RIV
---	---	TREBLE RIV
CENTRE GIRDER	TREBLE RIV	TREBLE RIV
MARGIN PLATE	TREBLE RIV	TREBLE RIV
TANK TOP CENTRE STRAKE	TREBLE RIV	TREBLE RIV
TANK TOP PLATING	DOUBLE RIV	SINGLE RIV

EDGE CONNECTIONS	FOR 1/2 LENGTH 36	AT ENDS
FORECASTLE SHELL	---	SINGLE RIV
SHELTER DECK SHEER STRAKE	DOUBLE RIV	DOUBLE RIV
REMAINING SHELL EDGES	DOUBLE RIV	DOUBLE RIV
SHELTER DECK STRINGER	SINGLE RIV	---
UPPER DECK STRINGER	SINGLE RIV	---
REMAINING DECK EDGES	SINGLE RIV	---
TANK TOP CENTRE STRAKE	DOUBLE RIV	DOUBLE RIV
TANK TOP PLATING	SINGLE RIV	---

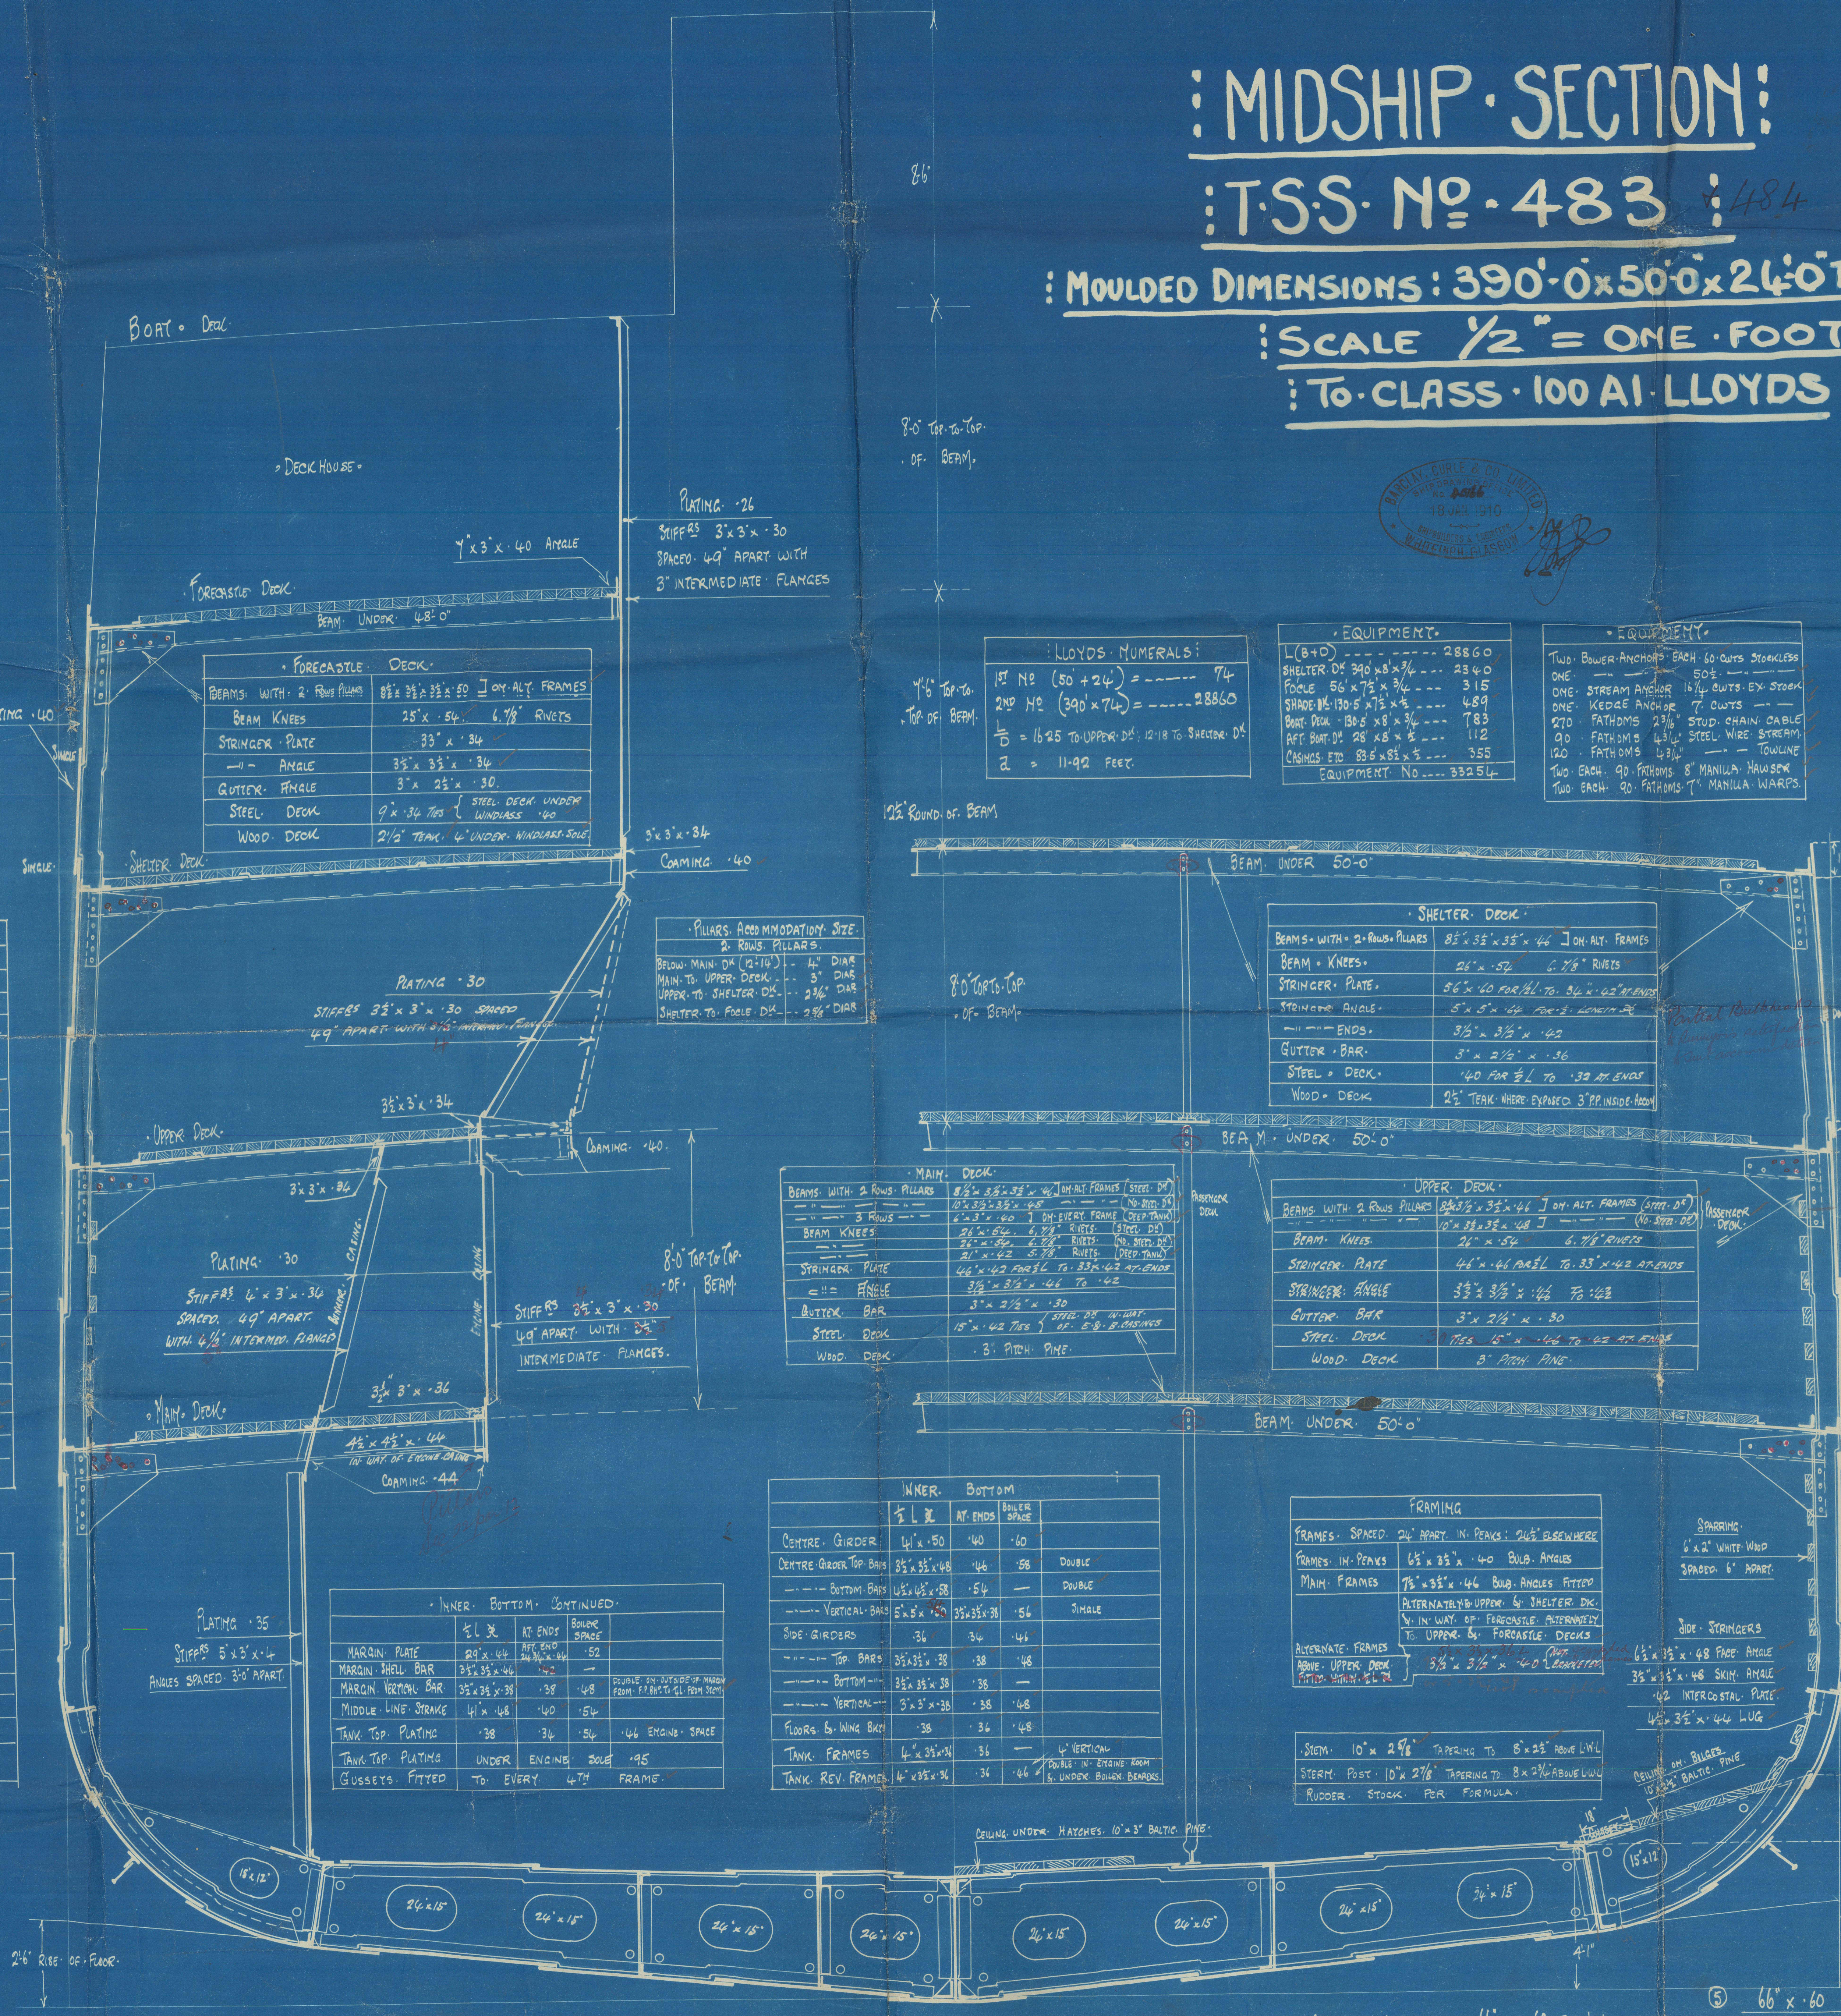

INNER BOTTOM			
CENTRE GIRDER	1/2 L	AT ENDS	BULB SPACE
---	14' x 50	140	140
CENTRE GIRDER TOP BARS	3 1/2 x 3 1/2 x 1/4	146	158
---	---	---	---
BOTTOM BARS	1 1/2 x 1 1/2 x 1/4	154	166
---	---	---	---
VERTICAL BARS	5/8 x 5/8 x 1/4	35	36
---	---	---	---
TOP BARS	3 1/2 x 3 1/2 x 1/4	38	48
---	---	---	---
BOTTOM	3 1/2 x 3 1/2 x 1/4	38	48
---	---	---	---
VERTICAL	3 x 3 x 1/4	38	48
---	---	---	---
FLOORS & WING BARS	3/4 x 3/4 x 1/4	36	48
---	---	---	---
TANK FRAMES	4 x 3 1/2 x 1/4	36	48
---	---	---	---
TANK REV FRAMES	4 x 3 1/2 x 1/4	36	48

INNER BOTTOM CONTINUED			
1/2 L	AT ENDS	BULB SPACE	---
MARGIN PLATE	2 1/2 x 1/4	152	---
---	---	---	---
MARGIN SHELL BAR	3 1/2 x 3 1/2 x 1/4	38	48
---	---	---	---
MIDDLE LINE STRAKE	1 1/2 x 1/4	40	54
---	---	---	---
TANK TOP PLATING	38	36	54
---	---	---	---
TANK TOP PLATING	UNDER	ENDING	30
---	---	---	---
GUSSETS FITTED	TO EVERY	4TH	FRAME

FRAMING	
FRAMES SPACED 24" APART IN PEAKS 24" ELSEWHERE	---
FRAMES IN PEAKS	6 1/2 x 3 1/2 x 1/4 BULB ANGLES
---	---
MAIN FRAMES	7 1/2 x 3 1/2 x 1/4 BULB ANGLES FITTED
---	---
ALTERNATE FRAMES	6 x 3 1/2 x 1/4 BULB ANGLES FITTED
---	---
NOTE: STRAKES NOS 2, 3, 4, 5 WHERE ENTIRELY WITHIN THE RANGE OF DOUBLE BOTTOM & WHERE DOUBLE FLOORS ON EVERY FRAME TO BE REDUCED TO 1/2" WHERE 1/2" THICK 3/4" WHERE 3/4" THICK 1" WHERE 1" THICK 1 1/4" WHERE 1 1/4" THICK 1 1/2" WHERE 1 1/2" THICK 1 3/4" WHERE 1 3/4" THICK 2" WHERE 2" THICK 2 1/4" WHERE 2 1/4" THICK 2 1/2" WHERE 2 1/2" THICK 2 3/4" WHERE 2 3/4" THICK 3" WHERE 3" THICK 3 1/4" WHERE 3 

483. LLOYDS
MIDSHIP-SECTION.

W1637-0280

Vol. Valadurca




95 "Chilka"
GLASGOW REPORT No. 29384

Barclay Curle & Co.

VSS No. 48

Midship Section

all corrected Plan

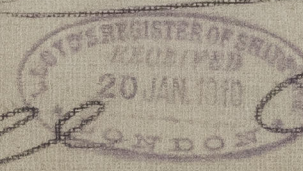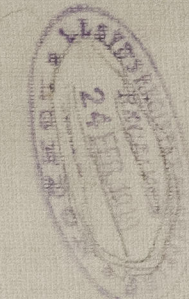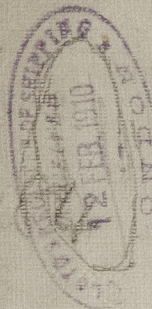

1124



© 2021

Lloyd's Register
Foundation



© 2021

Lloyd's Register
Foundation