


STEEL DECKS


T.S.S. N° 483. 7484

SCALE $\frac{1}{8}'' = 1' - 0''$


MOULDED DIMENSIONS 390'0" x 50'0" x 24'0" TO UPPER DECK
TO CLASS 100 A.I. LLOYDS.

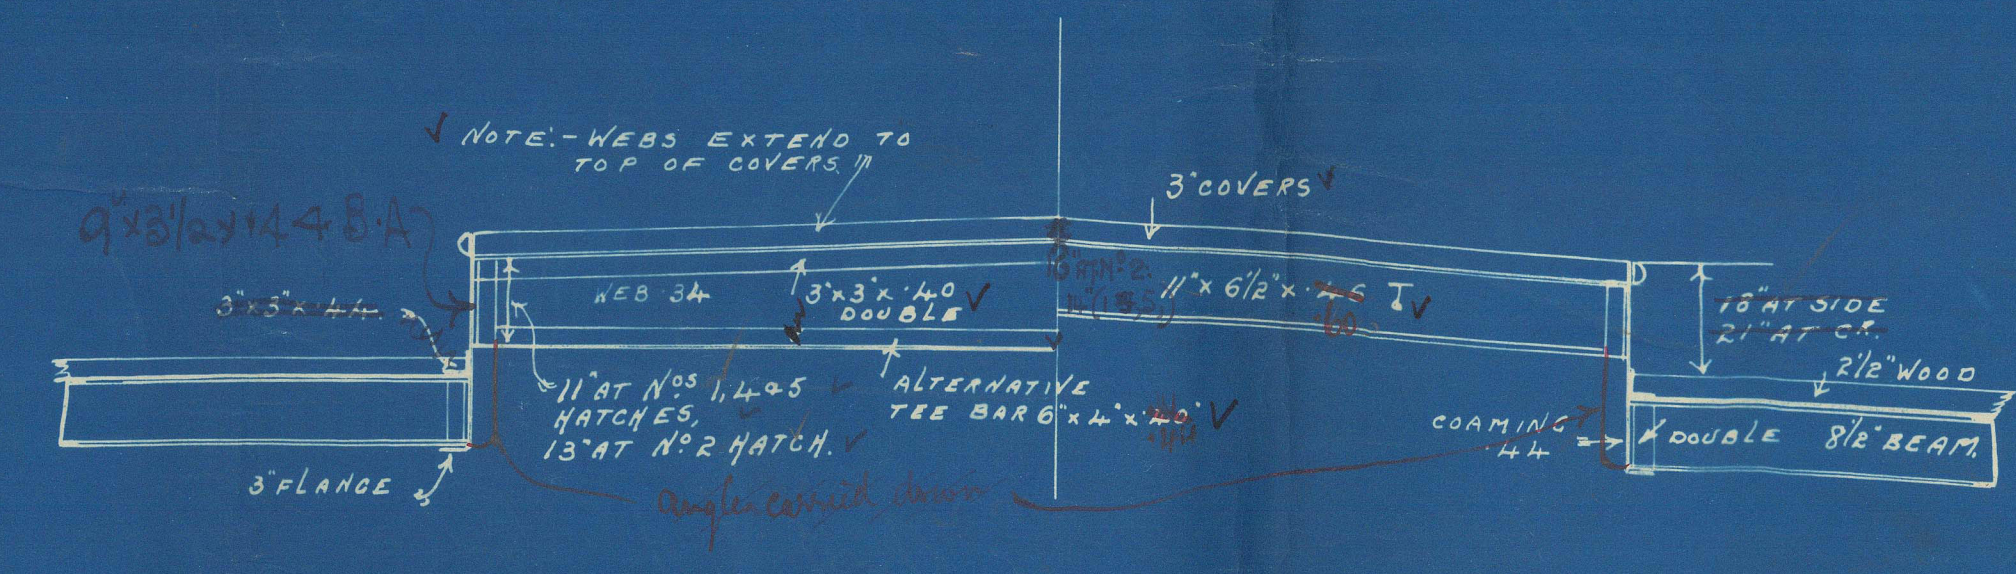



SECTION THRO N° 1, 2, 4 & 5 SHELTER D° HATCHES
SCALE $\frac{1}{2}'' = 1' - 0''$

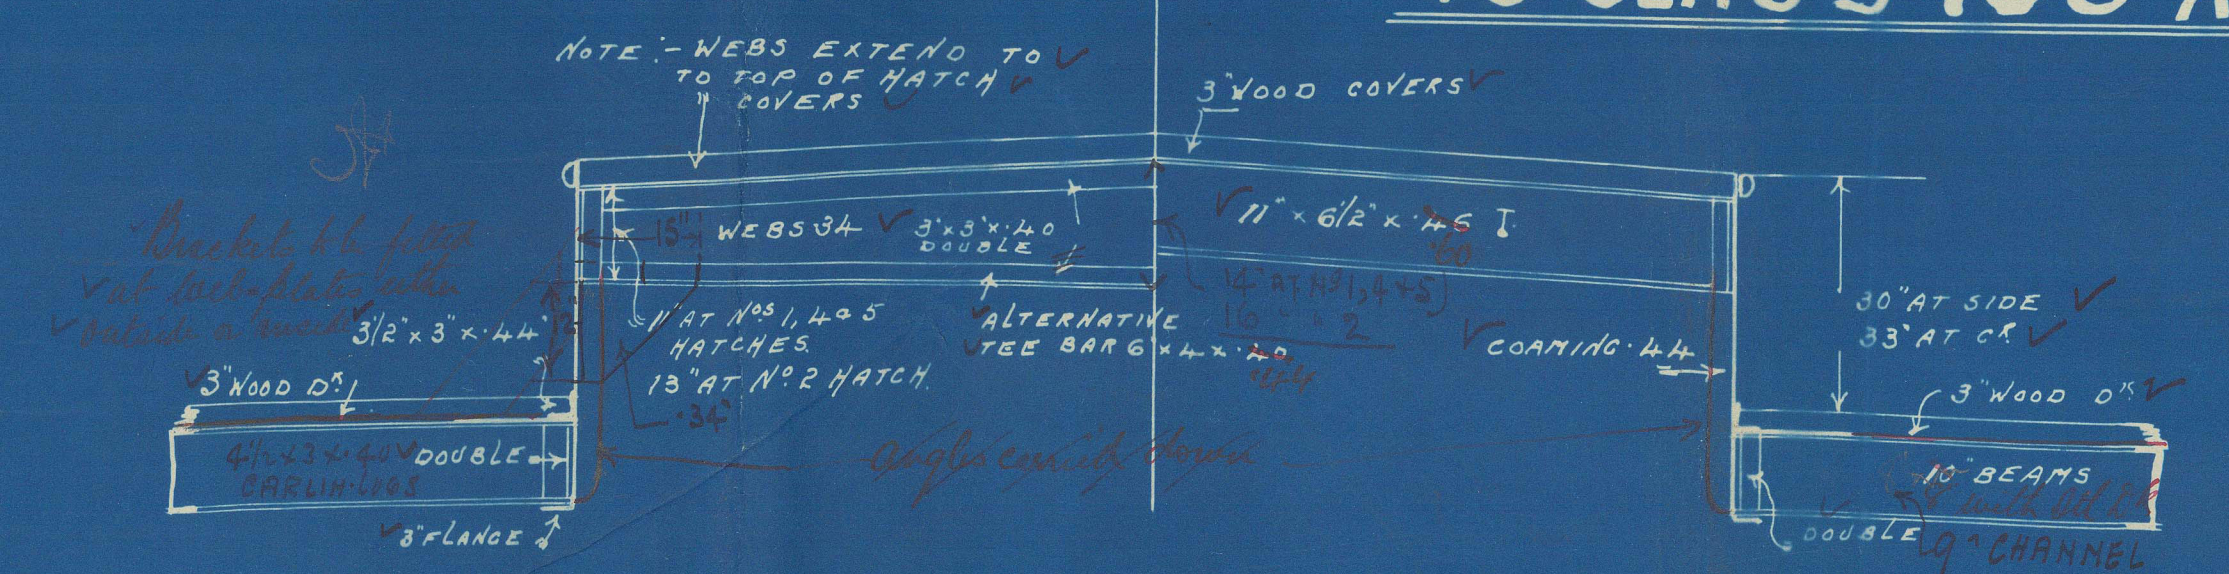

SECTION THRO N° 1, 2, 4 & 5 UPPER D° HATCHES
SCALE $\frac{1}{2}'' = 1' - 0''$

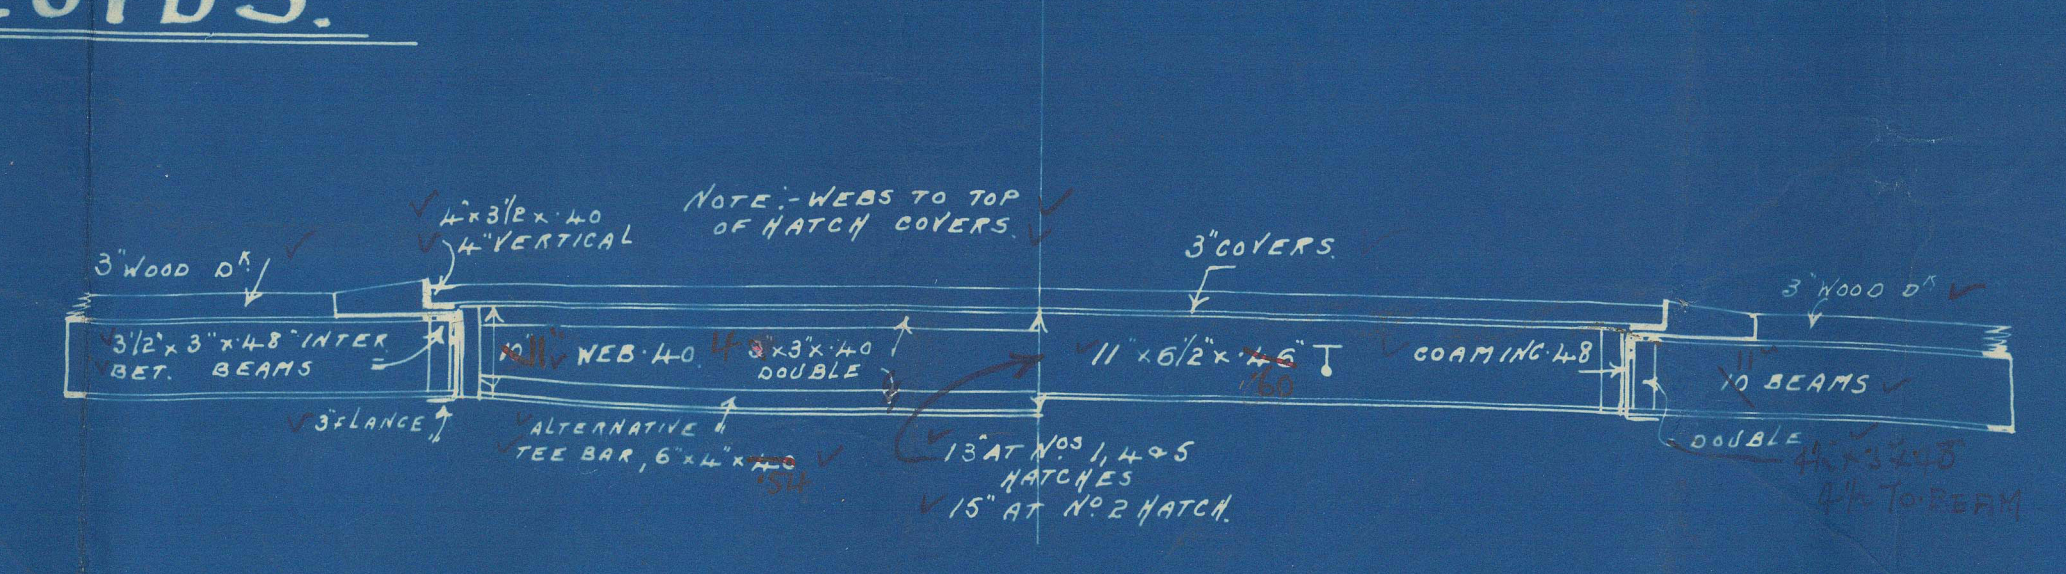

SECTION THRO N° 1, 2 & 5 MAIN D° HATCHES
SCALE $\frac{1}{2}'' = 1' - 0''$

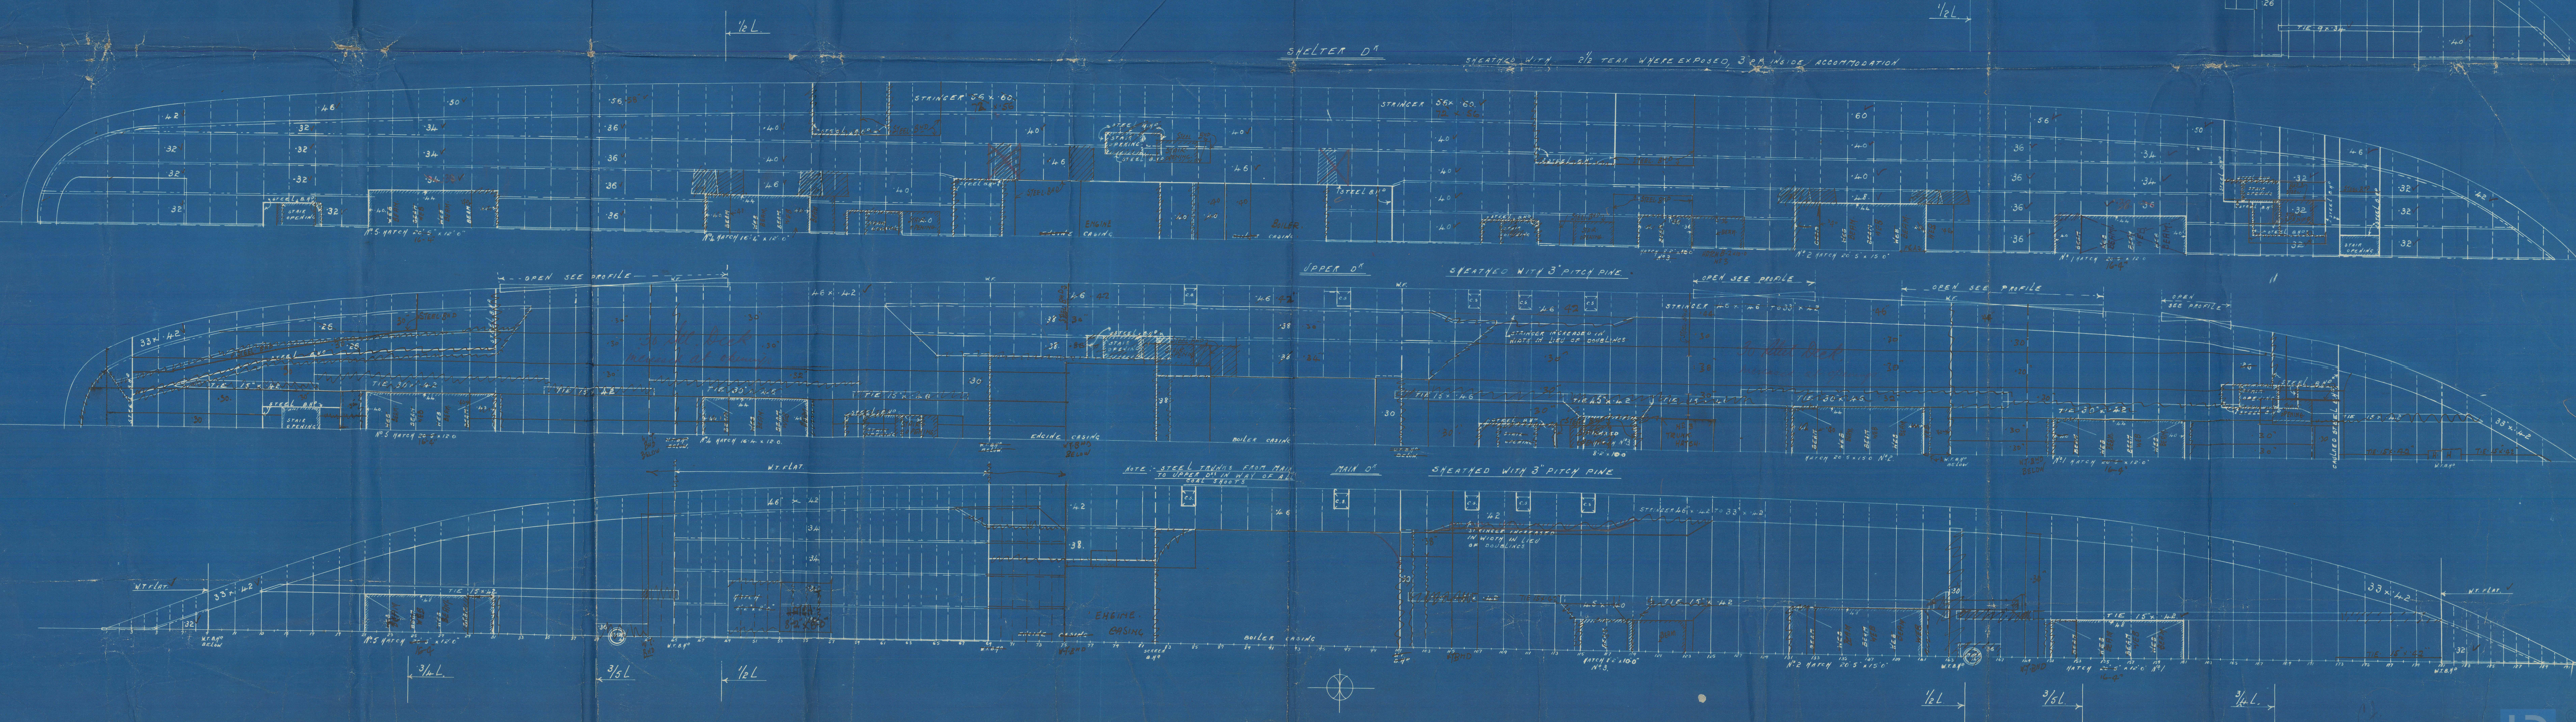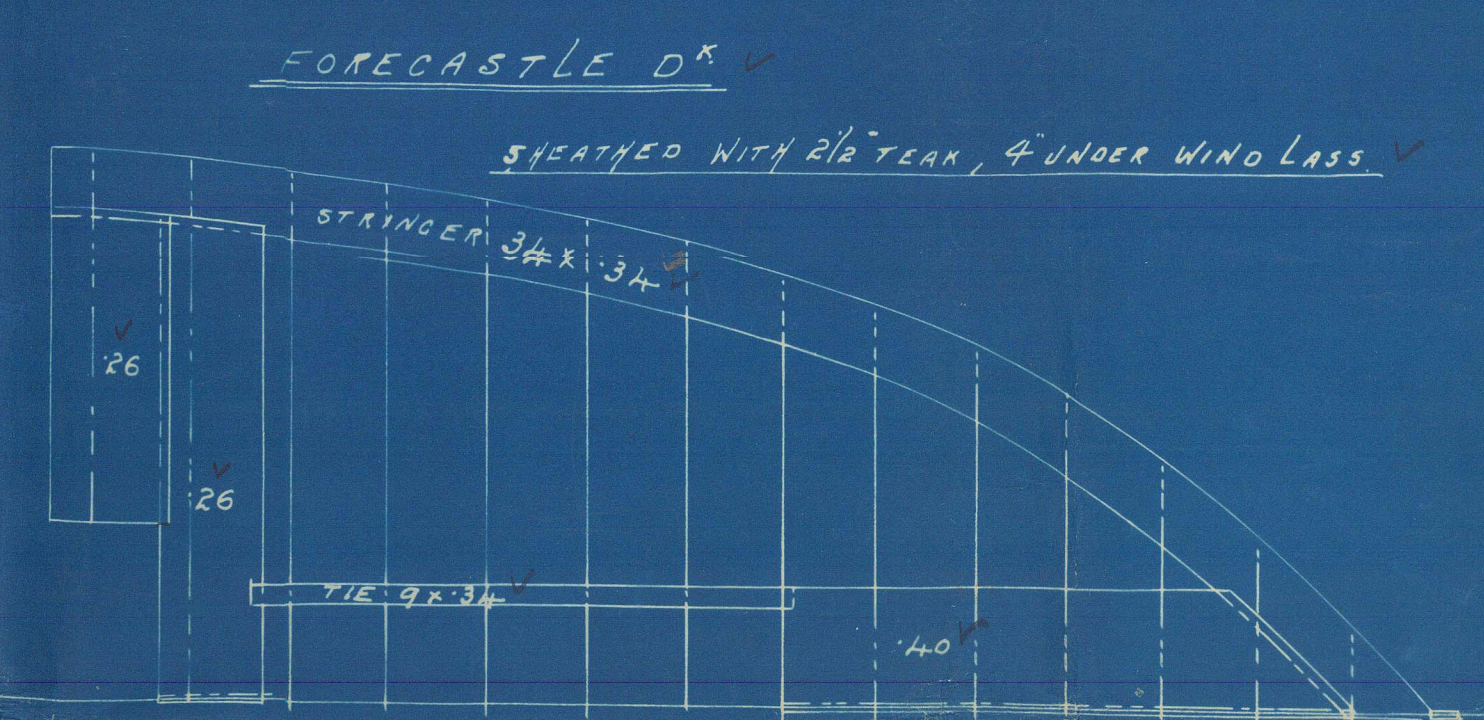

Barclay Curle & Co.





VSS N^o 483
1484

Deck Plans

CHILKA

GLASGOW REPORT No: 29384

COCONADA
356

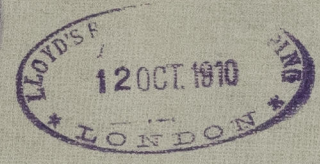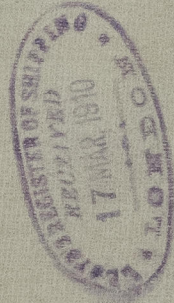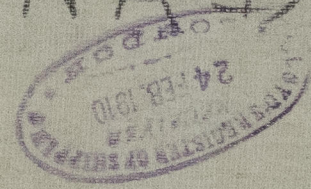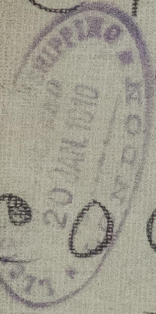

RETAILED

STEEL-DECKS.

4 LLOYDS. 483.

157



© 2021

Lloyd's Register
Foundation

1/87
LLOYDS. 483
STEEL-DECKS,

1/87
LLOYDS. 482
STEEL-DECKS,
© 2021 Lloyd's Register
Foundation