
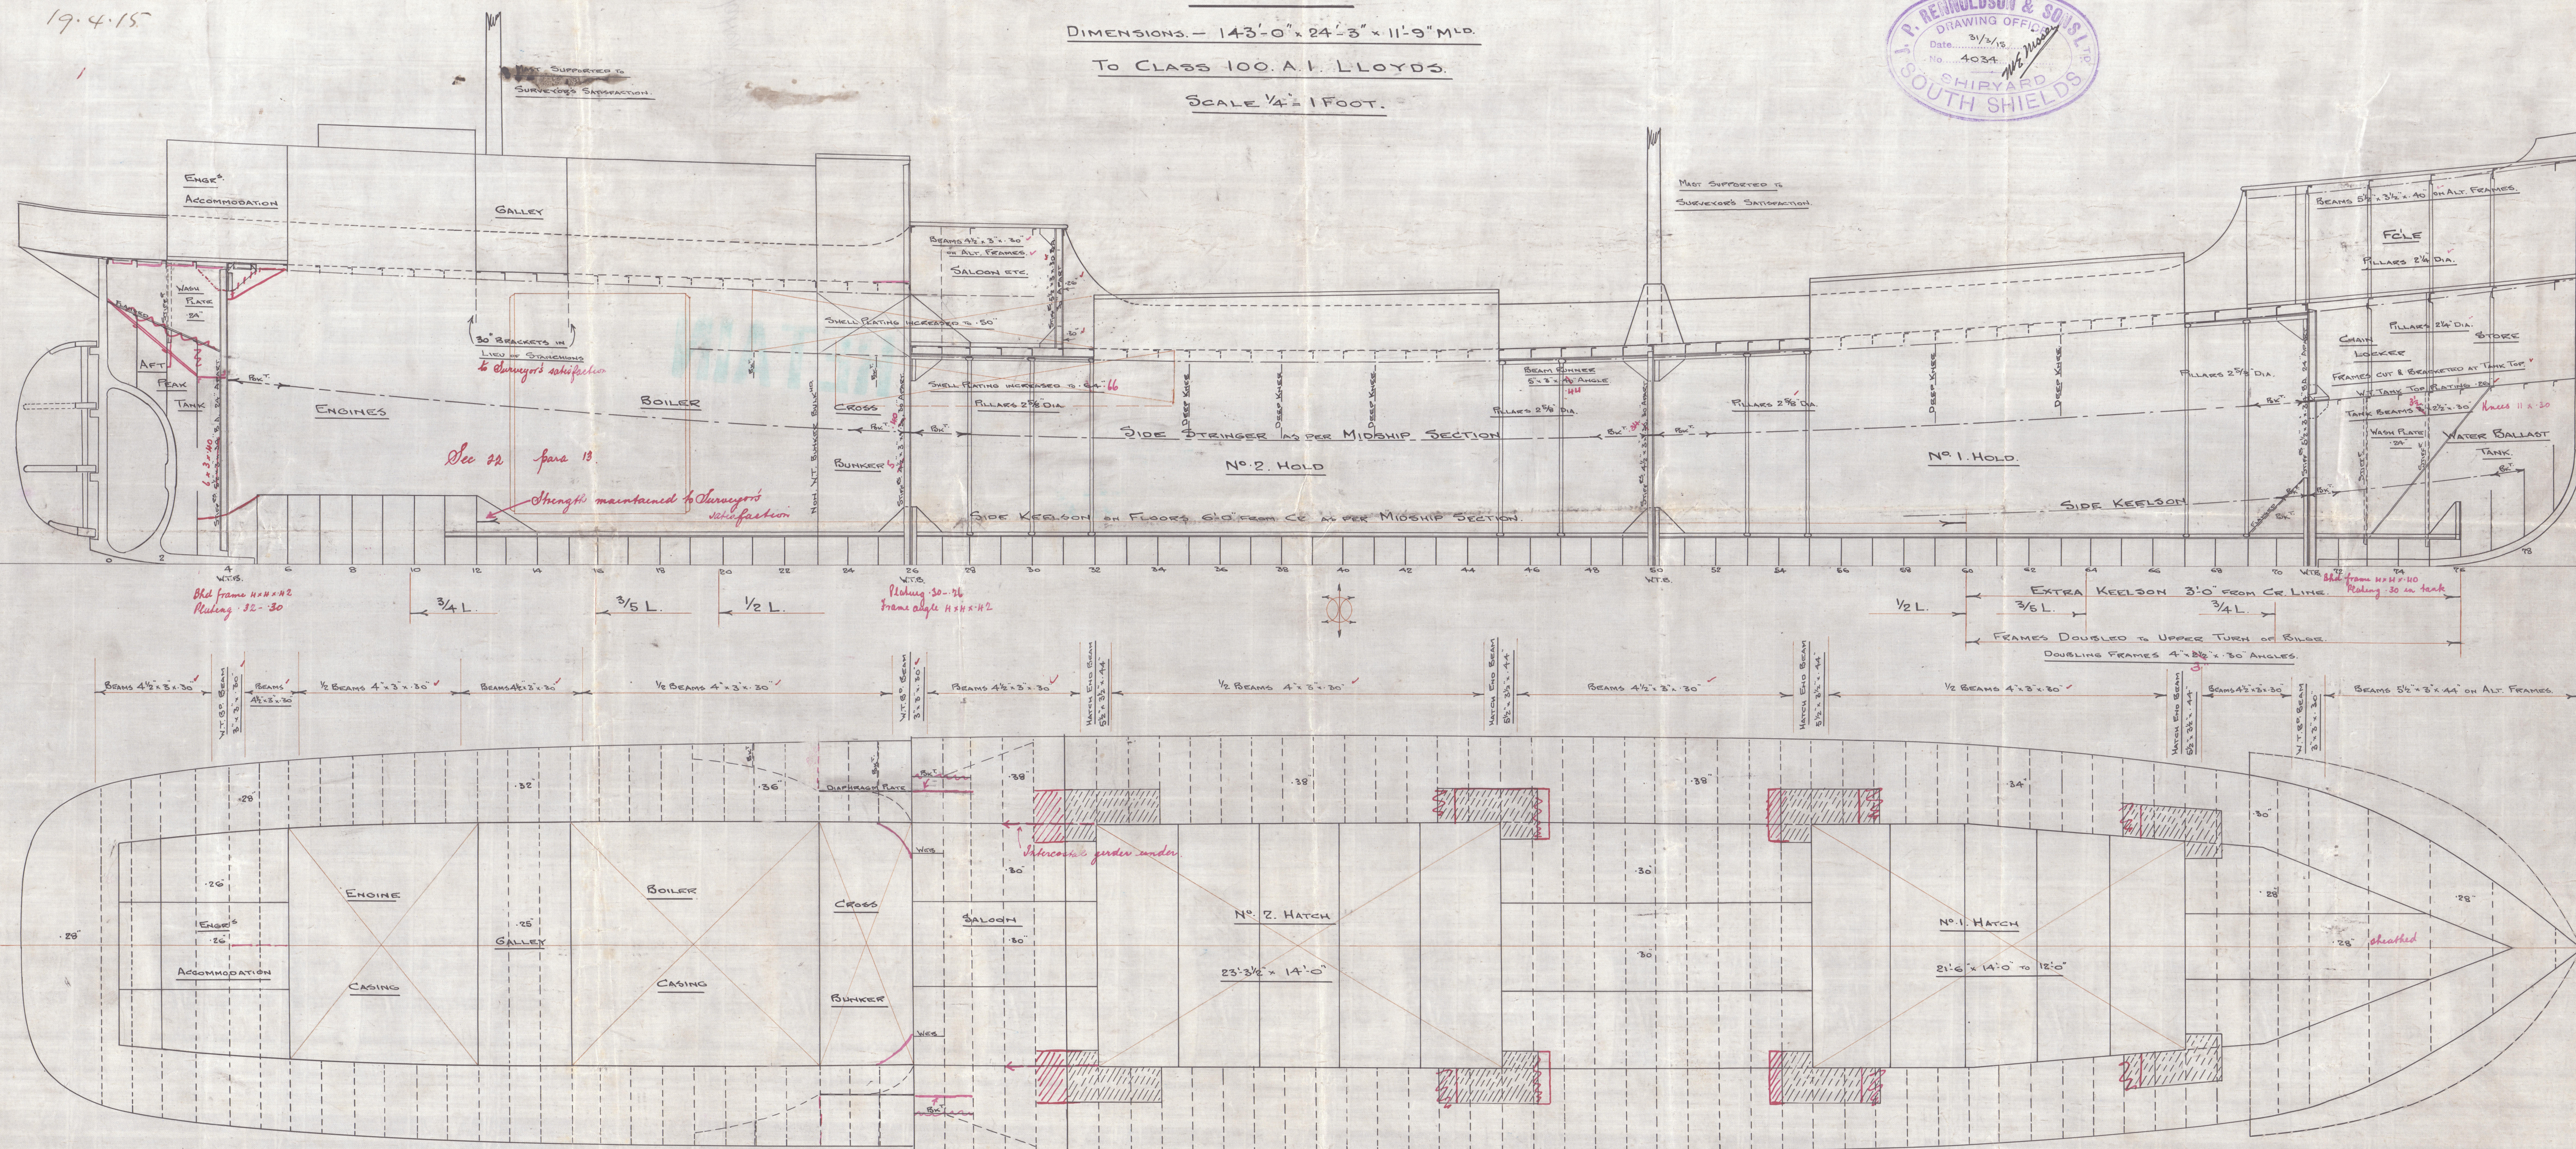


STEEL SCREW STEAMER

DIMENSIONS. - 143'-0" x 24'-3" x 11'-9" M.L.D.

TO CLASS 100. A. I. LLOYDS.

SCALE $\frac{1}{4}" = 1$ FOOT.

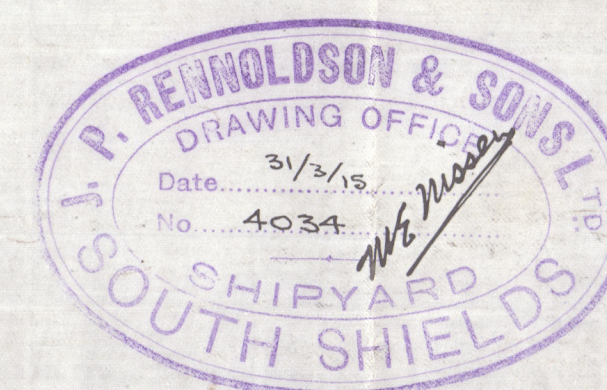

C.I.
[2-44-15]

S.S. N° 300

J.P. Remondron & Sons Ltd

Profile and Deck plan

Foamville

EX

SS. POLLY BRIDGE

NEWCASTLE ON TYNE.

Report No. 68725

Warren Field



© 2020

Lloyd's Register
Foundation

W1641-0123