
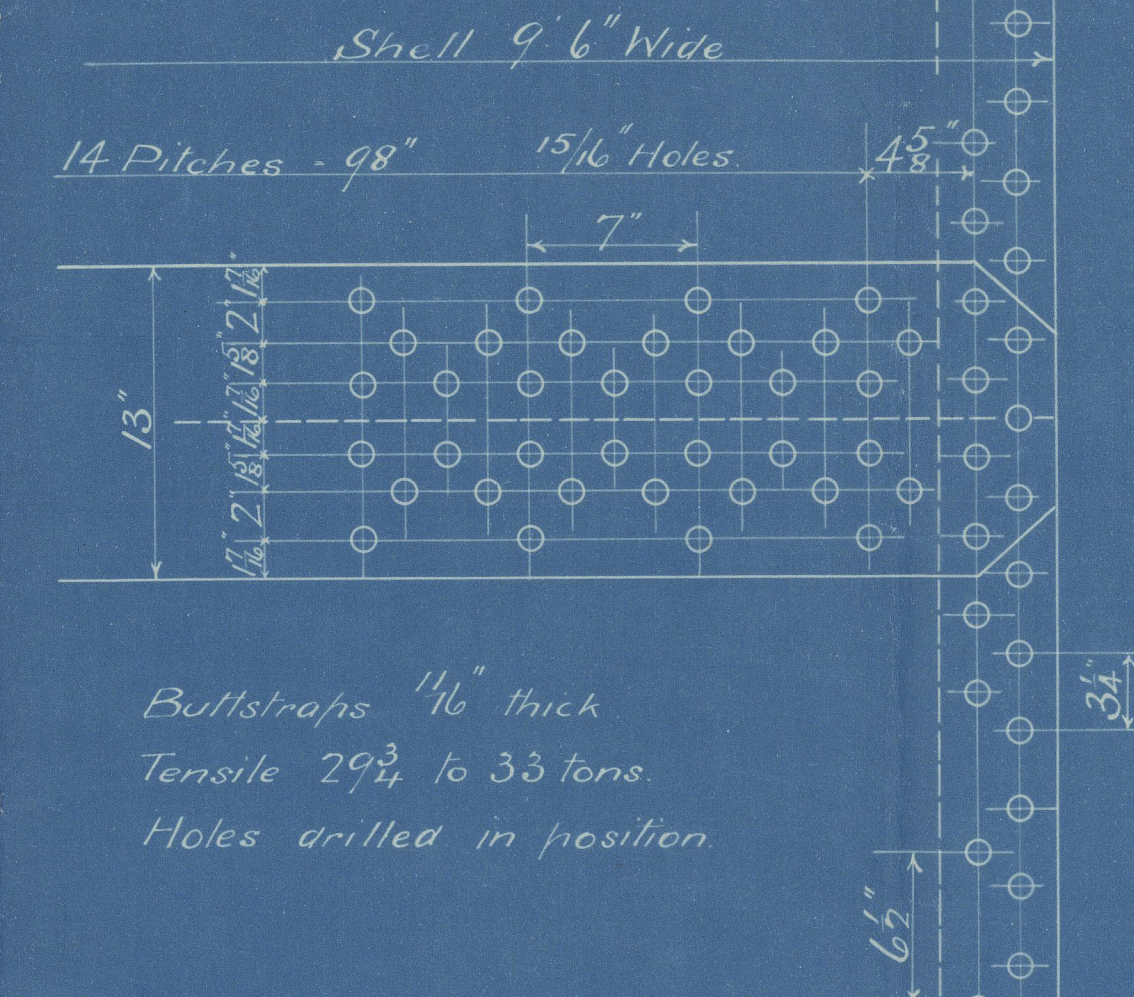
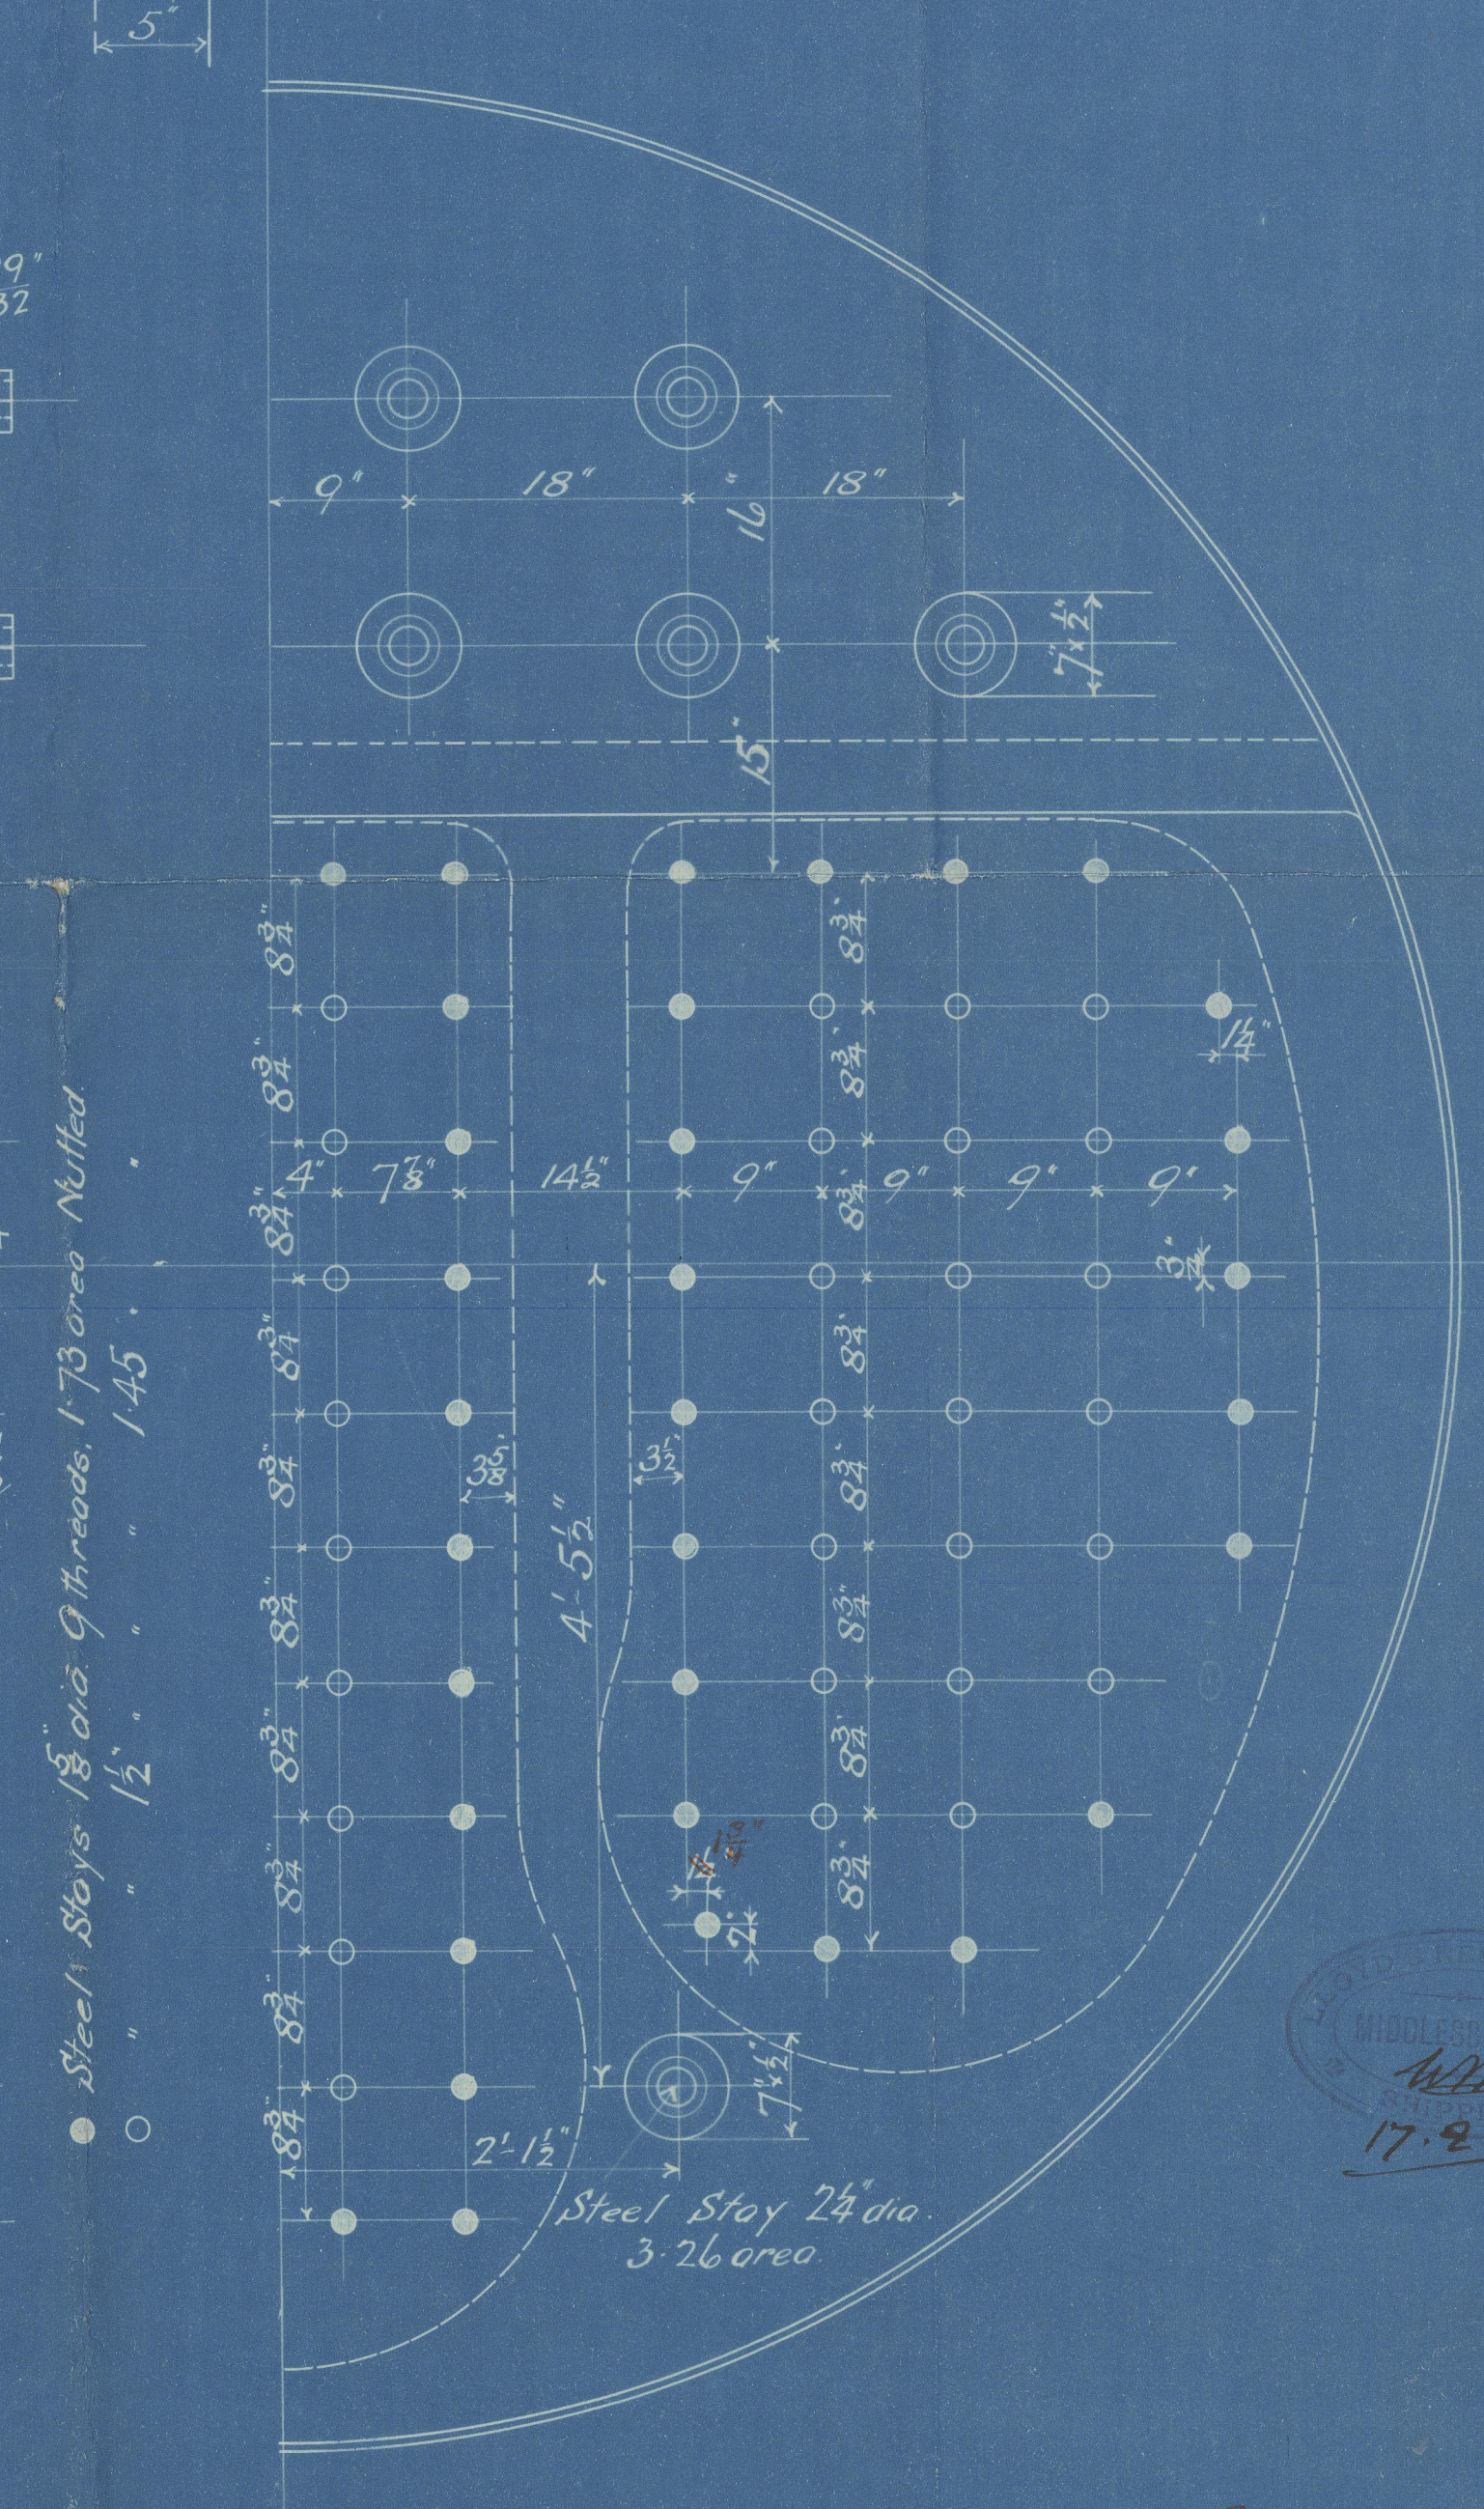
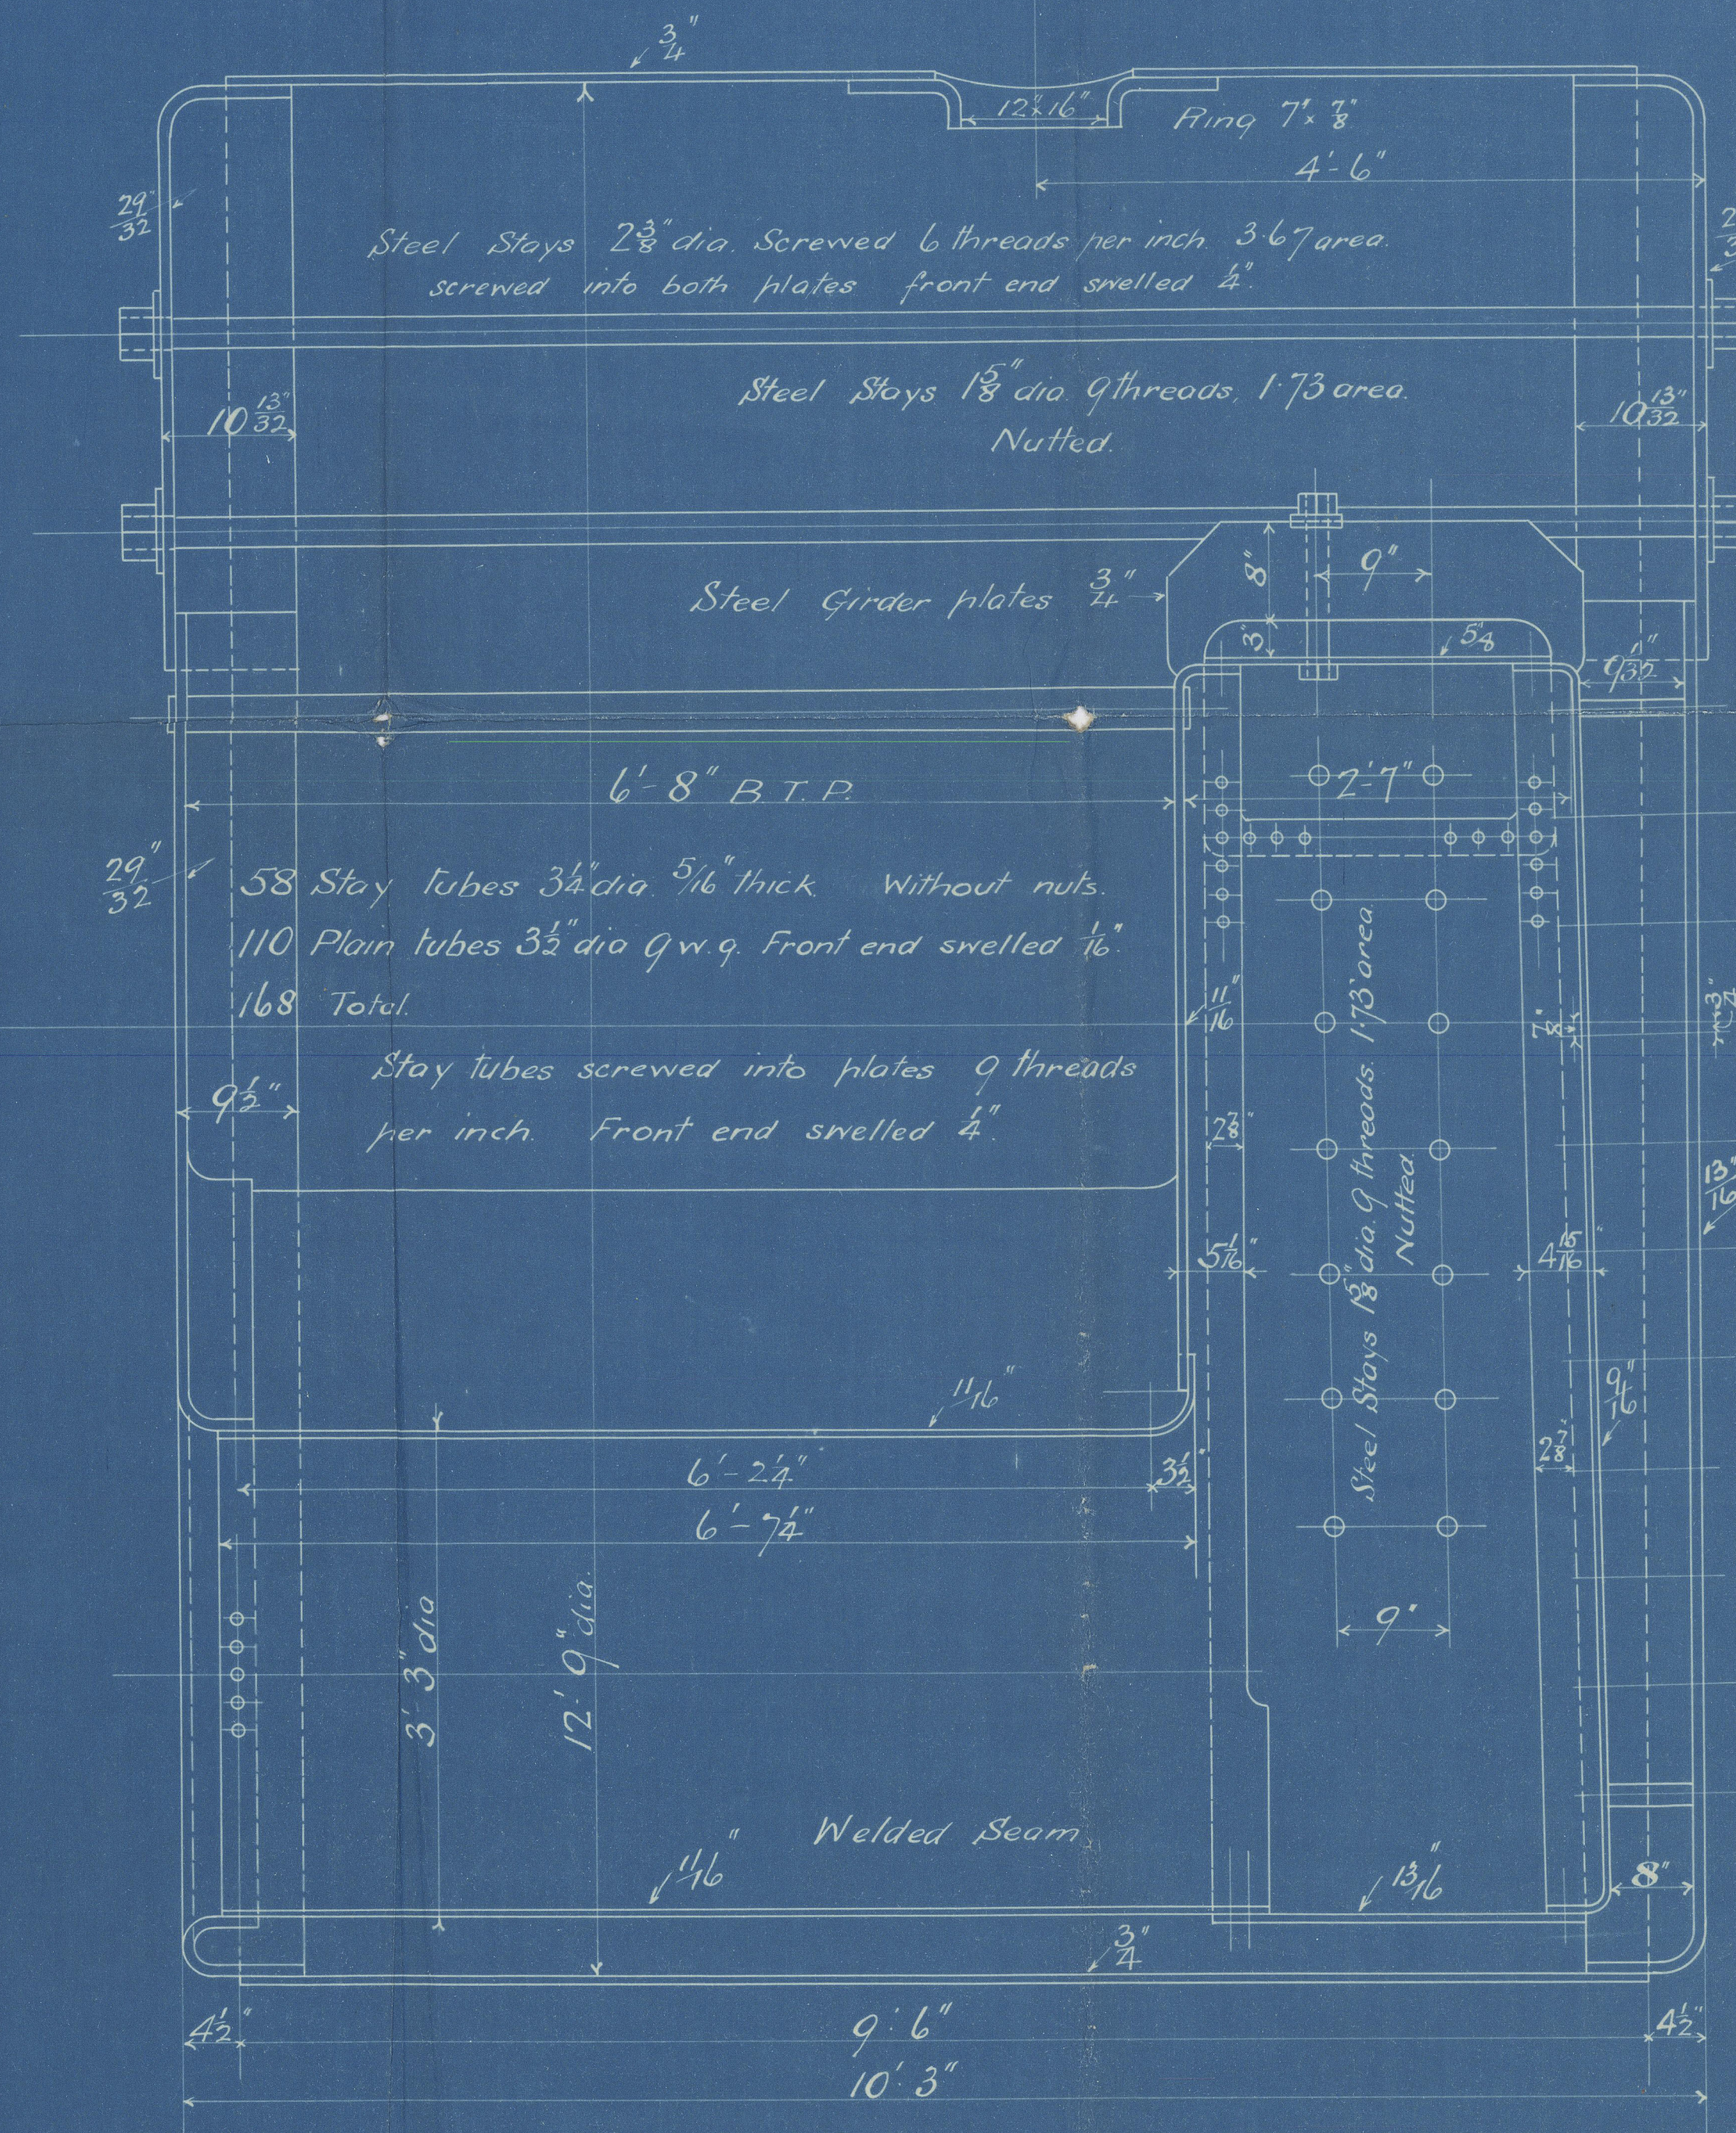


STEEL BOILER 12-9 DIA 10-3 LONG 130 LBS W.P.

LLOYDS

Nº 4840

18/2/15

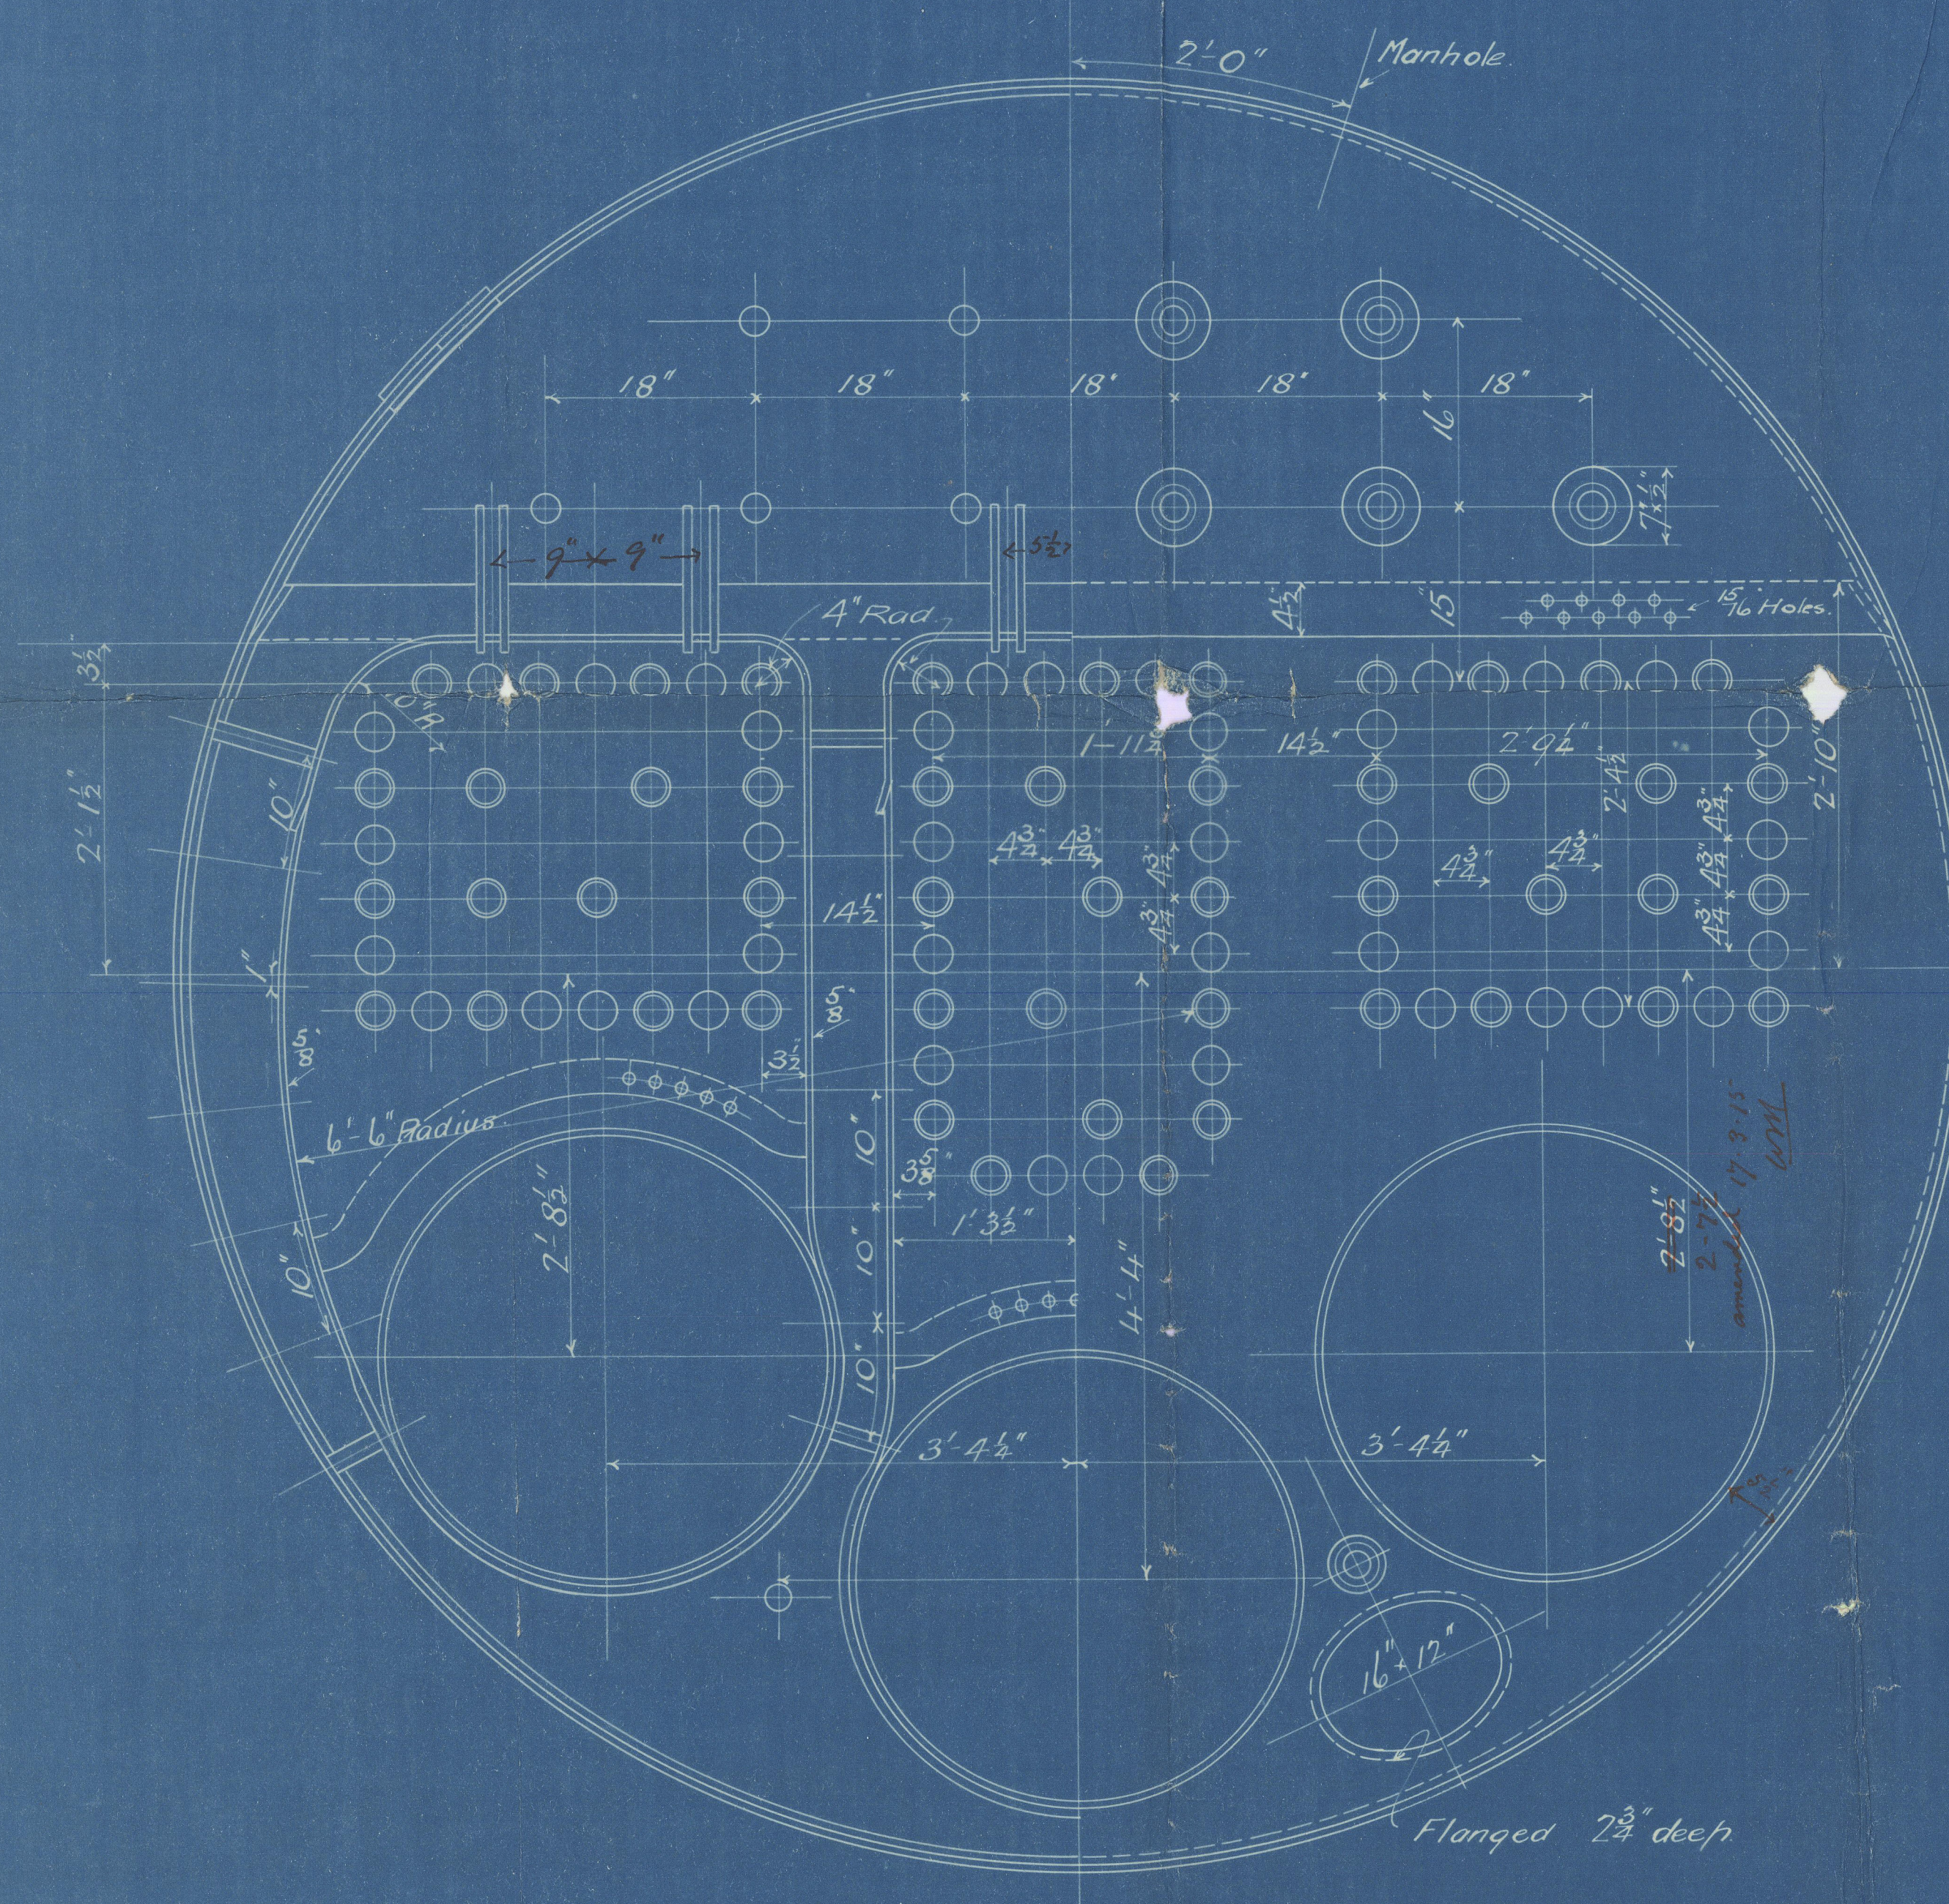

Circum Seams 1/16" Holes Double Riveting to be continuous below furnace line.

Heating Surface 1400 Sq. ft.  
Grate Area 5 1/4 bar 47 "

T.J.L. 18.2.15


RILEY BROS. (BOILERMAKERS) LTD  
STOCKTON ON TE



Messrs Riley Bros Lim<sup>d</sup>  
Boiler No. 4840  
for

Messrs J. P. Remondson & Sons Ltd.  
South Shields

Working Press 130 lb

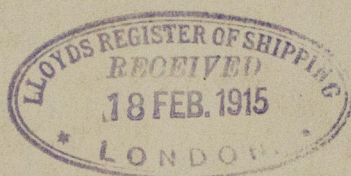

No. 5596
LLOYD'S TEST
260 lbs.
23.12.15 - W.M.

"Foamville"  
Ex

S S Polly Bridge

Hull  
NEWCASTLE ON TYNE.

Report No. 68725

RETAIN



© 2020

Lloyd's Register  
Foundation

W1641-0124