

— Midship section —

CLASS 100 A.1 LLOYDS (STEEL)

EQUIPMENT.

FRAMES IN E. ROOM  
3" x 3" x 7/20" Sand R.

$\frac{1}{2} \times \frac{1}{2} = \frac{1}{4}$

79-80

2000

68-18

\_\_\_\_\_

\_\_\_\_\_

Scale  $\frac{1}{2}'' = 1'-0''$ .


NEDERLANDSCHE  
SCHEEPSBOUW-MAATSCHAPPIJ  
AMSTERDAM

 Lloyd's Register  
Foundation.




Midship section.  
St. Helens

Ans 20<sup>97</sup> 19<sup>98</sup>

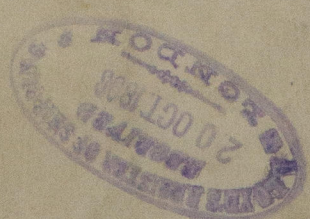

RETAIN

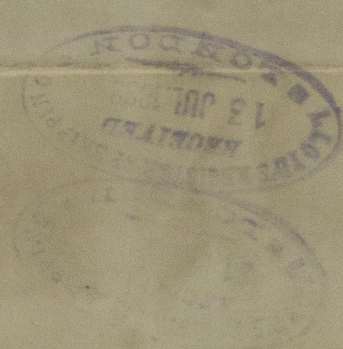

W1641-0147