


STEEL

NUMERAL FOR RUDDER ~~08 53~~. SPEED 10 1/2 KNOTS

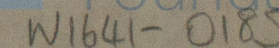

N^o. 318-319



MIDSHIP SECTION

COOK WELTON & GEMMELL


S/S King's Grey Hull Rpl No. 28509

~~Jellicoe~~ - - - 28639

Jellicoe

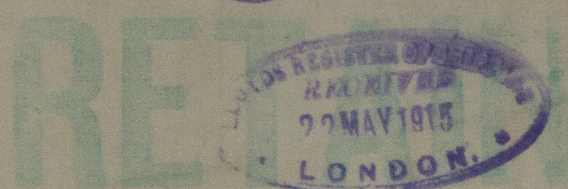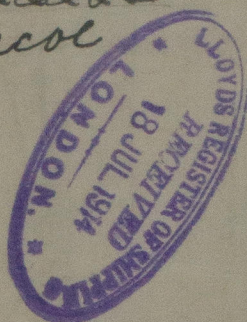

W1641-0185

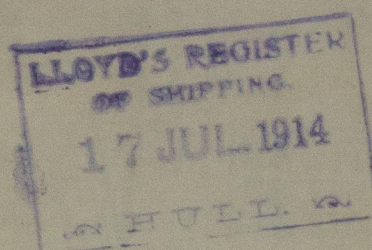

© 2020

Lloyd's Register
Foundation