

Rpt. 6.

For the information of Surveyors and the Committee only.

Received at

Office,

19

# Lloyd's Register of British & Foreign Shipping.

(Report on Vessel No. 31509 Port GLASGOW)

No. 4813

## SHIP FORGINGS OR CASTINGS.

*1/2 "Kirkoswald"*

*now aqua marina*

I have to report that the undermentioned Iron or Steel Forgings or Castings, manufactured by Dennystown Forge Co of Dumbarton for the Vessel No. 444, being built by Messrs A Mc Millan & Sons of Dumbarton have been inspected by me as set forth below and found to be, so far as can be seen, Sound.

The words FORGINGS or CASTINGS, IRON or STEEL, should be struck out, as may be required.

Mark on Forgings or Castings.

Lloyd's  
No. 4813  
J.D.


*J Dale*

*29/9/11*

*Glasgow*

	STERN FRAME.	RUDDER FRAME.	STEM.
Material*	<i>Scrap iron</i>	/	/
How made	<i>Forged &amp; smithed</i>	/	/
Dimensions	<i>10 x 7 1/2 9 x 7 1/2</i>	/	/
Progress on Inspection	<i>Forging &amp; smithing</i>	/	/
Date when Inspected	<i>3/8/11</i> <i>29/9/11</i>	/	/
CASTINGS.			
Tensile Test—			
Tons per square inch			
Extension in Sins. per cent.			
Cold Bending Test—			
Angle before fracture			
Drop Test—			
Height from ground			
Hammering Test—			
If made according to Rules and found satisfactory			

SKETCHES OF FRAMES SHOWING POSITION AND DESCRIPTION OF WELDS OF FORGINGS.

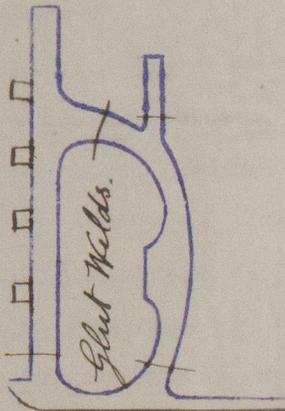

Fee (if any chargeable) £ NIL (Vessel Classed)

To be paid at

*Weight*

© 2020

*ton out of the*  
*9.6.1.2*

Lloyd's Register Foundation

\* If of Iron, state whether scrap or puddled Iron.

*W1642-0070*

Im.10.10. T.

Diameter \_\_\_\_\_ Length \_\_\_\_\_ Thickness of shell plates \_\_\_\_\_  
 Pitch of rivets \_\_\_\_\_ Working pressure of shell by rules \_\_\_\_\_ Diameter of flue \_\_\_\_\_ Material of flue plates \_\_\_\_\_