


Amended plan
of
Main Boiler No 202
by
Rankin & Blackmore
for
A Mexican Vessel No 4444
180 lbs working pressure

Furnaces

Port Boiler
PW No Y 402
and - Y 399
SW - Y 407

Star Boiler
PW No Y 404
Curtis Y 401
SW 1 Y 400

Center Boiler
PW No Y 405
Curtis - Y 403
SW - 402

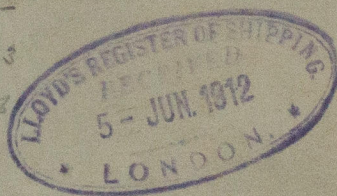

S. Kirkoswald
Greenock Report No. 16254

Amer Maria Hummer



© 2020
Lloyd's Register
W1642 - 0087
Foundation