

LENGTH B.P. 195' 0" BREADTH MLD 30' 0" DEPTH MLD 14' 0"

SCALE $\frac{1}{2}'' = 1\text{-Foot.}$

10/5/71

EQUIPMENT NUMBER 12378.

2 BOWER ANCHORS STOCKLESS	9 CENTS	} 54 1/2 CENTS!
" " "	6 1/2 "	
COLLECTIVE.		

1 STREAM " EX STOCK 5/4 ✓

1 KEDGE " " " " 2 1/2 ✓


210 FATHOMS OF 1 1/16" STUD CHAIN CABLE. ✓

60	"	"	14/16	STREAM	"	OR 3/4	STEEL WIRE.	✓
90	"	"	2	HEMP	OR	3	"	"

90	"	"	6 HAWSER OR	2 1/4	"	"	"
----	---	---	-------------	-------	---	---	---

90 " " 5 WARPS OR $1\frac{1}{2}$ " " 15 con

✓
✓
with owner's
consent to steel wire.

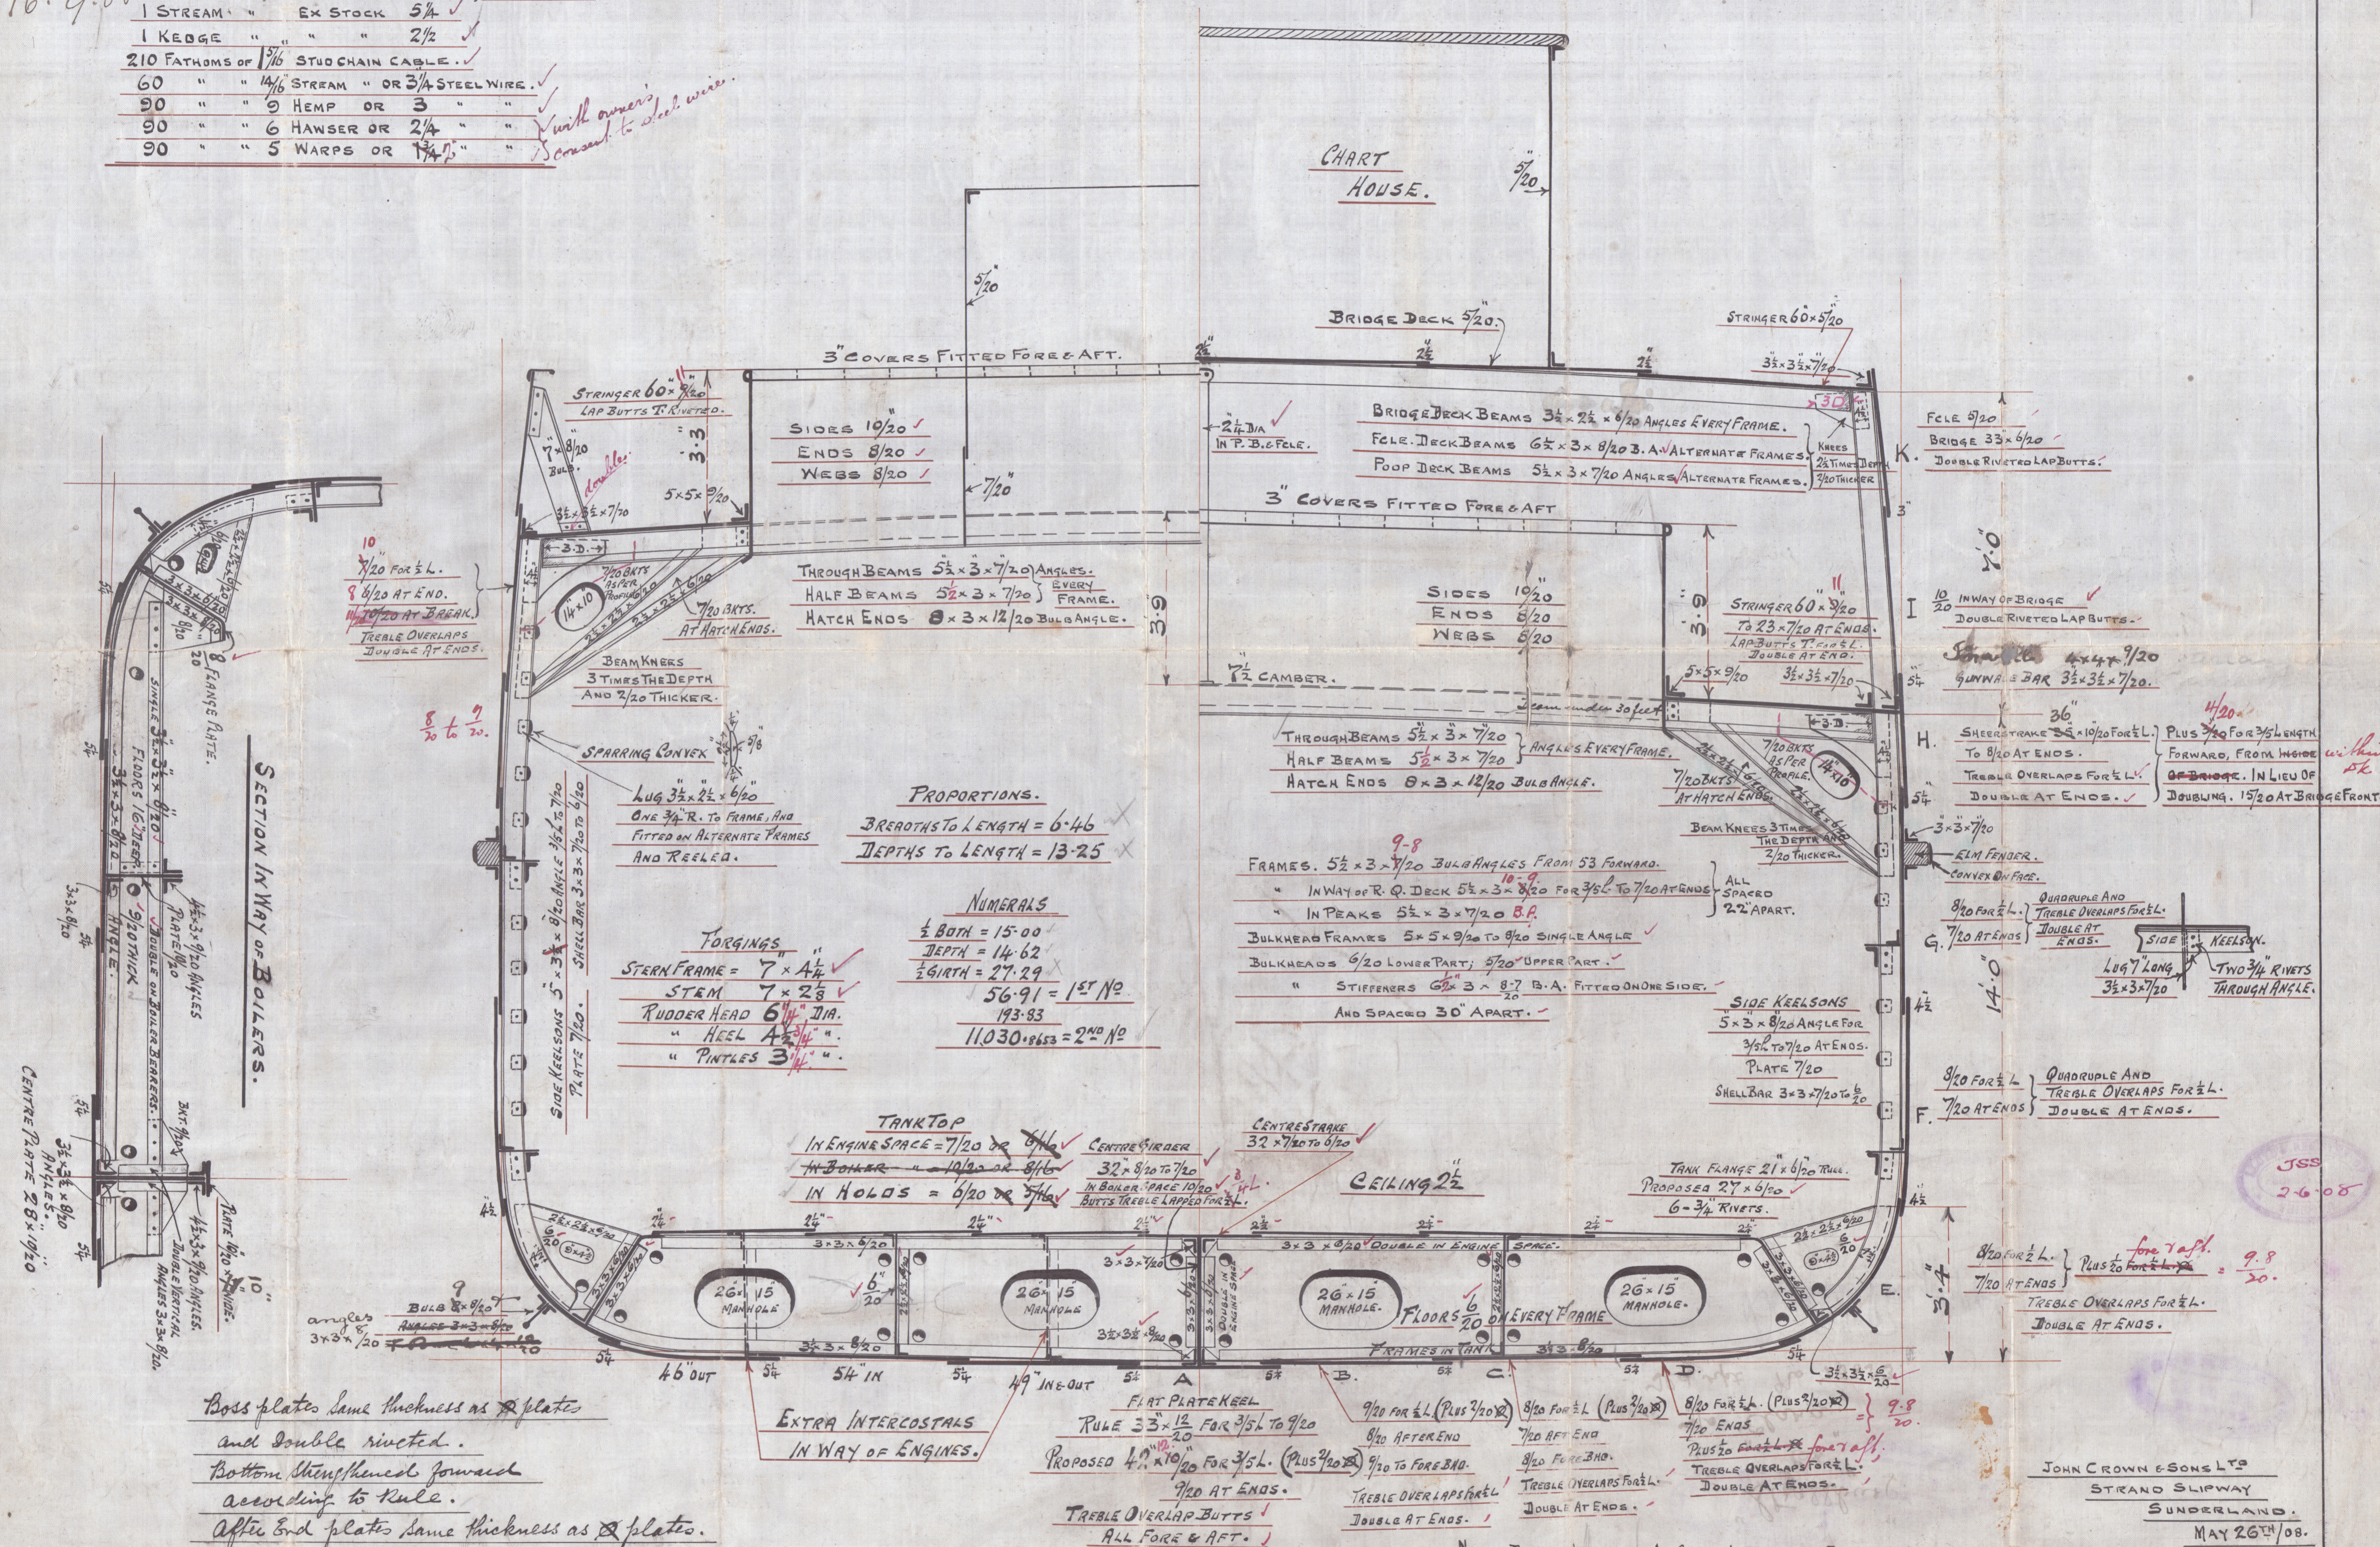

Boss plates same thickness as ~~2~~ plates
 and double riveted.
 Bottom strengthened forward
 according to Rule.
 After End plates same thickness as ~~2~~ plates.

NOTE:- BOTTOM INCREASED AS SHOWN IN BRACKETS FOR LYING AGROUND.

JOHN CROWN & SONS LTD
STRAND SLIPWAY
SUNDERLAND.
MAY 26TH/08.

© 2020

100

Lloyd's Register
Foundation 0280

J. Crown & Sons

No 128

Section

"Strassburg"

Ex

s/o "Clara"

2d apt No 23853.

Disclass Bay 194



© 2020

Lloyd's Register
Foundation