


Nº 128.

5. 6. 08
25. 7. 08
16. 9. 08

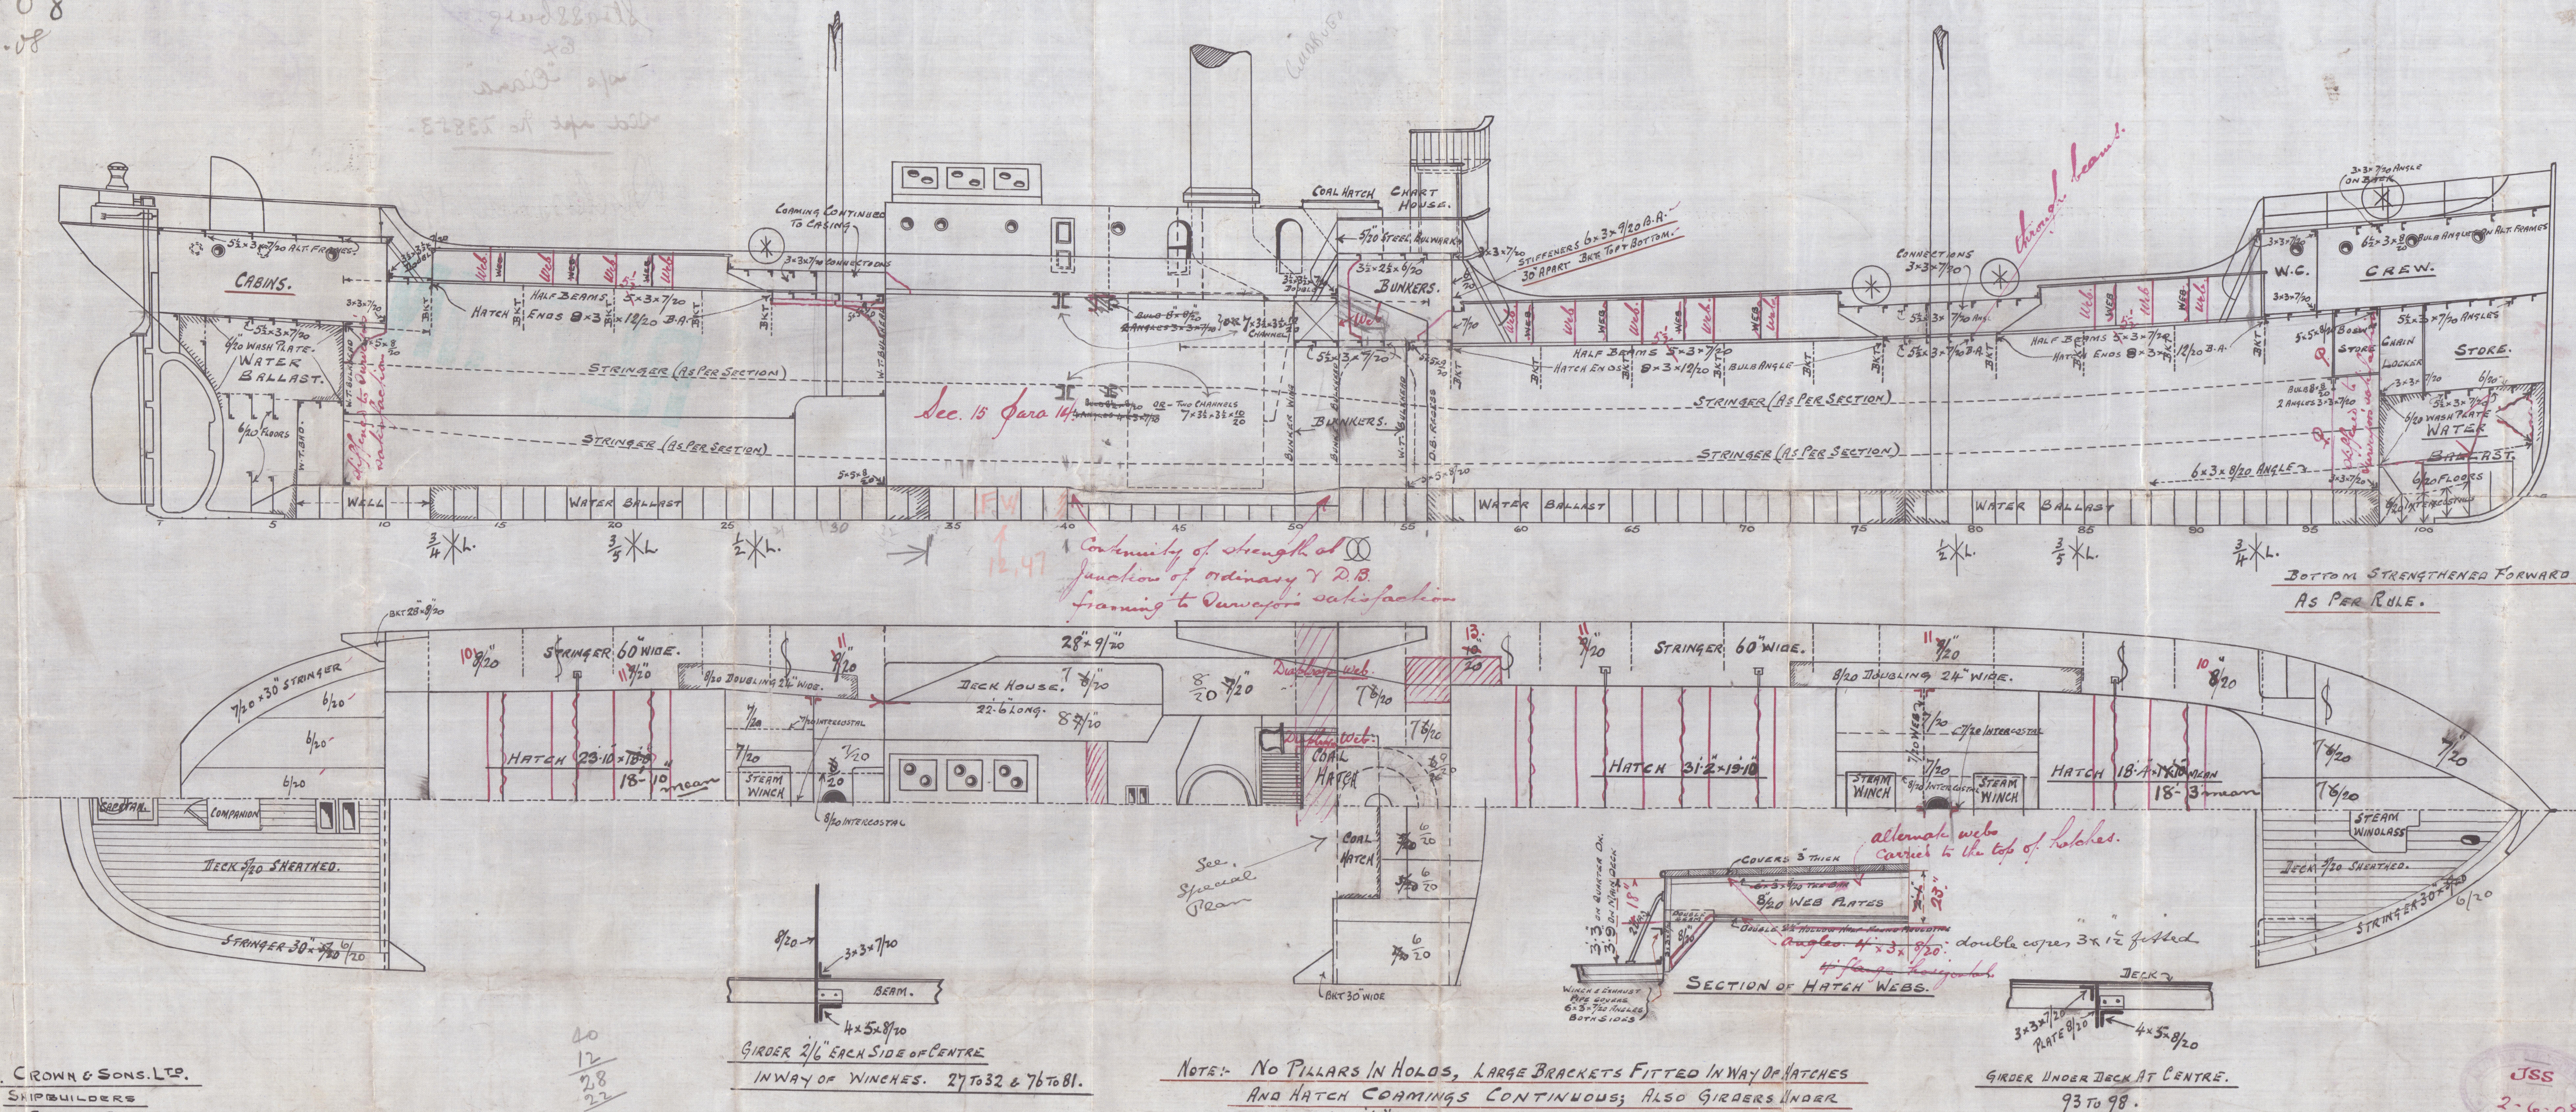

JOHN. CROWN & SONS. LTD.
SHIPBUILDERS
STRAND SHIPWAY
SUNDERLAND
MAY 26TH/08.

NOTE:- NO PILLARS IN HOLDS, LARGE BRACKETS FITTED IN WAY OF HATCHES AND HATCH COAMINGS CONTINUOUS; ALSO GIRDERS UNDER BEAMS AT 2'6" EACH SIDE OF CENTRE IN WAY OF WINCHES.

GIRDER UNDER DECK AT CENTRE.
93 TO 98.

JSS
2-6-08



© 2020
Lloyd's Register
Foundation
W1642 0287

J. Crown & Sons

No. 128

Profile of
Deck.

"Strassburg"

Ex

s/s "Clara"

Sled apt No 23853.

Disclass Bay 194

LR

© 2020

Lloyd's Register
Foundation