

21.11.12
10.1.13
14.8.13

S.S. N^o 107.

180'-0" x 28'-0" x 14'-6"


LONGITUDINAL SECTION

TO CLASS 100 A1, LLOYDS.


SCALE 7/8" = 1'-0"

Pillaring under winches to
Surveyors Satisfaction

VAN LIET & C^o
HARDINXVELD
HOLLAND.

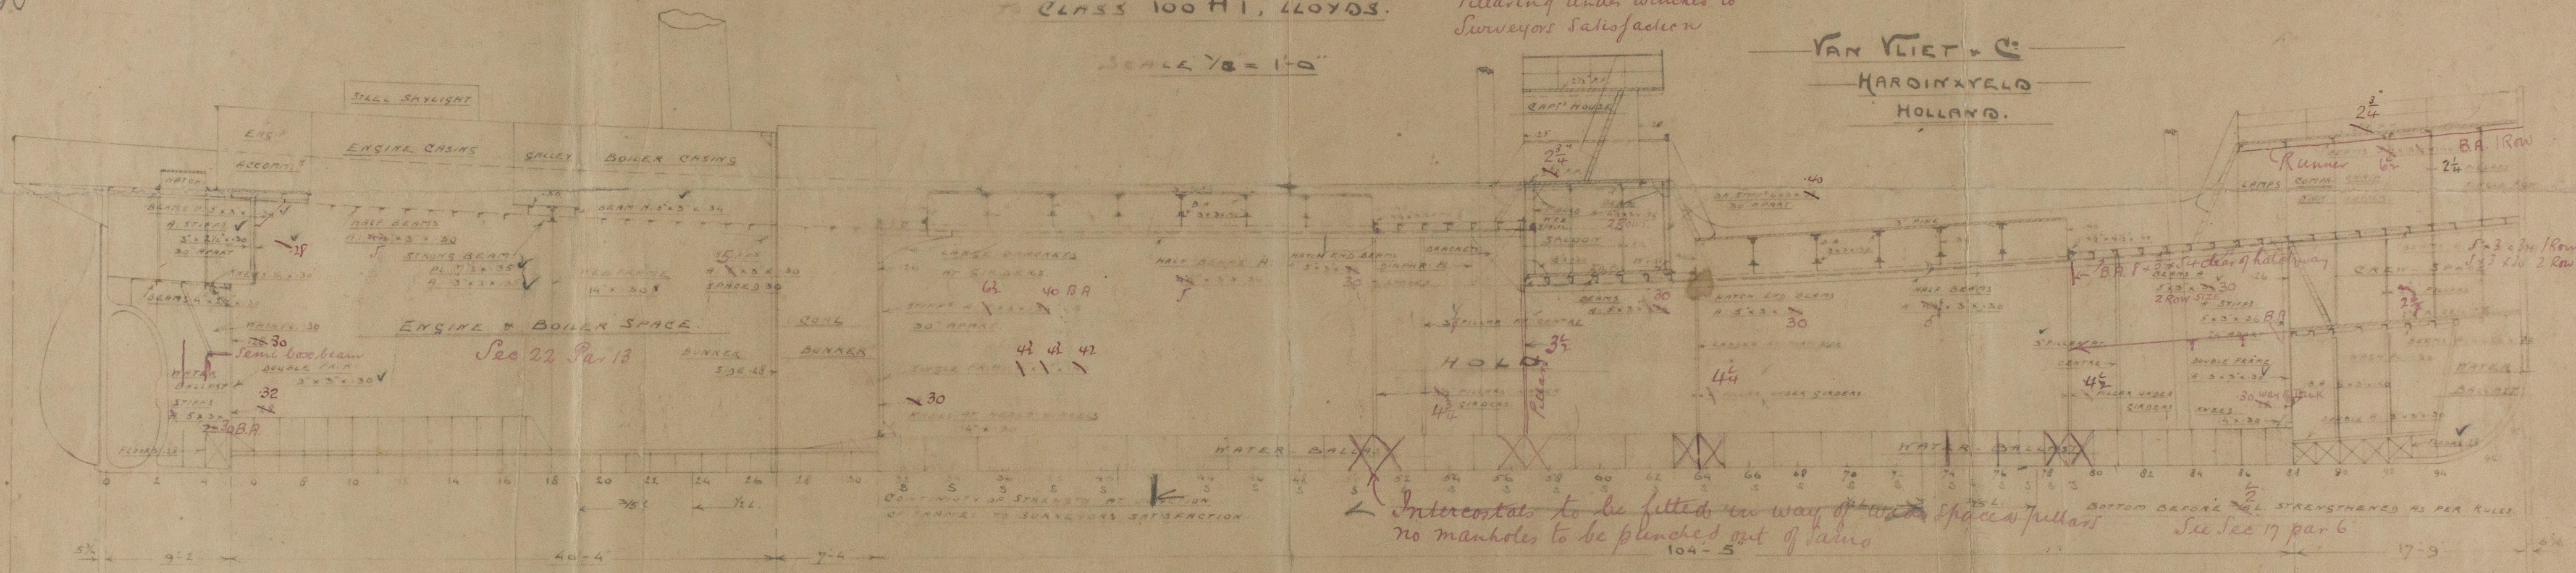

Framing increased 4H in thickness
in way of 33'0 hatch

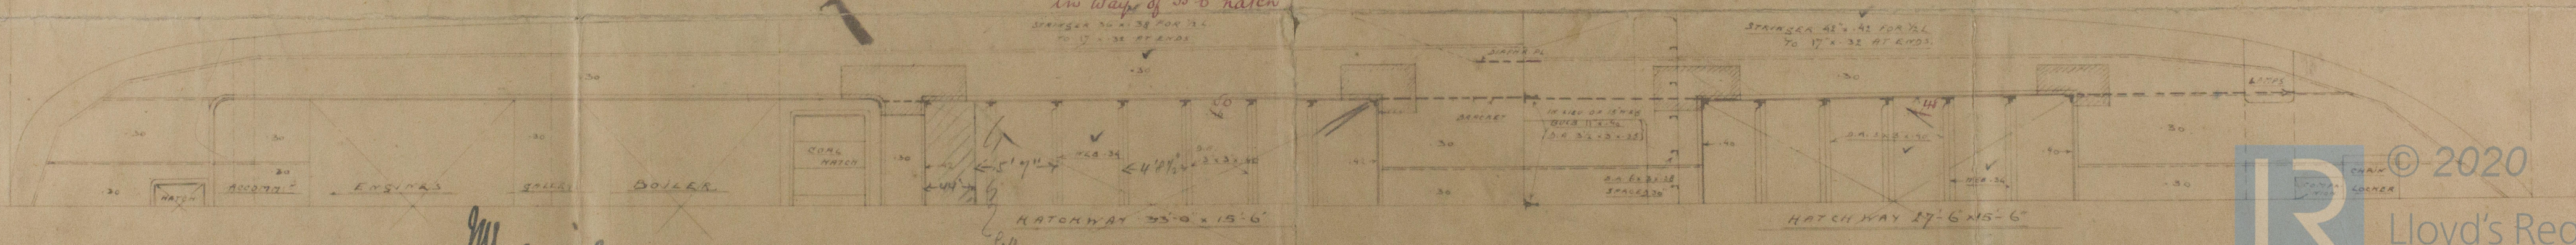

21.11.12

"Gelder. Rose"

Rott 8809.

Profile. & Dk.

NN. aRenside

now

RIVERSIDE

RETR



© 2020

Lloyd's Register

Foundation

W1642 - 03/1