

MIDSHIP SECTION



S.S. N°130

SCALE 1/2" = 1 FOOT

TO CLASS 100 A1 AT LLOYDS

STEEL RULE

28.9.99
6.10.99
17.10.99

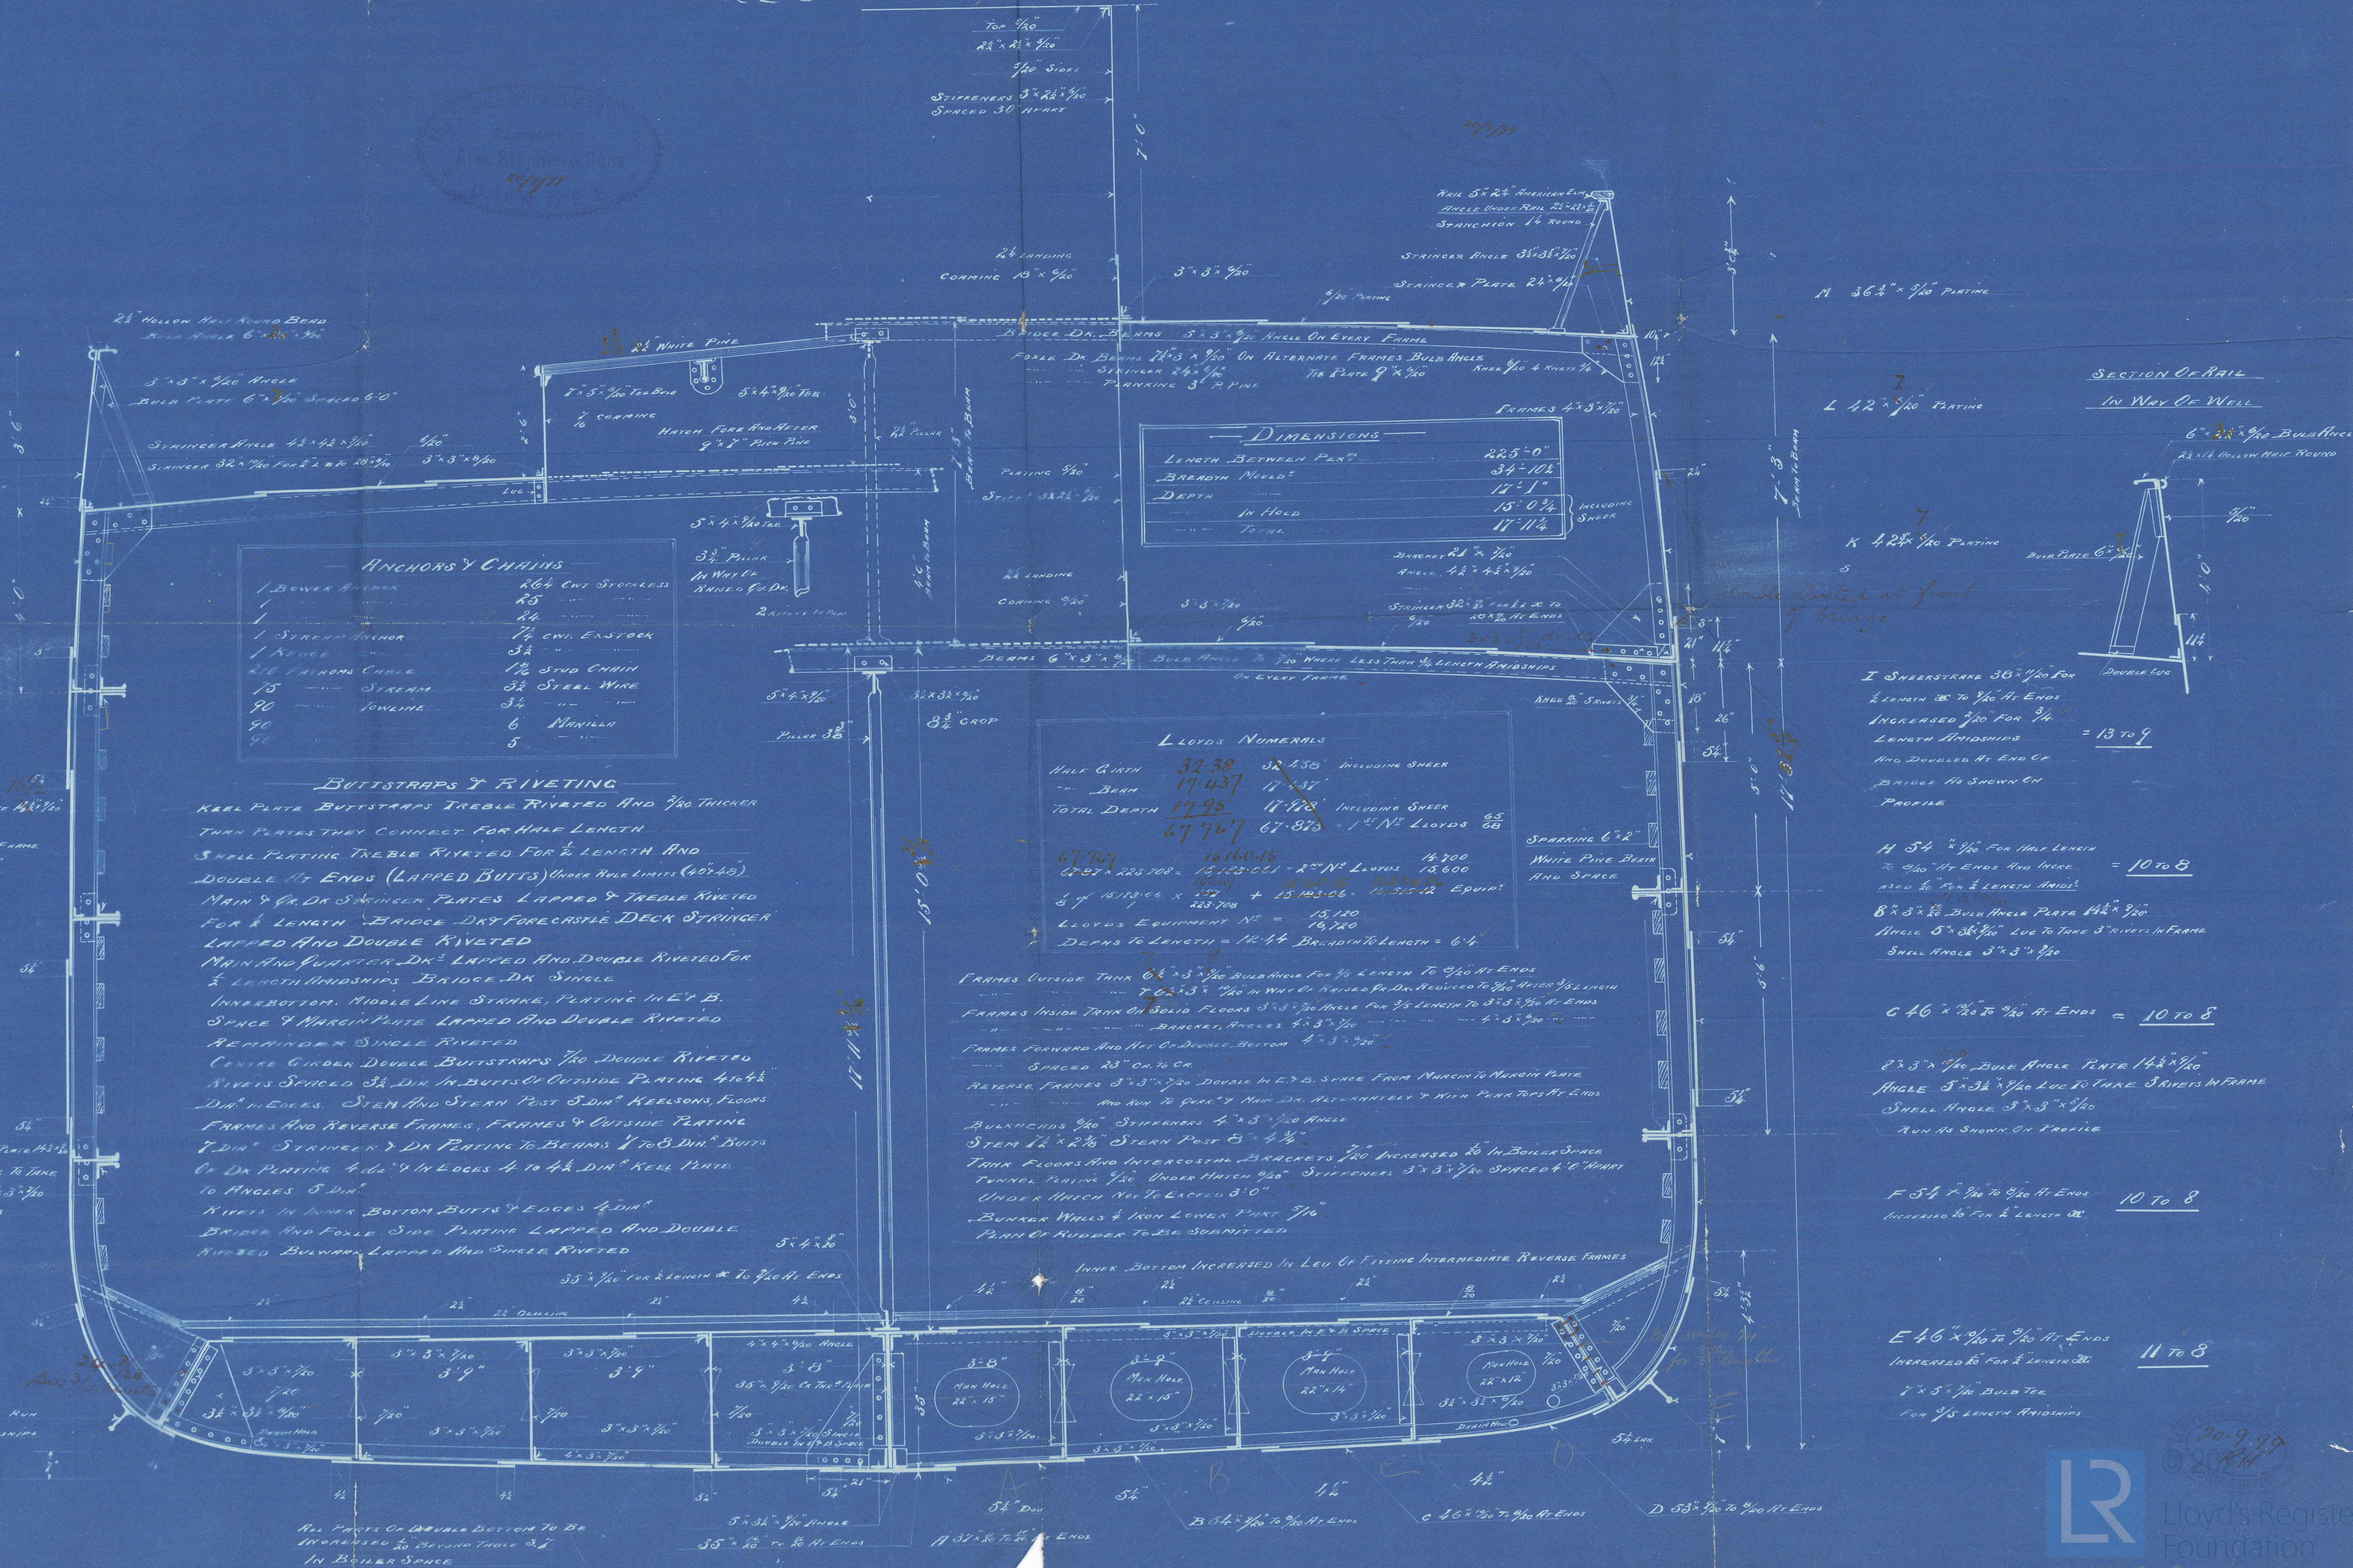
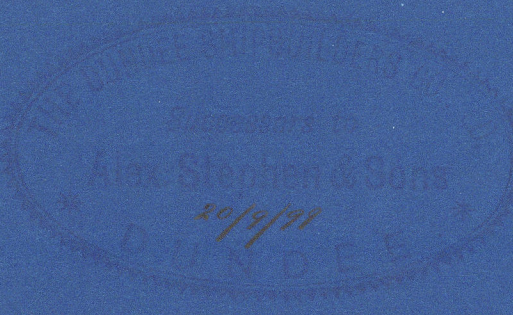


Midship Section of
The Dundee Shipbuilders Coy.

S. I. N^o 130.

S.S. "Kalfond"

Dundee Rpt N^o 6675

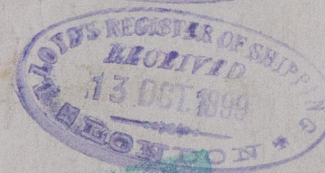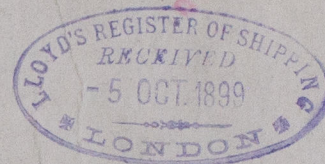

© 2021

Lloyd's Register
Foundation



W1643-0037