




app^d Amended Profile Plan

Dundee Sh. Co's

S. S. No. 135

"Lilly"
ex.
(S. S. "Kalfond")

Dep. Rpt. No. 6675

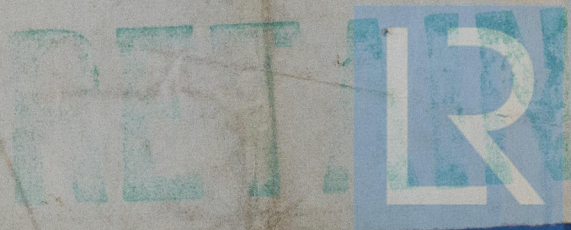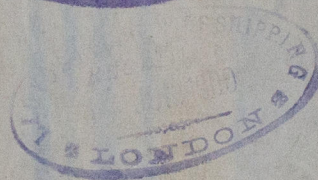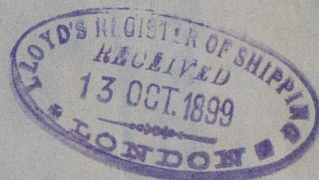

© 2021

Lloyd's Register
Foundation

8210-3494
0138