

Plan showing position  
connecting ship to water  
boat S.V. Selene.

Mod. H. and  
H. S. Selene


13.5.14

M.V. "SELENE"

SECTION A.B.


ALTERATION OF ENGINE-SEATING. (ALTERATION SHOWN IN RED.)

LOOKING IN DIRECTION OF ARROW C.

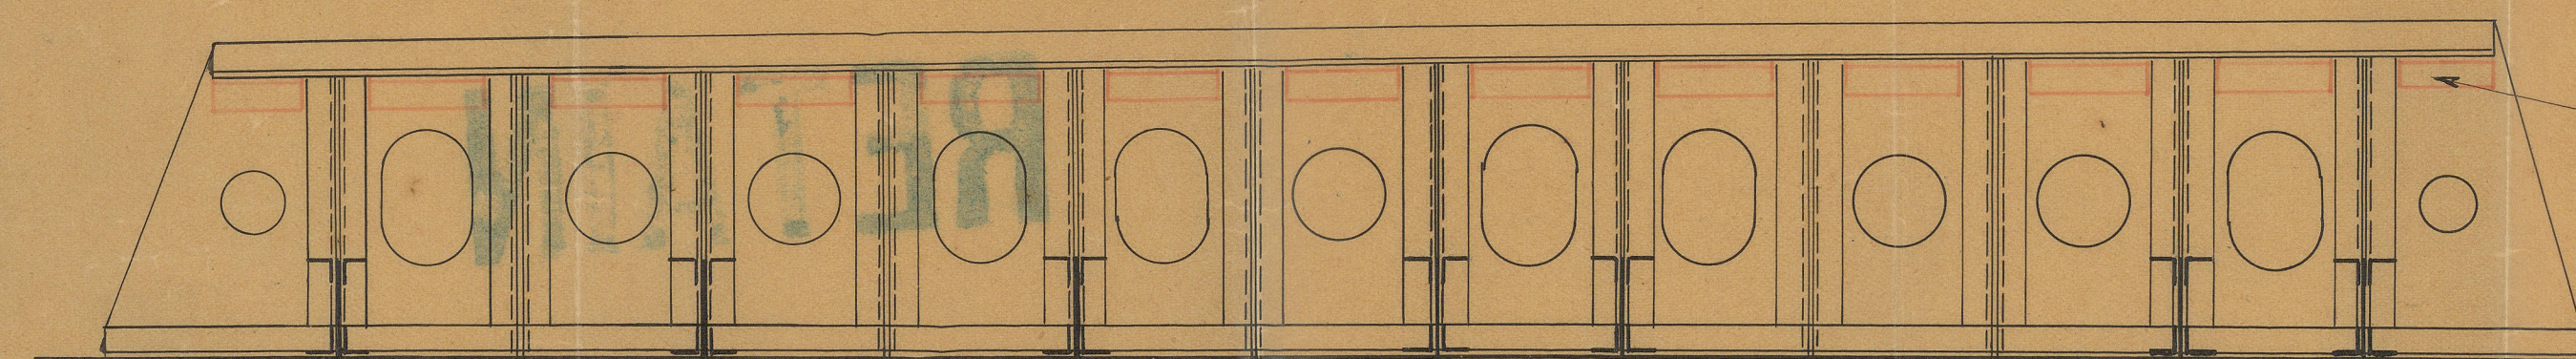


ANGLE-IRONS 4 1/2 x 4 1/2 x 3/4.

27 28 29 30 31 32 33 34 35 36

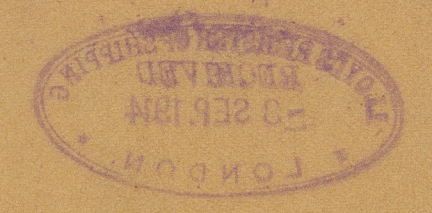

Ct.  
8.5.14  
H. S. Selene

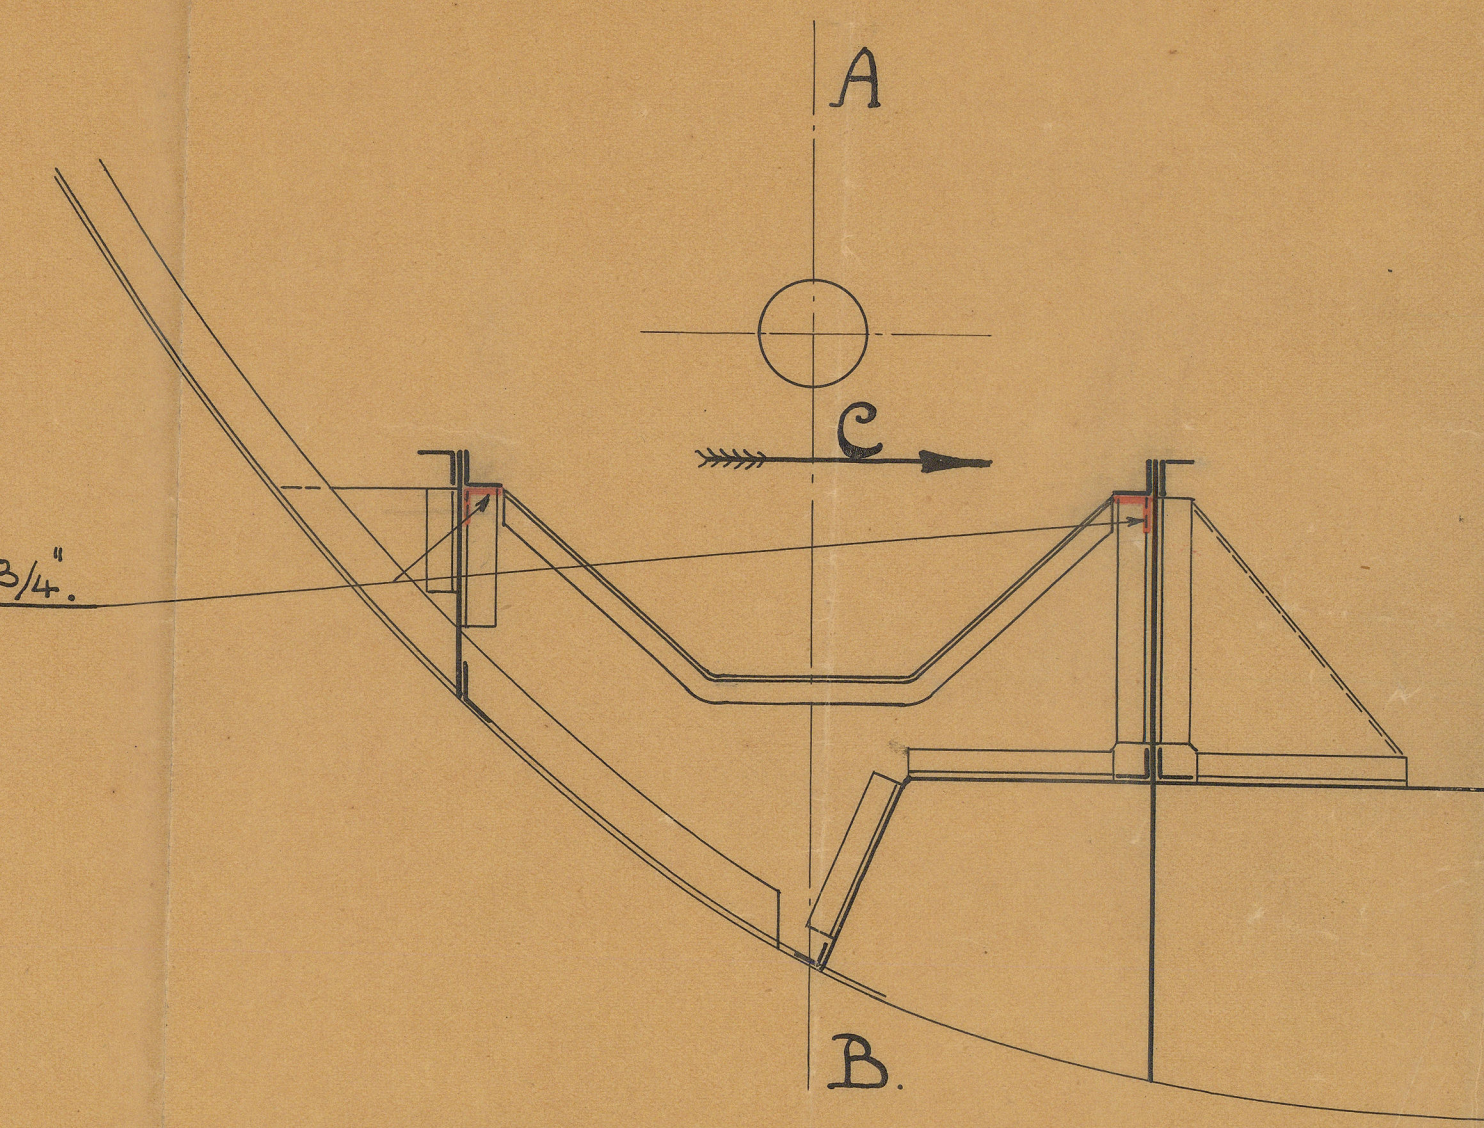




Plan showing addition  
connecting legs to motor  
seat J.S. Allen.

Ames Sept 6217  
Dunder 7818.

RETAIN

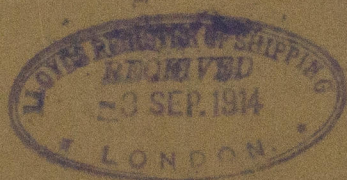

© 2020

Lloyd's Register  
Foundation

W1644 - 0121