

1432

S.S. BECKENHAM

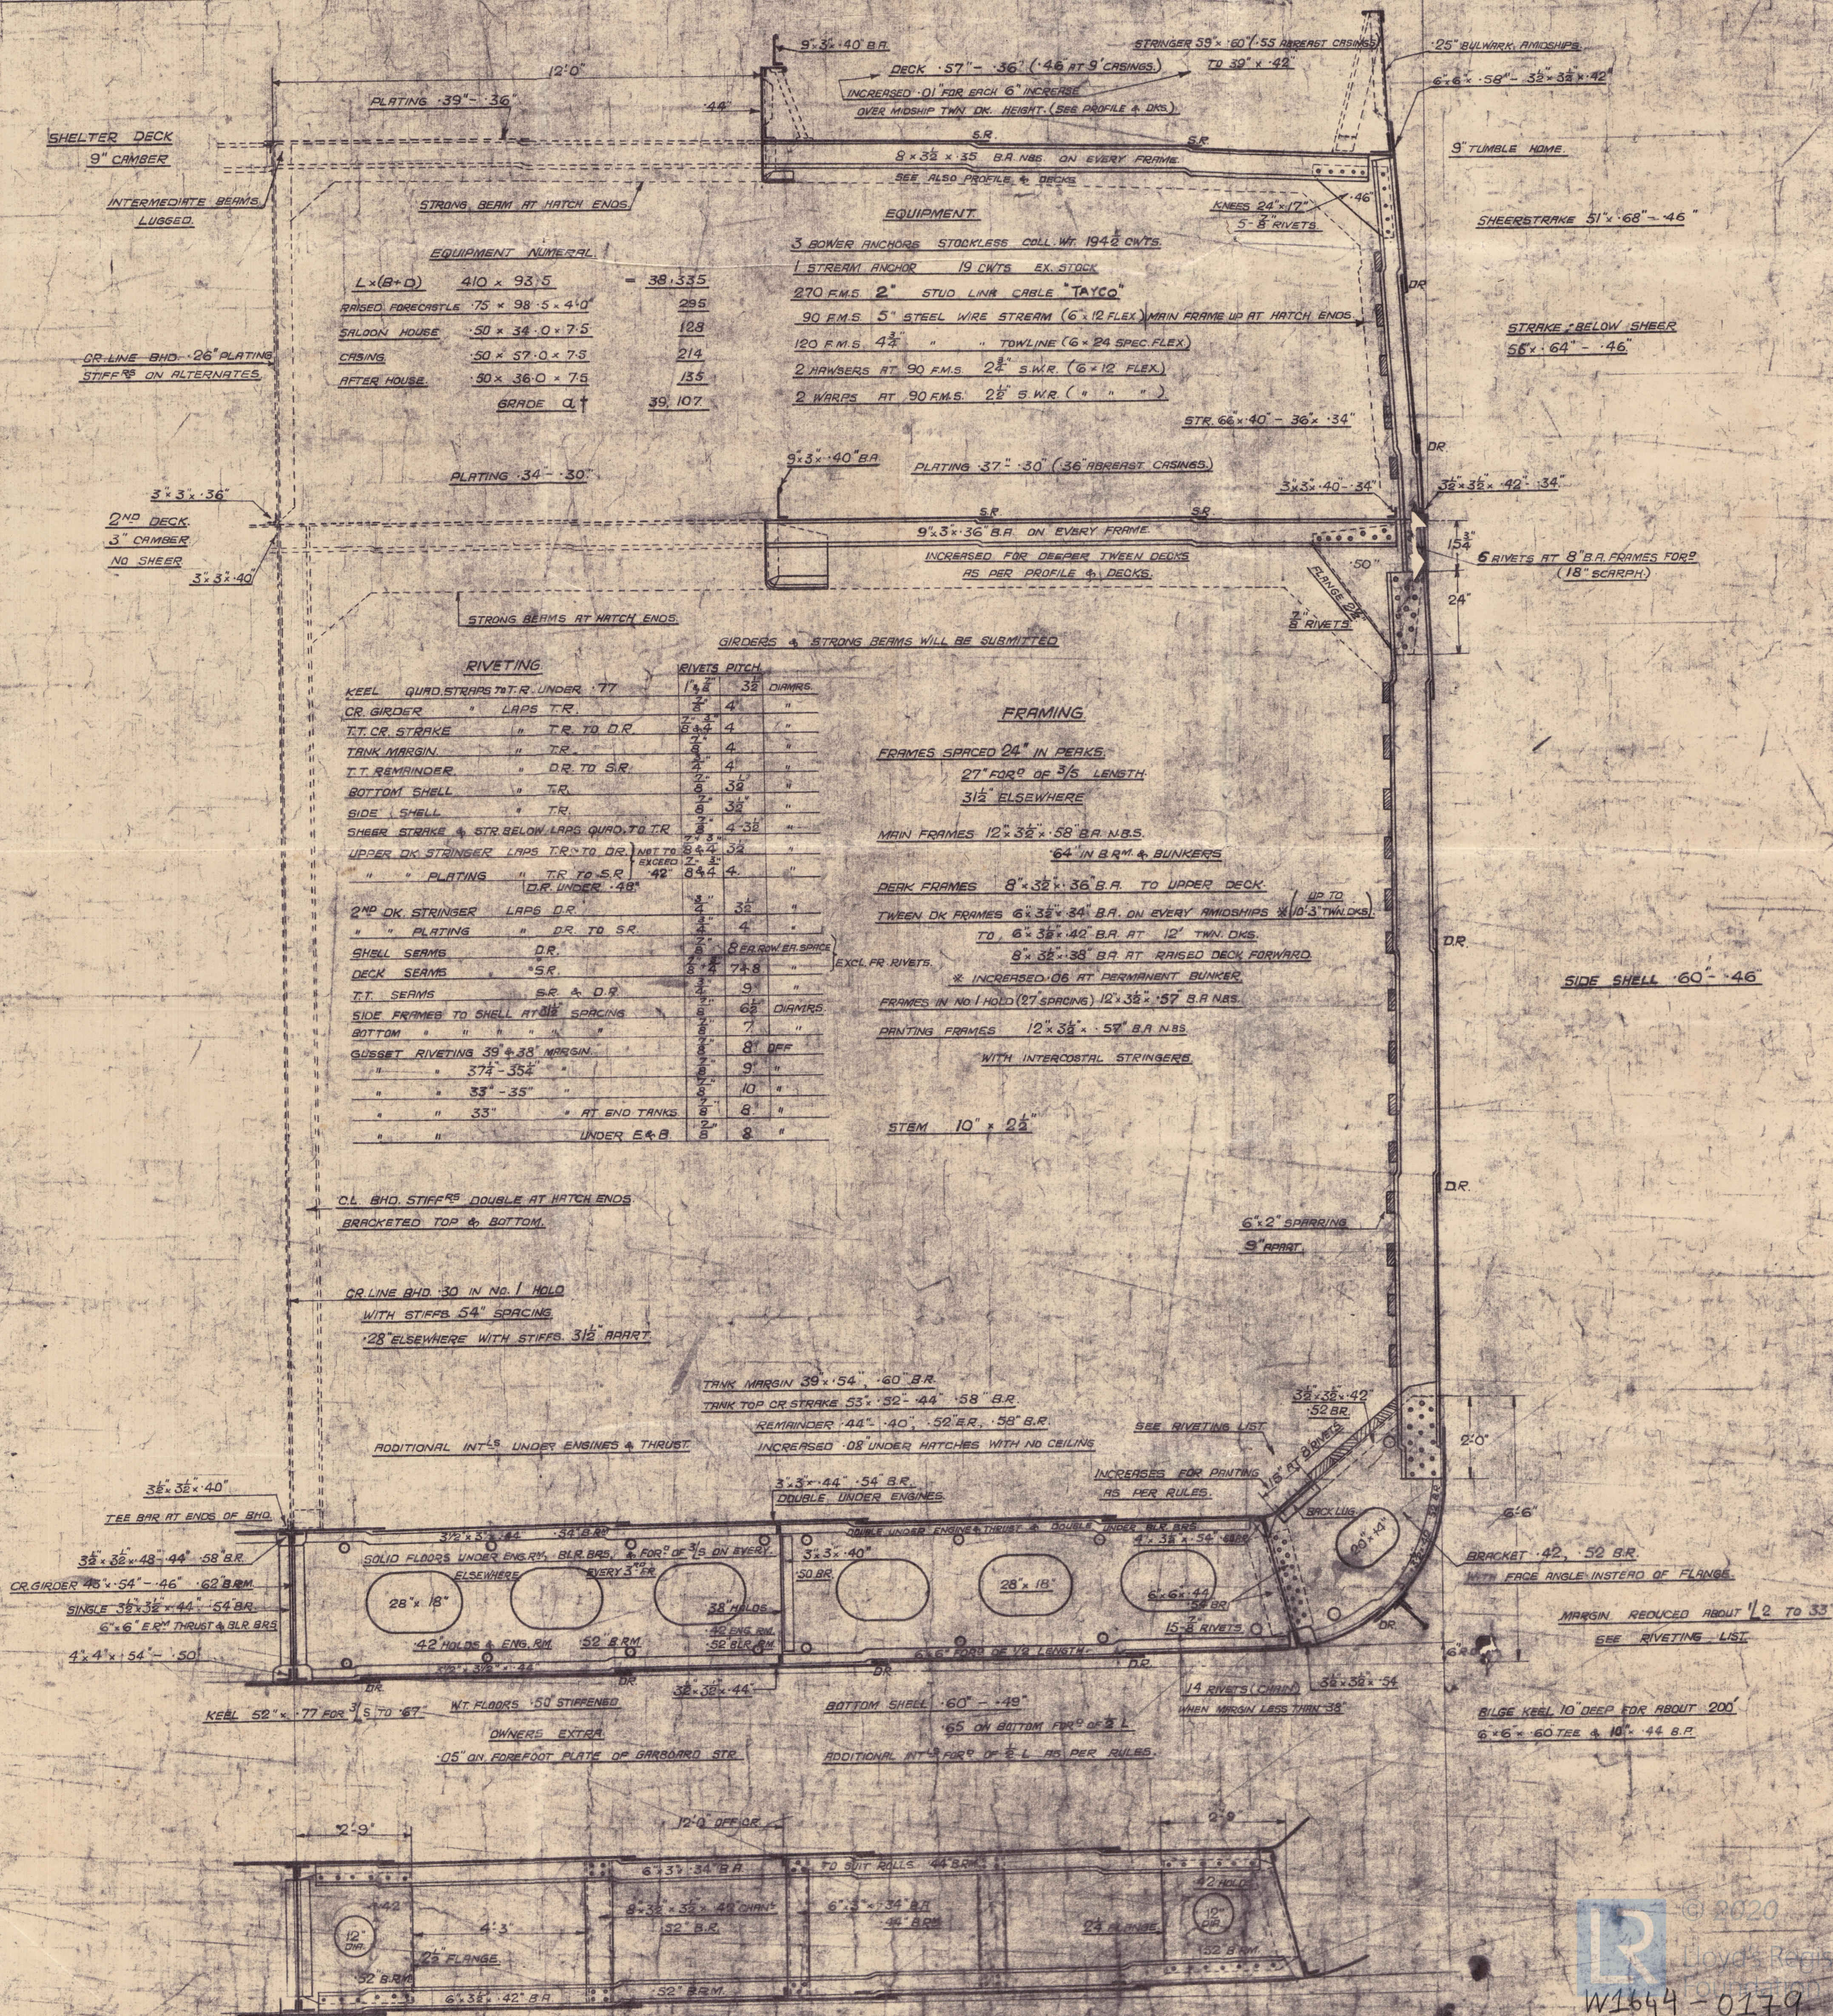
410'-0" x 56'-6" x 37'-0" SHELTER DK. 28'-0" TO 2<sup>ND</sup> DK. (LEVEL FORE & AFT.)

# MIDSHIP SECTION.

SCALE :-  $\frac{1}{2}" = \text{ONE FOOT.}$

TO CLASS LLOYDS 100 A1 "WITH FREEBOARD." (COMPLETE SUPERSTRUCTURE WITH TONNAGE OPENINGS.)

*NUMERALS.*

$$\begin{array}{rclcl} L \times D & = & 410 \times 36 & = & 14760 \\ L \times (B \times D) & = & 410 \times 92.5 & = & 37925 \\ L/D & = & 410/37 & = & 11.08 \\ "d" & & & = & 24.4 \end{array}$$




w1644-0179

S. S. 'BECKENHAM'

Midships Section (as built)

Survey Rpt no. 9004

RETAIN



© 2020

Lloyd's Register  
Foundation