



PROFILE & DECK PLANS.

S.S. N° 351.

TO CLASS B.S.*

SCALE 1/8" = 1 FOOT.

DIMS: 240'-0" B.P. x 36'-0" MLD. x 17'-0" MLD.

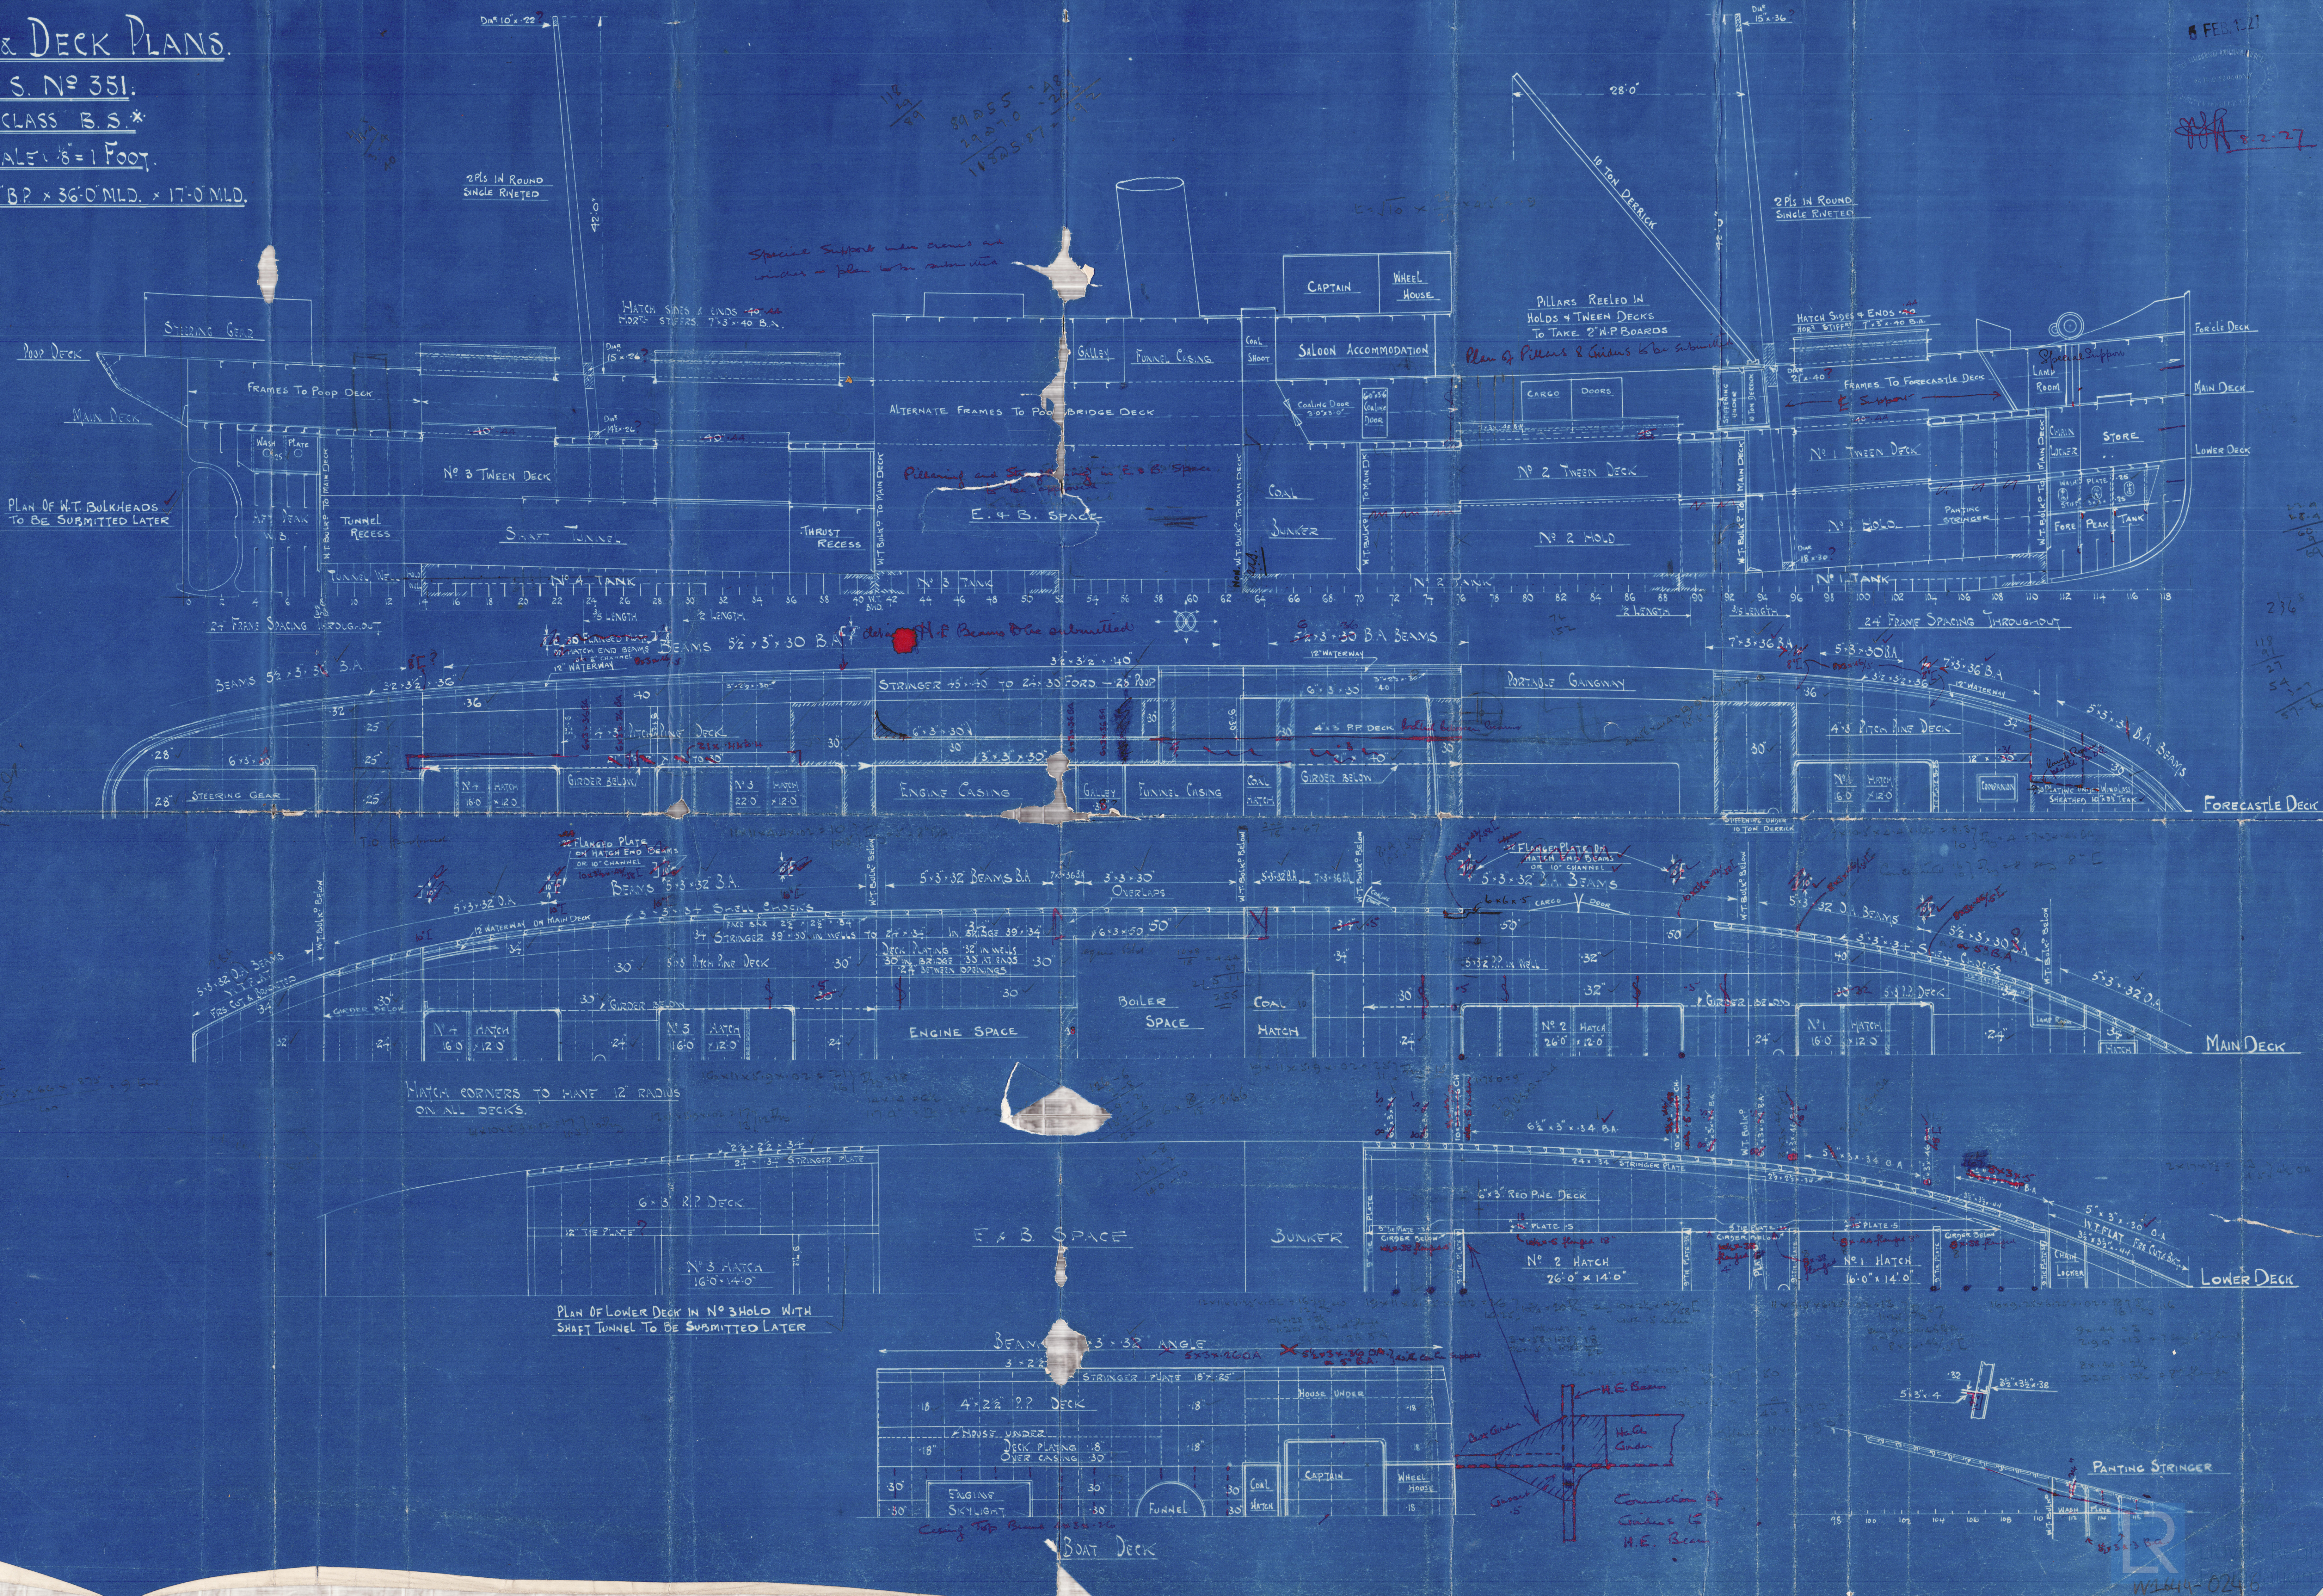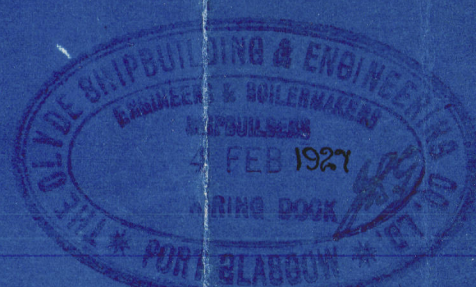


22-27

276
118
27
54
51-6

24
27
13.5 x 56
150
100

W1644-0246

2

Profile & Deck.

TRANSFERRED TO
L. R. SYSTEM

Clyde S & Co.

351.

8 - 2 - 24.

BHARATBALA EX^SIS. "North"

J. C. 23 - 2 - 24.

RETAIN



© 2020

Lloyd's Register
Foundation

W1644 - 0246